AC-001 N AC-100 F AC-102 S AD-101 F AD-102 S	COVER SHEET MOUNTING HEIGHTS FIRST FLOOR EGRESS PLAN SECOND FLOOR EGRESS PLAN	CONSTRUCTION DOCUMENTS 10-14-2016	ADDENDUM #2 11.30.2016		
AC-000 C AC-001 N AC-100 F AC-102 S AD-101 F	MOUNTING HEIGHTS FIRST FLOOR EGRESS PLAN		ADDENDUM #2 11.30.20		
AC-000 C AC-001 N AC-100 F AC-102 S AD-101 F AD-102 S	MOUNTING HEIGHTS FIRST FLOOR EGRESS PLAN		ADDENDUM #2 11.30		
AC-000 C AC-001 N AC-100 F AC-102 S AD-101 F AD-102 S	MOUNTING HEIGHTS FIRST FLOOR EGRESS PLAN		ADDENDUM #2 11		
AC-000 C AC-001 N AC-100 F AC-102 S AD-101 F AD-102 S	MOUNTING HEIGHTS FIRST FLOOR EGRESS PLAN		ADDENDUM #2		
AC-000 C AC-001 N AC-100 F AC-102 S AD-101 F AD-102 S	MOUNTING HEIGHTS FIRST FLOOR EGRESS PLAN		ADDENDUM		
AC-000 C AC-001 N AC-100 F AC-102 S AD-101 F AD-102 S	MOUNTING HEIGHTS FIRST FLOOR EGRESS PLAN		ADDEND		
	FIRST FLOOR RESTROOM DEMOLITION REFLECTED CEILING PLANS		-		
AD-202 S	SECOND FLOOR RESTROOM DEMOLITION REFLECTED CEILING PLANS	•	•		
A-101 F	FIRST FLOOR PLAN	•	•		
A-102 S	SECOND FLOOR PLAN	•	•		
	FIRST FLOOR FINISH PLAN	•	•		
A-112 S	SECOND FLOOR FINISH PLAN	•	•		
A-201 F	FIRST FLOOR REFLECTED CEILING PLAN	•	•		
A-202 S	SECOND FLOOR REFLECTED CEILING PLAN	•	•		
	NTERIOR ELEVATIONS	•	•		
		•	•		
	NTERIOR ELEVATIONS	-	-		
A-602	NTERIOR ELEVATIONS	•	•		
A-603	NTERIOR ELEVATIONS	•	•		
	NTERIOR ELEVATIONS	•	•		
		•	•		
		-			
A-910 F	FINISH SCHEDULE	•			
A-911 F	FINISH SCHEDULE	•			
MECHANICAL					
M-001	MECHANICAL SPECIFICATIONS, LEGEND, SYMBOLS & ABBREVIATIONS	•			
M-002	MECHANICAL SCHEDULES & DETAILS	•			
MD-100	MECHANICAL DEMOLITION PLANS	•			
M-100	MECHANICAL BOARDWALK LEVEL NEW WORK PLANS	•			
		•			
	MECHANICAL CONCOURSE LEVEL NEW WORK PLANS				
M-102	MECHANICAL CONCOURSE LEVEL NEW WORK PLANS	•			
PLUMBING					
P-000 F	PLUMBING LEGEND, NOTES & SCHEDULES	•			
		•			
	FIRST & SECOND FLOOR OVERALL DEMOLITION LOCATION PLANS				
PD-101 F	FIRST FLOOR RESTROOM DEMOLITION PLANS	•			
PD-102 S	SECOND FLOOR RESTROOM DEMOLITION PLANS	•			
P-100 F	FIRST & SECOND FLOOR OVERALL NEW WORK LOCATION PLANS PLUMBING	•			
	FIRST FLOOR RESTROOM NEW WORK PLANS PLUMBING	•			
	SECOND FLOOR RESTROOM NEW WORK PLANS PLUMBING	•			
P-200 F	PLUMBING DETAILS & RISER DIAGRAMS	•			
FIRE PROTECTION					
FP-000 F	FIRE PROTECTION LEGEND, NOTES & DETAILS	•			
	FIRST & SECOND FLOOR OVERALL NEW WORK LOCATION PLANS FIRE PROTECTION	•			
FP-101 F	FIRST & SECOND FLOOR RESTROOM NEW WORK PLANS FIRE PROTECTION	•			
ELECTRICAL					
E-001 E	ELECTRICAL SHEET SPECIFICATIONS	•	•		
	ELECTRICAL LEGEND & GENERAL NOTES	•	•		
		•	•		
– I D	PARTIAL ELECTRICAL FIRST FLOOR PLANS		-		
		•	•		
	PARTIAL ELECTRICAL SECOND FLOOR PLANS				
E-101 F	PARTIAL ELECTRICAL SECOND FLOOR PLANS		•	i	t

DRAWING LIST

SCALE N.T.S.

SCALE N.T.S.

6

THE SCOPE OF THIS PROJECT IS TO INCLUDE, BUT IS NOT LIMITED TO: THE DEMOLITION OF THE EXISTING RESTROOMS & REPLACEMENT OF FIXTURES, PARTITIONS, MILLWORK, FINISHES, INCLUDING PLUMBING, HEATING, & ELECTRICAL SYSTEMS. THIS PROJECT QUALIFIES AS A "RECONSTRUCTION," PER THE REHABILITATION SUBCODE. ALL WORK MUST COMPLY WITH THE AFOREMENTIONED GOVERNING CODES AS OUTLINED IN THE CODE REVIEW SECTION OF THESE CONSTRUCTION

DOCUMENTS. THESE DOCUMENTS ARE SUBJECT TO MODIFICATION AS NECESSARY TO MEET CODE REQUIREMENTS OR TO FACILITATE STRUCTURAL, MECHANICAL, PLUMBING AND ELECTRICAL INSTALLATIONS, OR INCORPORATE ARCHITECTURAL DESIGN IMPROVEMENTS.

ATLANTIC CITY BOARDWALK HALL


	RK SHALL BE PERFORMED IN STRICT ACCORDANCE WITH THE CODES OUTLINED IN THE CODE REVIEW PORTION OF THE CONSTRUCTION DOCUMENTS APPLICABLE LOCAL CODES, ORDINANCES AND REGULATIONS HAVING JURISDICTION, AS STATED IN THE CODE ANALYSIS.
	SCALE THE DRAWINGS, USE CALCULATED DIMENSIONS ONLY. SCALES INDICATED REFER TO SHEETS PRINTED AT 30"x42" (INCHES) SIZE AND ARE NO BLE TO REDUCED DRAWINGS.
ALL DIM	ENSIONS INDICATED ON THESE DRAWINGS OF EXISTING CONDITIONS ARE APPROXIMATE AND SHALL BE FIELD VERIFIED TO THE SATISFACTION OF T CTOR PRIOR TO THE WORK COMMENCING.
ACTUAL	CONTRACTOR'S RESPONSIBILITY TO FIELD CHECK ALL DIMENSIONS AND FIXTURES AND NOT TO DEVIATE FROM THESE DESIGNS AND TO DETERMINI CONSTRUCTION DETAILS AND FABRICATE IN ACCORDANCE WITH ACCEPTABLE STANDARDS OF PRACTICE AND PROCEDURES. ANY DEVIATION FROM ESIGNS SHALL BE REPORTED TO THE ARCHITECT.
FOR THE THE PRE	NTRACTOR SHALL PROVIDE PROTECTION FOR THE GENERAL PUBLIC AND CONSTRUCTION WORKERS IN AND AROUND THE CONSTRUCTION AREA, AN ADJACENT PROPERTY AND PERSONS. THE CONTRACTOR SHALL PROVIDE ADEQUATE BARRIERS TO EXERCISE CONTROL OF SAFE INGRESS AND EGRES MISES. FIRE EXITS SHALL BE MAINTAINED AT ALL TIMES, AND AT NO TIME BE BLOCKED. THE CONTRACTOR SHALL BARRICADE ALL UNSAFE OR US CONDITIONS.
THE CON ARCHITE	NTRACTOR SHALL CHECK AND VERIFY THE EXISTING CONDITIONS AT THE SITE AGAINST THE DRAWINGS AND SPECIFICATIONS, AND INFORM THE CT IMMEDIATELY OF ANY DISCREPANCIES PRIOR TO COMMENCEMENT OF WORK. CTOR SHALL LAY OUT ALL WALLS, FLOOR PENETRATIONS, ETC. FOR OWNER AND ARCHITECT TO REVIEW AND APPROVE PRIOR TO COMMENCEMENT
CONSTR WORK, A	UCTION. AT TIMES, MAY BE CONDUCTED IN A BUILDING OPERATED AND OCCUPIED BY THE OWNER AND THEIR AGENTS CONCURRENTLY. ALL DEMOLITION AN UCTION OPERATIONS WILL BE COORDINATED WITH THE OWNER PRIOR TO COMMENCEMENT. CONTRACTOR SHALL NOTIFY THE OWNER WITH A
MINIMU ALL EXIS	M FIVE (5) BUSINESS DAYS' NOTICE OF ANY DEMOLITION ACTIVITIES, UTILITY SHUT DOWNS OR DELIVERIES. TING FACILITIES, UTILITIES, AND EQUIPMENT SHALL BE PROTECTED BY THE CONTRACTOR DURING THE ENTIRE PERFORMANCE OF THE WORK. AREA
ALL EXIS DISTURE	ED OR DAMAGED BY THE CONTRACTOR SHALL BE REPAIRED AND/OR REPLACED BY THE CONTRACTOR AT NO ADDITIONAL COST TO THE OWNER. TING FACILITIES, UTILITIES, AND EQUIPMENT SHALL BE PROTECTED BY THE CONTRACTOR DURING THE ENTIRE DURATION OF THE PROJECT. AREAS ED OR DAMAGED BY THE CONTRACTOR SHALL BE REPAIRED AND/OR REPLACED BY THE CONTRACTOR AT NO ADDITIONAL COST TO THE OWNER. ITRACTOR SHALL BE RESPONSIBLE FOR RECORD KEEPING ALL EXPOSED CONDITIONS DISCOVERED DURING THE WORK AND ALL AS-BUILT CONDITION
	NTRACTOR SHALL BE RESPONSIBLE FOR THE INTEGRITY OF THE EXISTING STRUCTURE DURING THE CONSTRUCTION PERIOD AND SHALL TAKE ALL ARY MEASURES TO PREVENT ANY DAMAGE TO THE STRUCTURE, ITS OCCUPANTS AND ITS CONTENTS.
WORK, 1	ITRACTOR SHALL PROVIDE ALL NECESSARY SHORING AND BRACING TO SUPPORT CONSTRUCTION UNTIL PERMANENT SUPPORT IS ERECTED FOR THE THE CONTRACTOR SHALL TAKE ALL NECESSARY MEASURE TO PREVENT COLLAPSE OF WALLS, SLABS, ETC.
OF, AWA	AY FROM THE PREMISES. NO ON-SITE STORAGE OR BURIAL OF DEBRIS SHALL BE ALLOWED.
ALL DEC AND SH	CTORS AND THEIR SUBSEQUENT CONTRACTORS MUST PRESERVE THE INTEGRITY OF THE DESIGN WITHIN PHYSICAL CONDITIONS AND LIMITATIONS. ORATIVE MATERIALS MEETING THE REQUIREMENTS AS STATED IN THE JURISDICTIONAL CODES ARE TO BE NON-COMBUSTIBLE FOR FIRE RESISTANCE ALL COMPLY WITH ALL OTHER GOVERNING CODES AND FIRE SPECIFICATIONS AT THE LOCAL AUTHORITARIAN LEVEL AND BEYOND AS OUTLINED IN T EVIEW SECTION OF THE CONSTRUCTION DOCUMENTS.
LOCATIC	CTRICAL OUTLETS, PLUMBING FIXTURES, MECHANICAL GRILLES, ETC. SHOWN ON THE ARCHITECTURAL DRAWINGS ARE INDICATED TO SET THE GENE IN FOR EACH COMPONENT. THE CONTRACTOR SHALL REFER TO ALL DOCUMENTS, INCLUDING, BUT LIMITED TO, THE MECHANICAL, PLUMBING AND CAL DRAWINGS FOR THE COMPLETE LAYOUT OF EACH RESPECTIVE ITEM.
	/ PIPING AND ELECTRICAL CONDUITS SHALL BE CONCEALED WITHIN NEW CONSTRUCTION UNLESS OTHERWISE NOTED.
	GHOUT THE DURATION OF THE WORK, THE PLUMBING CONTRACTOR SHALL CAP EXISTING SANITARY LINES TO BE RE-UTILIZED.
NOT BE	ICATION OF SUBSTRATE AND THE CONFIGURATION OF CONCEALED ITEMS AND MATERIALS IS FOR GENERAL REFERENCE ONLY. THE CONTRACTOR SE ENTITLED TO ADDITIONAL COMPENSATION FOR ANY VARIANCE BETWEEN ACTUAL EXISTING CONDITIONS AND THAT REPRESENTED ON THE DRAWIN OT INDICATED ON A PART OF THE DRAWINGS, BUT REASONABLY IMPLIED TO BE SIMILAR TO THAT SHOWN AT CORRESPONDING PLACES, SHALL BE
MINOR	ED BY THE CONTRACTOR AT NO ADDITIONAL COST TO THE OWNER. DETAILS OR INCIDENTAL ITEMS NOT USUALLY SHOWN OR SPECIFIED, BUT NECESSARY FOR A PROPER AND COMPLETE INSTALLATION OF ANY PART O RK SHALL BE INCLUDED AS REQUIRED, AS IF THEY WERE INDICATED ON THE DRAWINGS.
ALL ITEN	1S LABELED "EXISTING" ARE EXISTING "TO REMAIN" UNLESS NOTED OTHERWISE. ITEMS NOT LABELED "EXISTING" ARE TO BE PROVIDED.
THE CON	M "PROVIDE" SHALL MEAN FURNISH AND INSTALL, AS IT IS USED THROUGHOUT THE NOTES ON THE DRAWINGS AND IN THE SPECIFICATIONS. ITRACTOR SHALL PROVIDE SEALANT JOINTS BETWEEN ALL DISSIMILAR BUILDING MATERIALS, UNLESS OTHERWISE NOTED. REFER TO SPECIFICATION EDULE OF SEALANTS.
	AND SECTIONS ON THE DRAWINGS ARE SHOWN AT SPECIFIC LOCATIONS, AND ARE INTENDED TO SHOW GENERAL REQUIREMENTS THROUGHOUT. NOTED AS "TYPICAL" IMPLY ALL SIMILAR CONDITIONS ARE TO BE TREATED AS SUCH.
	-RATED CONSTRUCTION SHALL MEET THE FIRE-RESISTIVE RATINGS AND OTHER REQUIREMENTS OF LOCAL LAWS, ORDINANCES, REGULATIONS AND ITIES HAVING JURISDICTION AS OUTLINED IN THE CODE REVIEW SECTION OF THE CONSTRUCTION DOCUMENTS.
CONSTR FIRE ALA	ETRATIONS THROUGH FIRE-RATED CONSTRUCTION SHALL RECEIVE FIRE STOPPING, FIRE DAMPERS, FIRE SAFEING, ETC. TO MAINTAIN THE FIRE-RATE UCTION. SUCH PENETRATIONS SHALL INCLUDE, BUT NOT BE LIMITED TO, TELEPHONE, DATA, LIGHT FIXTURES, JUNCTION BOXES, DUPLEX RECEPTAC RM SYSTEMS, ROOM ACCESSORIES, ETC THE RATING MUST CONTINUE AROUND AND BEHIND THE PENETRATION SO AS TO INSURE THE INTEGRITY SSEMBLY.
THE DO	SURFACE DOOR CLOSURE ARE REQUIRED, THE CONTRACTOR SHALL ALLOW A MINIMUM OF SIX INCHES CLEAR TO ANY PARTITION ON THE HINGE SIE DR, UNLESS OTHERWISE INDICATED.
	ITS ARE TO MEET CLASS 'A' FIRE RATING OVER NON-COMBUSTIBLE SURFACES. PAINTS ARE TO CONFORM TO ALL ENVIRONMENTAL CODES. UIRED FIRE TREATED MATERIALS SHALL COMPLY WITH ALL GOVERNING CODES AND FIRE SPECIFICATIONS AT THE LOCAL AUTHORITARIAN LEVEL AN
BEYOND	AS OUTLINED IN THE CODE REVIEW SECTION OF THE CONSTRUCTION DOCUMENTS.
AUTHOF	ITARIAN LEVEL AND BEYOND AS OUTLINED IN THE CODE REVIEW SECTION OF THE CONSTRUCTION DOCUMENTS.
	INATED SURFACES SHALL MEET STANDARDS CLASS I, 0-25 FLAME SPREAD AND SMOKE DEVELOPED (PER ASTM AND UL TUNNEL TEST METHOD). COUSTICAL TILES TO MEET FLAME SPREAD 0-25 (ASTM E84) CLASS 'A' (FED. SPEC. SS-S118B) 25 OR UNDER (UL LABEL).
PROVID	WALL COVERINGS THAT BEAR THE UL LABEL, INDICATING THE FOLLOWING FIRE PERFORMANCE CHARACTERISTICS WHEN TESTED IN ACCORDANCE
ALL CAR	TM E84: FLAME SPREAD, CLASS 1 (A) 0-25, SMOKE DEVELOPED NOT MORE THAN 450 PET TO MEET FLAMMABILITY REQUIREMENTS OF ASTM E648 (NFPA-253 RADIANT PANEL TEST (CLASS 11, 75 OR LESS). CLASS 1, 45 WATTS PER CM2. ASS DOC-FE-I-70 PILL TEST. SMOKE DEVELOPMENT RATING SHALL BE LESS THAN 540 IN CONFORMANCE TO ASTM E84
SHALL C	MIXTURES SHALL CONFORM TO THE REQUIREMENTS OF CODES AS OUTLINED IN THE CODE REVIEW SECTION OF THE CONSTRUCTION DOCUMENTS A ONFORM TO ASTM C476. R MIXTURES SHALL CONFORM TO THE REQUIREMENTS OF CODES AS OUTLINED IN THE CODE REVIEW SECTION OF THE CONSTRUCTION DOCUMENTS
SHOP DI	ALL CONFORM TO ASTM STANDARDS. RAWINGS REQUIRED; IF NOT RECEIVED, SUBSEQUENT CONTRACTOR WILL ASSUME TOTAL RESPONSIBILITY FOR ITEMS' SIZE, PROPER FIT, MATERIALS
TEN (10)	E COMPLIANCES. WORKING DAYS ARE REQUIRED BY THE ARCHITECT FOR SHOP DRAWING REVIEW. TEN (10) WORKING DAYS ARE REQUIRED FOR ELECTRICAL, NCAL, PLUMBING, ETC., ENGINEERING REVIEW.
FIXTURE SHAFT V	ON MILLWORKER, CONTRACTOR AND OR SUBSEQUENT CONTRACTORS: ANY PENETRATIONS INTO RATED WALL SYSTEMS FOR TELEPHONE, DATA, LI S, JUNCTION BOXES, DUPLEX RECEPTACLES, FIRE ALARM SYSTEMS OR OTHER ROOM ACCESSORIES MUST HAVE A FIRE-RATED GYPSUM WALL BOARD /ALL ENCLOSURE PER ALL APPLICABLE CODES. THE RATING MUST CONTINUE AROUND AND BEHIND COMPLETE PENETRATION SO AS TO INSURE THE TY OF THE RATED ASSEMBLY.
INFORM	GS AND SECTIONS OF TRIM AND MOULDING DETAILS ARE FOR DESIGN AND LAYOUT PURPOSES BASED ON ACTUAL TRIM AND BEST AVAILABLE ATION. THEY ARE NOT INTENDED TO ACT OR TAKE PLACE OF WORKING SHOP DRAWINGS FROM A MILLWORK CONTRACTOR. ITRACTOR SHALL BE RESPONSIBLE FOR RECORD KEEPING ALL EXPOSED CONDITIONS DISCOVERED DURING THE WORK AND ALL AS-BUILT CONDITION
THE CO	NTRACTOR SHALL CHECK AND VERIFY THE EXISTING CONDITIONS AT THE SITE AGAINST THE DRAWINGS AND SPECIFICATIONS, AND INFORM THE SITE IMMEDIATELY OF ANY DISCREPANCIES PRIOR TO COMMENCEMENT OF WORK.
	ONTRACTOR FINDS CONFLICTS BETWEEN THE DRAWINGS AND THE SPECIFICATIONS OR BETWEEN TRADES THE MORE STRINGENT WILL PREVAIL.


2301BOARDWALK ATLANTIC CITY, NJ 08401 **RESTROOM RENOVATION**

THIS BUILDING IS LISTED IN THE NATIONAL REGISTER OF HISTORIC PLACES, AND ALL WORK MUST COMPLY WITH THE SECRETARY OF THE INTERIOR'S STANDARDS FOR THE TREATMENT OF HISTORIC PROPERTIES.

TERNATIONAL BUILDING CODE - NEW JERSEY EDITION Introduction TIONAL STANDARD PLUMBING CODE Introduction TIONAL ELECTRICAL CODE 90.1- TERNATIONAL MECHANICAL CODE Intrenviol TERNATIONAL FUEL GAS CODE Intrenviol TERNATIONAL FUEL GAS CODE Intrenviol TERNATIONAL FUEL GAS CODE NJAC 5 CANSI A117.1- TIONAL FIRE PROTECTION ASSOCIATION Intrenviol Selection Interviol	INTERNATIONAL BUILDING CODE - NEW JERSEY EDITION INTERNATIONAL STANDARD PLUMBING CODE NATIONAL STANDARD PLUMBING CODE NATIONAL ELECTRICAL CODE ASHRAE 90 INTERNATIONAL ELECTRICAL CODE INTERNATIONAL MECHANICAL CODE INTERNATIONAL MECHANICAL CODE INTERNATIONAL FUEL GAS CODE INTERNATIONAL FUEL GAS CODE INTERNATIONAL ENERGY CONSERVATION CODE BARRIER-FREE SUBCODE NATIONAL FIRE PROTECTION ASSOCIATION 10 11 11 11 11 11 11 11 11 11 11 11 11	CODE - NEW JERSEY EDITION 2 BING CODE 2 DE 90.1-2 AL CODE 2 CODE 2 CODE 2 DNSERVATION CODE 3 NJAC 5: A117.1-2 N ASSOCIATION 3 NED BY CHAPTER 5.23-6 "REHABILITATION SUBCODE" OF THE UNIFORM OF NEW JERSEY, QUALIFIES AS A RECONSTRUCTION. THE WORK IN TH OUTTOON OF EXTERIOR WALLS, INTERIOR WALLS, FLOORS, CELLINGS, TWORK & PLUMBING. NETTERIOR WALLS, INTERIOR WALLS, FLOORS, CELLINGS, TWORK & PLUMBING. 2 NEY	
TIONAL STANDARD PLUMBING CODE TIONAL ELECTRICAL CODE TIONAL ELECTRICAL CODE TRENATIONAL MECHANICAL CODE TERNATIONAL MECHANICAL CODE TERNATIONAL FUEL GAS CODE TERNATIONAL ENERGY CONSERVATION CODE RRIER-FREE SUBCODE SUANSI A117.1 TIONAL FIRE PROTECTION ASSOCIATION TIONAL STATE OF NEW JERSEY, QUALIFIES AS A RECONSTRUCTION OF WILLS, PROVENCE ALLINES, ONE AND ENCOMPACE ALLINES, ONE AND ENCLOSES THE SELECTIVE DEMOLITION OF EXTERIOR WALLS, PROVENCE ALLINES, ONE AND ENCLOSES AREA OF THE UNRY, THE WORK INTERIOR WALLS, PROVENCE ALLINES, ONE AND ENCLOSES AREA OF WORK TAL GROSS AREA OF WORK CCUPANT LOAD F. INTERNATIONAL BUILDING CODE - NEW JERSEY EDITION TO CCUPANT LOAD TIC RESISTANCE RATING REQUIREMENTS F. INTERNATIONAL BUILDING CODE - NEW JERSEY EDITION TINTERIOR F. INTERNATIONAL BUILDING CODE - NEW JERSEY EDITION TINTERIOR F. INTERNATIONAL BUILDING CODE - NEW JERSEY EDITION TINTERIOR F. INTERNATIONAL BUILDING CODE - NEW JERSEY EDITION TINTERIOR F. INTERNATIONAL BUILDING CODE - NEW JERSEY EDITION TINTERIOR F. INTERNATIONAL BUILDING CODE - NEW JERSEY EDITION TINTERIOR F. INTERNATIONAL BUILDING CODE - NEW JERSEY EDITION TINTERIOR F. INTERNATIONAL BUILDING CODE - NEW JERSEY EDITION TINTERIOR F. INTERNATIONAL BUILDING CODE - NEW JERSEY EDITION TINTERIOR F. INTERNATIONAL BUILDING CODE - NEW JERSEY EDITION TINTERIOR F. INTERNATIONAL BUILDING CODE - NEW JERSEY EDITION TINTERIOR TION & SECONDARY MEMBERS TINTERIOR TINTERIOR TINTERIOR TINTERIOR TIONS TITENCOL SUPPORTS TINTERIOR TINTERIOR TINTERIOR TINTERIOR TINTERIOR TIN	NATIONAL STANDARD PLUMBING CODE International Electrical CODE NATIONAL ELECTRICAL CODE 90 INTERNATIONAL MECHANICAL CODE 91 INTERNATIONAL MECHANICAL CODE 91 INTERNATIONAL FUEL GAS CODE 91 INTERNATIONAL ENERGY CONSERVATION CODE 91 BARRIER-FREE SUBCODE NJA4 ICC/ANSI A117 NATIONAL FIRE PROTECTION ASSOCIATION 91 THE WORK IN THIS PROJECT, AS DEFINED BY CHAPTER 5.23-6 TREHABILITATION SUBCODE' OF THE UNE CONSTRUCTION CODE OF THE STATE OR NEW JERSEY, QUALIES AS A RECONSURCITON THE WORK IN PHASE INCLUDES THE SELECTIVE DEMOLITION OF EXTERIOR WALLS, INTERIOR WALLS, FLOOPS, CELLING FINISHES, ECUPMENT, FIXTURES, DUCTWORK & PLUMBING. BUILDING SUMMARY 91 USE GROUP 91 CONSTRUCTION TYPE 95 SPRINKLERS 91 FIRST FLOOR AREA OF WORK 11 SECOND FLOOR AREA OF WORK 11 SECOND FLOOR AREA OF WORK 11 OCCUPANT LOAD 90 REF - INTERNATIONAL BUILDING CODE - NEW JERSEY EDITION 2015 601 PRIMARY STRUCTURAL FRAME 2 HR BEARING WALLS EXTERIOR INTERIOR 24 HR BEARING WALLS EXTERIOR INTERIOR 2 HR	BING CODE 2 DE 2 QUE 90.1-2 AL CODE 2 CODE 2 DNSERVATION CODE 2 DNSERVATION CODE 2 NASSOCIATION 2 VED BY CHAPTER 5.23.6 "REHABILITATION SUBCODE" OF THE UNIFORM DP NEW JERSEY, QUALIFIES AS ARECONSTRUCTION THE WORK IN TH OUTTOON OF EXTERIOR WALLS, INTERIOR WALLS, FLOORS, CEILINGS, TWORK & PLUMBING. ARY 2 RK 1,600 /ORK 1,850 RK 3,460 O 2015 TAE 1004.1 OCCUPAT 3,460 MORE INFORMATION 2015 TAE 601 & 601 MRE CODE - NEW JERSEY EDITION 2015 TAE 601 & 601 MG CODE - NEW JERSEY EDITION 2015 TAE 601 & 601 MORE INFORMATION 2 EXTERIOR 2 ING CODE - NEW JERSEY EDITION 2 ING CODE - NEW JERSEY EDITION 2 ING CODE - NEW JERSEY EDITION 2 INTERIOR 2 INTERIOR 2 EXTERIOR 2 INTER	
TIONAL ELECTRICAL CODE TERNATIONAL ELECTRICAL CODE TERNATIONAL MECHANICAL CODE TERNATIONAL FUEL GAS CODE TERNATIONAL FUEL GAS CODE TERNATIONAL ENERGY CONSERVATION CODE RRIER-FREE SUBCODE NJAC 5 Z/ANSI A117.1- TIONAL FIRE PROTECTION ASSOCIATION TIONAL FIRE PROTECTION OF EXTERIOR WALLS, INTERIOR WALLS, FLOOPES, CEILINGS, BIESE, EQUIPMENT, FLOTURES DUMOTION OF EXTERIOR WALLS, INTERIOR WALLS, FLOOPES, CEILINGS, BIESE, EQUIPMENT, FLOTURES DUMONG & EXTERIOR WALLS, INTERIOR WALLS, FLOOPES, CEILINGS, BIESE, EQUIPMENT, FLOTURES DUMONG & EXTERIOR WALLS, INTERIOR WALLS, FLOOPES, CEILINGS, BIESE, EQUIPMENT, FLOTURES DUMONG & EXTERIOR WALLS, INTERIOR WALLS, FLOOPES, CEILINGS, BIESE, EQUIPMENT, FLOTURES DUMONG & EXTERIOR WALLS, INTERIOR WALLS, FLOOPES, CEILINGS, BIESE, EQUIPMENT, FLOTURE DUMONG & EXTERIOR WALLS, INTERIOR WALLS, FLOOPES, CEILINGS, BIESE, EQUIPMENT, FLOTURES DUMONG & EXTERIOR TIAL GROSS AREA OF WORK TIAL GROSS AREA OF WORK TIAL GROSS AREA OF WORK CCUPANT LOAD F- INTERNATIONAL BUILDING CODE - NEW JERSEY EDITION CCCUPA TAL GROSS AREA OF WORK CCUPANT LOAD F- INTERNATIONAL BUILDING CODE - NEW JERSEY EDITION CCCUPA TAL GROSS PLANS FOR MORE INFORMATION RE RESISTANCE RATING REQUIREMENTS F- INTERNATIONAL BUILDING CODE - NEW JERSEY EDITION COCCUPA ARING WALLS & PARTITIONS FX = XYERIOR INTERIOR 2 HR ARING WALLS & PARTITIONS FX = SECONDARY MEMBERS THRE COOR CONSTRUCTION & SECONDARY MEMBERS THRE F- INTERNATIONAL BUILDING CODE - NEW JERSEY EDITION TITERIOR 2 HR ARING WALLS & PARTITIONS FY = SECONDARY MEMBERS THRE F- INTERNATIONAL & CEILING FINISH REQUIREMENT F- INTERNATIONAL & CEILING FINISH REQUIREMENT F- INTERNATIONAL BUILDING CODE - NEW JERSEY EDITION TITERIOR THRE TO EOR STRUCTION & SECONDARY MEMBERS THRE F- INTERNATIONAL BUILDING CODE - NEW JERSEY EDITION TITERIOR THRE TOR TABLE AND EXIT PASSAGEWAYS CLA NORF AND ENCLOSED SPACES CLA NORS AND ENCLOSED SPACES CLA	NATIONAL ELECTRICAL CODE 90 ASHRAE 90 INTERNATIONAL MECHANICAL CODE 90 INTERNATIONAL FUEL GAS CODE 1 INTERNATIONAL ENERGY CONSERVATION CODE 8 BARRIER-FREE SUBCODE NJAI ICC/ANSI A117 NATIONAL FIRE PROTECTION ASSOCIATION 4 THE WORK IN THIS PROJECT, AS DEFINED BY CHAPTER 5236 "REHABILITATION SUBCODE" OF THE UNFOONSTRUCTION CODE OF THE STATE OF NEW JERSEY, QUALIFIES AS A RECONSTRUCTION. THE WORK IN FINISHES, EQUIPMENT, FIXTURES, DUCTWORK & PLUMBING. BUILDING SUMIMARY USE GROUP 0 CONSTRUCTION TYPE SPRINKLERS 1 FIRST FLOOR AREA OF WORK 1 SOCCUPANT LOAD OCCU AREA OF WORK 1 OCCU AREA OF WORK SPRINKLERS FIRE F - INTERNATIONAL BUILDING CODE - NEW JERSEY EDITION OCCU AREA OF WORK OCCU OCCU AREA OF WORK OCCU OCCU AREA OF WORK OCCU AREA OF WORK SPRINE FOR MORE INFORMATION	DE 90.1 AL CODE 90.1 CODE 90.1 DNSERVATION CODE 90.1 DNSERVATION CODE 90.1 NJAC 5: A117.1 N ASSOCIATION 1 VED BY CHAPTER 5.23-6 "REHABILITATION SUBCODE" OF THE UNIFORM OF NEW JERSEY, QUALIFIES AS A RECONSTRUCTION. THE WORK IN TH OUTTOON OF EXTERIOR WALLS, INTERIOR WALLS, FLOORS, CEILINGS, TWORK & PLUMBING. NRY	
HRAE 90.1- TERNATIONAL MECHANICAL CODE Image: Construction Code TERNATIONAL FUEL GAS CODE Image: Construction Code TERNATIONAL ENERGY CONSERVATION CODE Image: Construction Code RRIER-FREE SUBCODE NJAC 5 CANSI A117.1- TIONAL FIRE PROTECTION ASSOCIATION Image: Construction Subcode: OF THE UNFORM EWORK IN THIS PROJECT, AS DEFINED BY CHAPTER 5.28.4 "RECONSTRUCTION THE WORK NT Image: Construction Code of THE UNFORM EWORK IN THIS PROJECT, AS DEFINED BY CHAPTER 5.29.6 "REHABILITATION SUBCODE: OF THE UNFORM Image: Construction Code of THE UNFORM EWORK IN THIS PROJECT, AS DEFINED BY CHAPTER 5.29.6 "REHABILITATION SUBCODE: OF THE UNFORM Image: Construction Code of THE UNFORM EWORK IN THIS PROJECT, AS DEFINED BY CHAPTER 5.29.6 "REHABILITATION SUBCODE: OF THE UNFORM Image: Construction Code of THE UNFORM IDDIDIOS SUMMARY E GROUP Image: Construction TYPE RINKLERS Image: Construction TYPE Image: Construction Code of THE UNFORMATION CCCUPANT LOAD 2015 TAI 0004.1 COCUPA F - INTERNATIONAL BUILDING CODE - NEW JERSEY EDITION 2015 TAI 0014.0 IMARY STRUCTURAL FRAME 2 HR ARING WALLS PARTITIONS EXTERIOR 2 HR INTERIOR WALLS & PARTITIONS X > 30 = INTERIOR WALLS & PARTITIONS X > 30 =	ASHRAE 990 INTERNATIONAL MECHANICAL CODE 900 INTERNATIONAL FUEL GAS CODE 100 INTERNATIONAL FUEL GAS CODE 100 INTERNATIONAL FUEL GAS CODE 100 BARRIER-FREE SUBCODE 100 CC/ANSI 110 A117 NATIONAL FIRE PROTECTION ASSOCIATION 100 THE WORK IN THIS PROJECT, AS DEFINED BY CHAPTER 5.23.6 "REHABILITATION SUBCODE" OF THE UNIF CONSTRUCTION CODE OF THE STATE OF NEW JERSEY, QUALIFIES AS A RECONSTRUCTION. THE WORK I PHASE INCLUEDS THE SELECTIVE DEMOLITION OF FXTEMOR WALLS, FLOOR OF THE UNIF CONSTRUCTION CODE OF THE STATE OF NEW JERSEY, QUALIFIES AS A RECONSTRUCTION. THE WORK I FINISHES. EQUIPMENT, FXTURES, DUCTWORK & PLUMBING. BUILDING SUMMARY USE GROUP CONSTRUCTION TYPE 50 SPRINKLERS 100 FIRST FLOOR AREA OF WORK 11 SECOND FLOOR AREA OF WORK 12 TOTAL GROSS AREA OF WORK 12 REF - INTERNATIONAL BUILDING CODE - NEW JERSEY EDITION 2015 100 COCCU AREA OF WORK 3.460 NOTE: REFER TO EGRESS PLANS FOR MORE INFORMATION FIRE RESISTANCE RATING REQUIREMENTS REF - INTERNATIONAL BUILDING CODE - NEW JERSEY EDITION 2015 601 PRIMARY STRUCTURAL FRAME 2 HR BEARING WALLS 4 PARTITIONS 21HR NON BEARING WALLS & PARTITIONS 21HR NON BEARING WALLS & PARTITIONS 21HR NON BEARING WALLS & PARTITIONS 21HR EXTERIOR 21HR NON BEARING WALLS & PARTITIONS 21HR AND 400 ATTERNATIONAL BUILDING CODE - NEW JERSEY EDITION 21HR AND 400 AREA OF WORK 32 A PARTITIONS 42 A PARTITIONS	90.1-2 AL CODE CODE DNSERVATION CODE DISERVATION CODE A117.1-2 N ASSOCIATION NASSOCIATION NASSOCIATION NASSOCIATION A117.1-2 N ASSOCIATION NASSOCIATION RK 10004.1 1007 NG CODE - NEW JERSEY EDITION 1004.1 0CCUPAI 3,460 MORE INFORMATION RATING REQUIREMENTS ING CODE - NEW JERSEY EDITION 2015 TAE 601 & 600 ME 2 HR EXTER	
TERNATIONAL MECHANICAL CODE Image: Conservation Code TERNATIONAL FUEL GAS CODE Image: Conservation Code TERNATIONAL ENERGY CONSERVATION CODE NUAC 5 ZANSI A117.1- TIONAL FIRE PROTECTION ASSOCIATION Image: Conservation Subcode of the Uniform Work in THIS PROJECT AS DEFINED BY CHAPTER 5.24 "REHABILITATION SUBCODE of the Uniform A117.1- TIONAL FIRE PROTECTION ASSOCIATION Image: Conservation Subcode of the Uniform WORK IN THIS PROJECT AS DEFINED BY CHAPTER 5.24 "REHABILITATION SUBCODE" OF THE UNIFORM WALLS, FLOORS, CERLINGS, SIERS ENCLUDES THE SELECTIVE DENOLITION OF SUBJECT OF NEW JERSEY OUALIPIES AS A RECONSTRUCTION. THE WORK IN THIS PROJECT AS DEFINED WALLS, INTERIOR WALLS, FLOORS, CERLINGS, SIERS EQUIPMENT, FRUTURES, DUCTWORK A FLUMBING. JILDING SUMMARY E GROUP INSTRUCTION TYPE RINKLERS COND FLOOR AREA OF WORK COUPANT LOAD COUPANT LOAD COUPANT LOAD PERFERENCE RATING REQUIREMENTS F - INTERNATIONAL BUILDING CODE - NEW JERSEY EDITION INTERIOR INTERIOR CONSTRUCTION & SECONDARY MEMBERS <td colspan<="" td=""><td>INTERNATIONAL MECHANICAL CODE INTERNATIONAL FUEL GAS CODE INTERNATIONAL FUEL GAS CODE INTERNATIONAL ENERGY CONSERVATION CODE INTERNATION SUBCODE OF THE STATE OF NEW JERSEY, OUALIFIES AS A RECONSTRUCTION. THE WORK INTHIS PROJECT. AS DEFINED BY CHAPTER 5.23.6 "REHABILITATION SUBCODE" OF THE UNER CONSTRUCTION CODE OF THE STATE OF NEW JERSEY, OUALIFIES AS A RECONSTRUCTION. THE WORK INTRIS PROJECT. AS DEFINED BY CHAPTER 5.23.6 "REHABILITATION SUBCODE" OF THE UNER CONSTRUCTION CODE OF THE STATE OF NEW JERSEY, OUALIFIES AS A RECONSTRUCTION. THE WORK INTRIS PROJECT. AS DEFINED BY CHAPTER 5.23.6 "REHABILITATION SUBCODE" OF THE UNER CONSTRUCTION CODE OF THE STATE OF NEW JERSEY, OUALIFIES AS A RECONSTRUCTION. THE WORK INTRIS PROJECT. AS DEFINED BY CHAPTER SO TO THE STATE OF NEW JERSEY SUBJECODE OF THE UNER SUBJECTION TYPE SUBJECTION TYPE SUBJECTION TYPE SUBJECTION TYPE SUBJECTION TYPE SUBJECT OF THE WORK INTRICTION TYPE SUBCODE AREA OF WORK 11 SECOND FLOOR AREA OF WORK 12 SECOND SECOND</td><td>AL CODE 22 CODE 23 COD</td></td>	<td>INTERNATIONAL MECHANICAL CODE INTERNATIONAL FUEL GAS CODE INTERNATIONAL FUEL GAS CODE INTERNATIONAL ENERGY CONSERVATION CODE INTERNATION SUBCODE OF THE STATE OF NEW JERSEY, OUALIFIES AS A RECONSTRUCTION. THE WORK INTHIS PROJECT. AS DEFINED BY CHAPTER 5.23.6 "REHABILITATION SUBCODE" OF THE UNER CONSTRUCTION CODE OF THE STATE OF NEW JERSEY, OUALIFIES AS A RECONSTRUCTION. THE WORK INTRIS PROJECT. AS DEFINED BY CHAPTER 5.23.6 "REHABILITATION SUBCODE" OF THE UNER CONSTRUCTION CODE OF THE STATE OF NEW JERSEY, OUALIFIES AS A RECONSTRUCTION. THE WORK INTRIS PROJECT. AS DEFINED BY CHAPTER 5.23.6 "REHABILITATION SUBCODE" OF THE UNER CONSTRUCTION CODE OF THE STATE OF NEW JERSEY, OUALIFIES AS A RECONSTRUCTION. THE WORK INTRIS PROJECT. AS DEFINED BY CHAPTER SO TO THE STATE OF NEW JERSEY SUBJECODE OF THE UNER SUBJECTION TYPE SUBJECTION TYPE SUBJECTION TYPE SUBJECTION TYPE SUBJECTION TYPE SUBJECT OF THE WORK INTRICTION TYPE SUBCODE AREA OF WORK 11 SECOND FLOOR AREA OF WORK 12 SECOND SECOND</td> <td>AL CODE 22 CODE 23 COD</td>	INTERNATIONAL MECHANICAL CODE INTERNATIONAL FUEL GAS CODE INTERNATIONAL FUEL GAS CODE INTERNATIONAL ENERGY CONSERVATION CODE INTERNATION SUBCODE OF THE STATE OF NEW JERSEY, OUALIFIES AS A RECONSTRUCTION. THE WORK INTHIS PROJECT. AS DEFINED BY CHAPTER 5.23.6 "REHABILITATION SUBCODE" OF THE UNER CONSTRUCTION CODE OF THE STATE OF NEW JERSEY, OUALIFIES AS A RECONSTRUCTION. THE WORK INTRIS PROJECT. AS DEFINED BY CHAPTER 5.23.6 "REHABILITATION SUBCODE" OF THE UNER CONSTRUCTION CODE OF THE STATE OF NEW JERSEY, OUALIFIES AS A RECONSTRUCTION. THE WORK INTRIS PROJECT. AS DEFINED BY CHAPTER 5.23.6 "REHABILITATION SUBCODE" OF THE UNER CONSTRUCTION CODE OF THE STATE OF NEW JERSEY, OUALIFIES AS A RECONSTRUCTION. THE WORK INTRIS PROJECT. AS DEFINED BY CHAPTER SO TO THE STATE OF NEW JERSEY SUBJECODE OF THE UNER SUBJECTION TYPE SUBJECTION TYPE SUBJECTION TYPE SUBJECTION TYPE SUBJECTION TYPE SUBJECT OF THE WORK INTRICTION TYPE SUBCODE AREA OF WORK 11 SECOND FLOOR AREA OF WORK 12 SECOND	AL CODE 22 CODE 23 COD
TERNATIONAL FUEL GAS CODE TERNATIONAL ENERGY CONSERVATION CODE TERNATIONAL ENERGY CONSERVATION CODE RRIER-FREE SUBCODE NJAC 5 ZANSI A117.1- TIONAL FIRE PROTECTION ASSOCIATION A117.1- TIONAL PROTECTION ASSOCIATION A117.1- TIONAL BUILDING CODE - NEW JERSEY EDITION A117.1- TIOTERNATIONAL BUILDING CODE - NEW JERSEY EDITION A117.1- TIOTERNATIONAL BUILDING CODE - NEW JERSEY EDITION A14.5- TINTERNATIONAL BUILDING CODE - NEW JERSEY EDITION A14.5- TIOTEGRESS PLANS FOR MORE INFORMATION TE REFER TO EGRESS PLANS FOR MORE INFORMATION TO PLANTING PLA	INTERNATIONAL FUEL GAS CODE INTERNATIONAL ENERGY CONSERVATION CODE INTERNATIONAL ENERGY CONSERVATION CODE BARRIER-FREE SUBCODE INTERNATIONAL ENERGY CONSERVATION CODE BARRIER-FREE SUBCODE INJAM ICC/ANSI ATIONAL FIRE PROTECTION ASSOCIATION ICC/ANSI ICC/ANSI INTERIOR SUBCODE OF THE STATE OF NEW JERSEY OUALIFIES AS A RECONSTRUCTION. THE WORK INTHIS PROJECT, AS DEFINED BY CHAPTER 5.23.9 TREHABILITATION SUBCODE ⁺ OF THE UNF CONSTRUCTION CODE OF THE STATE OF NEW JERSEY. OUALIFIES AS A RECONSTRUCTION. THE WORK INTERIOR WALLS, FLOORS THE SELECTIVE DEMOLITION OF EXTERIOR WALLS, INTERIOR WALLS, FLOORS , CEILING FINISHES, EQUIPMENT, FIXTURES, DUCTWORK & PLUMBING. BUILDING SUMMARY USE GROUP CONSTRUCTION TYPE SPRINKLERS FIRST FLOOR AREA OF WORK INTERS FIRST FLOOR AREA OF WORK INTERS FIRST FLOOR AREA OF WORK INTERS FIRST FLOOR AREA OF WORK INTERNATIONAL BUILDING CODE - NEW JERSEY EDITION COCCU AREA OF WORK INTERNATIONAL BUILDING CODE - NEW JERSEY EDITION INTERERS FIRE RESISTANCE RATING REQUIREMENTS FIRE RESISTANCE RATING REQUIREMENTS REF - INTERNATIONAL BUILDING CODE - NEW JERSEY EDITION INTE: REFER TO EGRESS PLANS FOR MORE INFORMATION FIRE RESISTANCE RATING REQUIREMENTS REF - INTERNATIONAL BUILDING CODE - NEW JERSEY EDITION INTE: REFER TO EGRESS PLANS FOR MORE INFORMATION FIRE RESISTANCE RATING REQUIREMENTS FIRE A OF WORK INTERIOR JENTER INFORMATION INTE: REFER TO EGRESS PLANS FOR MORE INFORMATION FIRE RESISTANCE RATING REQUIREMENTS FIRE A OF WORK INTERIOR JENT INTERIOR 2 HR BEARING WALLS & PARTITIONS INTERIOR I	CODE 2 DNSERVATION CODE 2 NARCS A117.1-2 N ASSOCIATION 2 NED BY CHAPTER 5.23-6 "REHABILITATION SUBCODE" OF THE UNIFORM WALLS, INTERIOR WALLS, FLOORS, CEILINGS, TWORK & PLUMBING. 2 NED BY CHAPTER 5.23-6 "REHABILITATION SUBCODE" OF THE UNIFORM WALLS, INTERIOR WALLS, FLOORS, CEILINGS, TWORK & PLUMBING. 2 NEX 1,600 ORK 1,855 RK 1,600 /ORK 1,855 RK 3,460 NG CODE - NEW JERSEY EDITION 2015 TAE 1004.1. OCCUPAI 3,460 MORE INFORMATION 2015 TAE 601 & 6	
TERNATIONAL FUEL GAS CODE TERNATIONAL ENERGY CONSERVATION CODE TERNATIONAL ENERGY CONSERVATION CODE RRIER-FREE SUBCODE NJAC 5 ZANSI A117.1- TIONAL FIRE PROTECTION ASSOCIATION A117.1- TIONAL PROTECTION ASSOCIATION A117.1- TIONAL BUILDING CODE - NEW JERSEY EDITION A117.1- TIOTERNATIONAL BUILDING CODE - NEW JERSEY EDITION A117.1- TIOTERNATIONAL BUILDING CODE - NEW JERSEY EDITION A14.5- TINTERNATIONAL BUILDING CODE - NEW JERSEY EDITION A14.5- TIOTEGRESS PLANS FOR MORE INFORMATION TE REFER TO EGRESS PLANS FOR MORE INFORMATION TO PLANTING PLA	INTERNATIONAL FUEL GAS CODE INTERNATIONAL ENERGY CONSERVATION CODE INTERNATIONAL ENERGY CONSERVATION CODE BARRIER-FREE SUBCODE INTERNATIONAL ENERGY CONSERVATION CODE BARRIER-FREE SUBCODE INJACTOR CODE COLORANT ICC/ANSI ATIONAL FIRE PROTECTION ASSOCIATION INTERIOR WALLS PROTECTION ASSOCIATION INTERIOR WALLS FOR DAY CHAPTER 5.23.9 REHABILITATION SUBCODE ⁺ OF THE UNFORMATION CODE OF THE STATE OF NEW JERSEY, OULJIERS AS A RECONSTRUCTION. THE WORK I PHASE INCLORES THE SELECTIVE DEMOLTION OF EXTERNOR WALLS, INTERIOR WALLS, FLOORS, CEILING FINISHES, EQUIPMENT, FIXTURES, DUCTWORK & PLUMBING. BUILDING SUMMARY USE GROUP CONSTRUCTION TYPE SPRINKLERS FIRST FLOOR AREA OF WORK INTERS FIRST FLOOR AREA OF WORK INTERS FIRST FLOOR AREA OF WORK INTERNATIONAL BUILDING CODE - NEW JERSEY EDITION COCCUPANT LOAD REF - INTERNATIONAL BUILDING CODE - NEW JERSEY EDITION COCCUPANT LOAD REF - INTERNATIONAL BUILDING CODE - NEW JERSEY EDITION FIRE RESISTANCE RATING REQUIREMENTS REF - INTERNATIONAL BUILDING CODE - NEW JERSEY EDITION COCCU AREA OF WORK INTERIOR INFORMATION FIRE RESISTANCE RATING REQUIREMENTS REF - INTERNATIONAL BUILDING CODE - NEW JERSEY EDITION COCCU AREA OF WORK INTERIOR INFORMATION FIRE RESISTANCE RATING REQUIREMENTS REF - INTERNATIONAL BUILDING CODE - NEW JERSEY EDITION INTERIOR IN	CODE 2 DNSERVATION CODE 2 NARCS A117.1-2 N ASSOCIATION 2 NED BY CHAPTER 5.23-6 "REHABILITATION SUBCODE" OF THE UNIFORM 2 NED BY CHAPTER 5.23-6 "REHABILITATION SUBCODE" OF THE UNIFORM 2 NED BY CHAPTER 5.23-6 "REHABILITATION SUBCODE" OF THE UNIFORM 2 NED BY CHAPTER 5.23-6 "REHABILITATION SUBCODE" OF THE UNIFORM 2 NED BY CHAPTER 5.23-6 "REHABILITATION SUBCODE" OF THE UNIFORM 2 NED BY CHAPTER 5.23-6 "REHABILITATION SUBCODE" OF THE UNIFORM 2 NEW JERSEY, QUALIFIES AS A RECONSTRUCTION. THE WORK IN TH 2 OUTION OF EXTERIOR WALLS, INTERIOR WALLS, FLOORS, CEILINGS, TWORK & PLUMBING. 2 RK 1,600 /ORK 1,850 RK 1,600 /ORK 1,850 RK 3,460 NG CODE - NEW JERSEY EDITION 2015 TAE ING CODE - NEW JERSEY EDITION 2015 TAE MRE 2 HR EXTERIOR 2 ING CODE - NEW JERSEY EDITION 2015 TAE 601 & 600 2 MRE 2 HR EXTERIOR 2 HR	
TERNATIONAL ENERGY CONSERVATION CODE NJAC 5 RRIER-FREE SUBCODE NJAC 5 C/ANSI A117.1- TIONAL FIRE PROTECTION ASSOCIATION International control of the state of new deserve qualifies as a neconstruction. The work in this project, as defined by chapter 5.23-6 trendealilitation subcode: or the work in the seconstruction. The work in the seconstruction of extension walls, interior walls, floores. Coundent, participation. JILDING SUMMARY E GROUP Instruction type Instruction type RinkLERS Instruction type RinkLERS Instruction type RinkLERS Instruction type COUD FLOOR AREA OF WORK 1.86 CCUPANT LOAD International building CODE - NEW JERSEY EDITION 2015 TAI 1004.1 International building CODE - NEW JERSEY EDITION 2015 TAI 601 &	INTERNATIONAL ENERGY CONSERVATION CODE International Energy Conservation Code NJAM BARRIER-FREE SUBCODE NJAM ICC/ANSI A117 NATIONAL FIRE PROTECTION ASSOCIATION ATTIONAL FIRE PROTECTION ASSOCIATION CODE OF THE UNIT CONSTRUCTION CODE OF THE STATE OF NEW JERSEY, QUALIFIES AS A RECONSTRUCTION. THE WORK I PHASE INCLUDES THE SELECTIVE DEMOLITION OF EXTERIOR WALLS, INTERIOR WALLS, FLOORS, CELINA PHASE INCLUDES THE SELECTIVE DEMOLITION OF EXTERIOR WALLS, INTERIOR WALLS, FLOORS, CELINA PHASE INCLUDES THE SELECTIVE DEMOLITION OF EXTERIOR WALLS, INTERIOR WALLS, FLOORS, CELINA PHASE INCLUDES THE SELECTIVE DEMOLITION OF EXTERIOR WALLS, INTERIOR WALLS, FLOORS, CELINA PHASE INCLUDES THE SELECTIVE DEMOLITION OF EXTERIOR WALLS, INTERIOR WALLS, FLOORS, CELINA PHASE INCLUDES THE SELECTIVE DEMOLITION OF EXTERIOR WALLS, INTERIOR WALLS, FLOORS, CELINA PHASE INCLUDES THE SELECTIVE DEMOLITION OF EXTERIOR WALLS, INTERIOR WALLS, FLOORS, CELINA PHASE INCLUDES THE SELECTIVE DEMOLITION OF EXTERIOR WALLS, INTERIOR WALLS, FLOORS, CELINA FINISHES, ECOUP CONSTRUCTION TYPE SPRINKLERS FIRST FLOOR AREA OF WORK 1 TOTAL GROSS AREA OF WORK 1 TOTAL GROSS AREA OF WORK 3 OCCCU AREA OF WORK 3,460 NOTE: REFER TO EGRESS PLANS FOR MORE INFORMATION FIRE RESISTANCE RATING REQUIREMENTS REF - INTERNATIONAL BUILDING CODE - NEW JERSEY EDITION 2015 601 PRIMARY STRUCTURAL FRAME 2 HR BEARING WALLS EXTERIOR 2 HR NON BEARING WALLS & PARTITIONS INTERIOR 2 HR NON BEARING WALLS & PARTITIONS	DNSERVATION CODE 2 NJAC 5: A117.1-2 N ASSOCIATION 2 N ASSOCIATION 2 Deb BY CHAPTER 5.23-6 "REHABILITATION SUBCODE" OF THE UNIFORM 2 Def New JERSEY, QUALIFIES AS A RECONSTRUCTION. THE WORK IN TH 2 OLITION OF EXTERIOR WALLS, INTERIOR WALLS, FLOORS, CEILINGS, TWORK & PLUMBING. 2 ARY 2 RK 1,600 700RK 1,850 RK 1,860 700RK 2015 TAE 1004.1. 0CCUPAI 3,460 3,460 MORE INFORMATION 2015 TAE RATING REQUIREMENTS 2015 TAE ING CODE - NEW JERSEY EDITION 2015 TAE 601 & 600 3,460 MORE INFORMATION 2015 TAE EXTERIOR 2 ING CODE - NEW JERSEY EDITION 2015 TAE 601 & 600 3,460 MORE INFORMATION 2 EXTERIOR 2 ING CODE - NEW JERSEY EDITION 2015 TAE 601 & 600 2 INTERIOR 2 INTERIOR 2	
RRIER-FREE SUBCODE NJAC 5 C/ANSI A117.1- TIONAL FIRE PROTECTION ASSOCIATION	BARRIER-FREE SUBCODE NJAC ICC/ANSI A117 NATIONAL FIRE PROTECTION ASSOCIATION A117 THE WORK IN THIS PROJECT, AS DEFINED BY CHAPTER 5.23.6 "REHABILITATION SUBCODE" OF THE UNIF CONSTRUCTION CODE OF THE STATE OF NEW JERSEY, QUALIFIES AS A RECONSTRUCTION. THE WORK I PHASE INCLUDES THE SELECTIVE BOUNDERS, DELIMINER, DUCINOR & PLUMBING. BUILDING SUMMARY USE GROUP CONSTRUCTION TYPE SPRINKLERS FIRST FLOOR AREA OF WORK 1 SECOND FLOOR AREA OF WORK 1 SECOND FLOOR AREA OF WORK 1 OCCCUPANT LOAD 2015 REF - INTERNATIONAL BUILDING CODE - NEW JERSEY EDITION 2015 NOTE: REFER TO EGRESS PLANS FOR MORE INFORMATION 2015 FIRE RESISTANCE RATING REQUIREMENTS 2015 REF - INTERNATIONAL BUILDING CODE - NEW JERSEY EDITION 2015 NOTE: REFER TO EGRESS PLANS FOR MORE INFORMATION 2015 REF - INTERNATIONAL BUILDING CODE - NEW JERSEY EDITION 2015 NOTE: REFER TO EGRESS PLANS FOR MORE INFORMATION 2015 REF - INTERNATIONAL BUILDING CODE - NEW JERSEY EDITION 2015 NON BEARING WALLS 2 HR NON BEARING WALLS & PARTITIONS 2 HR NON BEARING WALLS & PARTITIONS X > 30	NJAC 5: A117.1-2 N ASSOCIATION 2 Need by Chapter 5.23-6 "Rehabilitation subcode" of the Uniform of exterior walls, interior walls, FLOORS, Cellings, TWORK & PLUMBING. ARY 2 3 2 2 2 2 2 2 2 3 3 3 3 4 2 2 2 2 3 4 4 4 4 4	
ZANSI A117.1- TIONAL FIRE PROTECTION ASSOCIATION	ICC/ANSI A117 NATIONAL FIRE PROTECTION ASSOCIATION Intervention Intervention Intervention The WORK IN THIS PROJECT, AS DEFINED BY CHAPTER 5,23-6 'REHABILITATION SUBCODE' OF THE UNIF Intervention CONSTRUCTION CODE OF THE STATE OF NEW JERSEY, QUALIFIES AS A RECONSTRUCTION. THE WORK I Intervention PHASE INCLUES THE SELECTIVE DEMOLITION OF EXTERIOR WALLS, INTERIOR & AND INTERIOR PROVINCE	A117.1-2 N ASSOCIATION A117.1-2 N ASSOCIATION ASSOCIATION ASSOCIATION ASSOCIATION ASSOCIATION ASSOCIATION ASSOCIATION ACCOUNT AS A RECONSTRUCTION. THE UNIFORM OF NEW JERSEY, QUALIFIES AS A RECONSTRUCTION. THE WORK IN TH OLITION OF EXTERIOR WALLS, INTERIOR WALLS, FLOORS, CEILINGS, TWORK & PLUMBING. ARY ARY ARY ARY ARY ARY ARY ARY ARX ASSOCIATION AR	
TIONAL FIRE PROTECTION ASSOCIATION TIONAL FIRE PROTECTION ASSOCIATION TIONAL FIRE PROTECTION ASSOCIATION TION CODE OF THE STATE OF NEW JERGEY, OUALIES AS A RECONSTRUCTION. THE WORK IN THE SERVICUDES THE STATE OF NEW JERGEY, OUALIES AS A RECONSTRUCTION. THE WORK IN THE SERVICUDES THE STATE OF NEW JERGEY, OUALIES AS A RECONSTRUCTION. THE WORK IN THE SERVICUDES THE STATE OF NEW JERGEY AUALIS, INTERIOR WALLS, FLOORS, CELINGS, SHES, EQUIPMENT, FIXTURES, DUCTWORK & PLUMBING. JILDING SUMMARY E GROUP TION TYPE TRINKLERS TRICTION TYPE TRINKLERS TAL GROSS AREA OF WORK TE REFERT TO EGRESS PLANS FOR MORE INFORMATION TAL BUILDING CODE - NEW JERSEY EDITION TO THE TOR A SECONDARY MEMBERS TAL THR THERIOR WALLS & PARTITIONS TAL GROSS AND EXIT PASSAGEWAYS TAL THR THERIOR AND EXIT PASSAGEWAYS TAL ARD AND ENCLOSED SPACES TAL ARD AND ENCLOSED SPACES TAL ARD AND ENCLOSED SPACES	NATIONAL FIRE PROTECTION ASSOCIATION Intervent of the second struction approximation of the unit of the state of new Jersey, Qualifies as a Reconstruction. The work i unit of the state of new Jersey, Qualifies as a Reconstruction. The work i prises excludes the selective benolition of exterior walls, interior walls, proors, celling prises excludes the selective benolition of exterior walls, interior walls, proors, celling prises excludes the selective benolition of exterior walls, interior walls, proors, celling prises excludes the selective benolition of exterior walls, interior walls, proors, celling prises excludes the selective benolition of exterior walls, interior walls, proors, celling prises excludes the selective benolition of exterior walls, interior walls, proors, celling prises excludes the selective benolition of exterior walls, interior walls, proors, celling prises excludes the selective benolition of exterior walls, interior walls, proors, celling prises excludes the selective benolition of exterior walls, interior walls, proors, celling prises excludes the selective benolition of exterior walls, interior walls, proors, celling prises excludes the selective benolition of exterior walls, interior walls, proors, celling prises excludes the selective benolition of exterior walls, interior walls, proors, celling prises excludes the selective benolition of exterior walls, interior walls, proors, celling prises excludes the selective benolities of the selecting benchart bend benolitis of the selective benolities of the selec	N ASSOCIATION 2 NeD BY CHAPTER 5.23-6 "REHABILITATION SUBCODE" OF THE UNIFORM DF NEW JERSEY, QUALIFIES AS A RECONSTRUCTION. THE WORK IN TH OLITION OF EXTERIOR WALLS, INTERIOR WALLS, FLOORS, CEILINGS, TWORK & PLUMBING. ARY RK 1,602 TORK 1,855 RK 3,460 NG CODE - NEW JERSEY EDITION 2015 TAE 1004.1. OCCUPAN 3,460 MORE INFORMATION RATING REQUIREMENTS ING CODE - NEW JERSEY EDITION 2015 TAE 601 & 602 ME 2 HR EXTERIOR 2 INTERIOR 2 HR RTITIONS X > 30 = 0 INTERIOR 2 HR ECONDARY MEMBERS 2 HR	
EVORK IN THIS PROJECT, AS DEFINED BY CHAPTER 5.23-8 "REHABILITATION SUBCODE" OF THE UNIFORM STRUCTION CODE OF THE STATE OF NEW JERSEY, QUALIFIES AS A RECONSTRUCTION. THE WORK IN THE SERVICUTES THE SELECTIVE DEMOLTING OF EXTERIOR WALLS, INTERIOR WALLS, FLOORS, CELINGS, SHEE, EQUIPMENT, FIXTURES, DUCTWORK & PLUMEING. JILDING SUMMARY E GROUP INSTRUCTION TYPE RINKLERS STFLOOR AREA OF WORK 1,60 COND FLOOR AREA OF WORK 1,60 COND FLOOR AREA OF WORK 1,85 TTAL GROSS AREA OF WORK 1,86 CCUPANT LOAD F - INTERNATIONAL BUILDING CODE - NEW JERSEY EDITION 1004.1 00CCUPA TEA OF WORK 1,86 COCUPANT LOAD F - INTERNATIONAL BUILDING CODE - NEW JERSEY EDITION 2015 TAL 1004.1 00CCUPA TEA OF WORK 2015 TAL 1004.1 100	THE WORK IN THIS PROJECT, AS DEFINED BY CHAPTER 5.23.6 "REHABILITATION SUBCODE" OF THE UNIF CONSTRUCTION CODE OF THE STATE OF NEW JERSEY, QUALIFIES AS A RECONSTRUCTION. THE WORK I PHASE INCLUDES THE SELECTIVE DEMOLITION OF EXTERIOR WALLS, INTERIOR WALLS, FLOORS, CELLING BUILDING SUMMARY USE GROUP CONSTRUCTION TYPE SPRINKLERS FIRST FLOOR AREA OF WORK SECOND FLOOR AREA OF WORK SECOND FLOOR AREA OF WORK TOTAL GROSS AREA OF WORK OCCCUPANT LOAD REF - INTERNATIONAL BUILDING CODE - NEW JERSEY EDITION VORCUP AREA OF WORK SPRINKLERS FIRST FLOOR AREA OF WORK OCCUPANT LOAD REF - INTERNATIONAL BUILDING CODE - NEW JERSEY EDITION VORCUP AREA OF WORK SPRINKLERS FIRE RESISTANCE RATING REQUIREMENTS FIRE RESISTANCE RATING REQUIREMENTS REF - INTERNATIONAL BUILDING CODE - NEW JERSEY EDITION 2015 601 PRIMARY STRUCTURAL FRAME EXTERIOR INTERIOR 2 HR NON BEARING WALLS & PARTITIONS	NED BY CHAPTER 5.23-6 "REHABILITATION SUBCODE" OF THE UNIFORM DP NEW JERSEY, QUALIFIES AS A RECONSTRUCTION. THE WORK IN TH OLITION OF EXTERIOR WALLS, INTERIOR WALLS, FLOORS, CEILINGS, TWORK & PLUMBING. ARY RK 1,602 70 RK 1,602 70 RK 3,460 NG CODE - NEW JERSEY EDITION 2015 TAE 1004.1. OCCUPAN 3,460 MORE INFORMATION RATING REQUIREMENTS ING CODE - NEW JERSEY EDITION 2015 TAE 601 & 60 ME 2 HR EXTERIOR 2 HR RTITIONS 2 HR RTITIONS X > 30 = 0 INTERIOR 2 HR ECONDARY MEMBERS 2 HR	
INTRUCTION CODE OF THE STATE OF NEW JERSEY, QUALIFIES AS A RECONSTRUCTION. THE WORK IN THE SILCUTURE DEMOLITION OF EXTERIOR WALLS, INTERIOR WALLS, FLOORS, CEILINGS, SIGHES, EQUIPMENT, FIXTURES, DUCTWORK & PLUMBING. JILDING SUMMARY E GROUP INSTRUCTION TYPE GROUP INSTRUCTION TYPE IRINKLERS IRST FLOOR AREA OF WORK INSTRUCTION AREA OF WORK INSTRUCTION AREA OF WORK INSTRUCTION TYPE IRINKLERS INTERNATIONAL BUILDING CODE - NEW JERSEY EDITION INTERIOR F - INTERNATIONAL BUILDING CODE - NEW JERSEY EDITION INTERIOR 2 HR IN BEARING WALLS & PARTITIONS EXTERIOR INTERIOR 2 HR INTERNATIONAL BUILDING CODE - NEW JERSEY EDITION INTERIOR 2 HR INTERNATIONAL BUILDING CODE - NEW JERSEY EDITION INTERIOR 2 HR INTERNATIONAL BUILDING CODE - NEW JERSEY EDITION INTERIOR 2 HR INTERNATIONAL BUILDING CODE - NEW JERSEY	construction code of the state of New Jersey, QUALIFIES AS A RECONSTRUCTION THE WORK I PHASE INCLUDES THE SUECTIVE DEMOLITION OF EXTERIOR WALLS, INTERIOR WALLS, FLOORS, CEILING FINISHES, EQUIPMENT, FIXTURES, DUCTWORK & PLUMBING. BUILDING SUMMARY USE GROUP CONSTRUCTION TYPE SPRINKLERS FIRST FLOOR AREA OF WORK SECOND FLOOR AREA OF WORK TOTAL GROSS AREA OF WORK OCCUPANT LOAD REF - INTERNATIONAL BUILDING CODE - NEW JERSEY EDITION AREA OF WORK AREA OF WORK SPRIME REF - INTERNATIONAL BUILDING CODE - NEW JERSEY EDITION 2015 100 OCCU AREA OF WORK SPRIME EXPENSION REF - INTERNATIONAL BUILDING CODE - NEW JERSEY EDITION 2015 100 OCCU AREA OF WORK SPRIMARY STRUCTURAL FRAME BEARING WALLS EXTERIOR INTERIOR INTERIOR INTERIOR INTERNOR	DE NEW JERSEY, QUALIFIES AS A RECONSTRUCTION. THE WORK IN TH OLITION OF EXTERIOR WALLS, INTERIOR WALLS, FLOORS, CEILINGS, TWORK & PLUMBING. ARY RK 1,602 (ORK 1,852 RK 3,460 ING CODE - NEW JERSEY EDITION 2015 TAE 1004.1. OCCUPAN 3,460 MORE INFORMATION RATING REQUIREMENTS ING CODE - NEW JERSEY EDITION 2015 TAE 601 & 600 MORE INFORMATION RATING REQUIREMENTS ING CODE - NEW JERSEY EDITION 2015 TAE 601 & 600 MORE INFORMATION RATING REQUIREMENTS ING CODE - NEW JERSEY EDITION 2015 TAE 601 & 600 ME 2 HR EXTERIOR 2 HR EXTERIOR 2 HR EXTERIOR 2 HR ECONDARY MEMBERS 2 HR	
E GROUP INSTRUCTION TYPE RINKLERS RINKLERS RINKLERS RIST FLOOR AREA OF WORK RITAL GROSS AREA OF WORK COUD FLOOR AREA OF WORK RITAL GROSS AREA OF WORK RITAL GROSS AREA OF WORK COUPANT LOAD F - INTERNATIONAL BUILDING CODE - NEW JERSEY EDITION COCCUPA F - INTERNATIONAL BUILDING CODE - NEW JERSEY EDITION RE RESISTANCE RATING REQUIREMENTS F - INTERNATIONAL BUILDING CODE - NEW JERSEY EDITION RITAL S IMARY STRUCTURAL FRAME 2 HR ARING WALLS EXTERIOR INTERIOR 2 HR OOR CONSTRUCTION & SECONDARY MEMBERS 1 HR ITERIOR WALLS & CEILING FINISH REQUIREMENT F - INTERNATIONAL BUILDING CODE - NEW JERSEY EDITION 2 HR OOR CONSTRUCTION & SECONDARY MEMBERS 2 HR OOR CONSTRUCTIO	USE GROUP USE GROUP USE GROUP CONSTRUCTION TYPE SPRINKLERS FIRST FLOOR AREA OF WORK FIRST FLOOR AREA OF WORK 1 SECOND FLOOR AREA OF WORK 1 TOTAL GROSS AREA OF WORK 3 OCCUPANT LOAD REF - INTERNATIONAL BUILDING CODE - NEW JERSEY EDITION COCCU AREA OF WORK 3,460 NOTE: REFER TO EGRESS PLANS FOR MORE INFORMATION FIRE RESISTANCE RATING REQUIREMENTS REF - INTERNATIONAL BUILDING CODE - NEW JERSEY EDITION 2015 601 PRIMARY STRUCTURAL FRAME 2 HR BEARING WALLS A PARTITIONS EXTERIOR X > 30	RK 1,60 /ORK 1,85 RK 3,46 O 2015 TAE 1004.1 ING CODE - NEW JERSEY EDITION 2015 TAE 1004.1 OCCUPAI 3,460 MORE INFORMATION 2015 TAE 601 & 601 & 601 & 601 & 601 & 601 & 601 & 600 & 601 & 601 & 601 & 600 & 601 & 600 & 601 & 600	
INSTRUCTION TYPE RINKLERS RINKLERS RST FLOOR AREA OF WORK COND FLOOR AREA OF WORK COND FLOOR AREA OF WORK IAS ITAL GROSS AREA OF WORK CCUPANT LOAD F - INTERNATIONAL BUILDING CODE - NEW JERSEY EDITION COCCUPA F - INTERNATIONAL BUILDING CODE - NEW JERSEY EDITION REA OF WORK RE RESISTANCE RATING REQUIREMENTS F - INTERNATIONAL BUILDING CODE - NEW JERSEY EDITION RINGRY STRUCTURAL FRAME ARING WALLS EXTERIOR INTERIOR INTERIOR 2 HR N BEARING WALLS & PARTITIONS EXTERIOR INTERIOR 2 HR OOR CONSTRUCTION & SECONDARY MEMBERS 2 HR INTERIOR 2 HR INTER	CONSTRUCTION TYPE CONSTRUCTION TYPE SPRINKLERS I FIRST FLOOR AREA OF WORK 1 SECOND FLOOR AREA OF WORK 1 TOTAL GROSS AREA OF WORK 3 OCCUPANT LOAD 2015 REF - INTERNATIONAL BUILDING CODE - NEW JERSEY EDITION 2015 OCCU AREA OF WORK 3,460 NOTE: REFER TO EGRESS PLANS FOR MORE INFORMATION 0CCU FIRE RESISTANCE RATING REQUIREMENTS 2015 REF - INTERNATIONAL BUILDING CODE - NEW JERSEY EDITION 2015 PRIMARY STRUCTURAL FRAME 2 HR BEARING WALLS EXTERIOR 2 HR NON BEARING WALLS & PARTITIONS EXTERIOR X > 30	RK 1,60. /ORK 1,85 RK 3,460 ING CODE - NEW JERSEY EDITION 2015 TAE 1004.1. OCCUPAI 3,460 MORE INFORMATION 2015 TAE 1004.1. MORE INFORMATION 2015 TAE 1004.1. MORE INFORMATION 2015 TAE 601 & 600 ME 2 HR EXTERIOR 2 INTERIOR 2 EXTERIOR 2 INTERIOR 2 HR EXTERIOR 2 INTERIOR 2 HR EXTERIOR 2 HR EXTERIOR 2 HR EXTERIOR 2 HR ECONDARY MEMBERS 2 HR	
RINKLERS 1,60 COND FLOOR AREA OF WORK 1,60 COND FLOOR AREA OF WORK 3,40 VTAL GROSS AREA OF WORK 3,40 VCCUPANT LOAD 2015 TAI 1004.1 VCCUPANT LOAD 00CUPA F - INTERNATIONAL BUILDING CODE - NEW JERSEY EDITION 2015 TAI 1004.1 OCCUPA 3,460 REA OF WORK 3,460 FE RESISTANCE RATING REQUIREMENTS 2015 TAI 601 & 601 & 601 & 601 & 601 & 601 & 601 & 601 & 601 & 601 & 601 & 601 & 600	SPRINKLERS I FIRST FLOOR AREA OF WORK 1 SECOND FLOOR AREA OF WORK 1 TOTAL GROSS AREA OF WORK 3 OCCUPANT LOAD 2015 REF - INTERNATIONAL BUILDING CODE - NEW JERSEY EDITION 2015 NOTE: REFER TO EGRESS PLANS FOR MORE INFORMATION 3,460 NOTE: REFER TO EGRESS PLANS FOR MORE INFORMATION 2015 REF - INTERNATIONAL BUILDING CODE - NEW JERSEY EDITION 2015 REF - INTERNATIONAL BUILDING CODE - NEW JERSEY EDITION 2015 REF - INTERNATIONAL BUILDING CODE - NEW JERSEY EDITION 2015 REF - INTERNATIONAL BUILDING CODE - NEW JERSEY EDITION 2015 REF - INTERNATIONAL BUILDING CODE - NEW JERSEY EDITION 2015 REF - INTERNATIONAL BUILDING CODE - NEW JERSEY EDITION 2015 REF - INTERNATIONAL BUILDING CODE - NEW JERSEY EDITION 2015 REF - INTERNATIONAL BUILDING CODE - NEW JERSEY EDITION 2015 REF - INTERNATIONAL BUILDING CODE - NEW JERSEY EDITION 2015 REF - INTERNATIONAL BUILDING CODE - NEW JERSEY EDITION 2015 REF - INTERNATIONAL BUILDING CODE - NEW JERSEY EDITION 2015 REF - INTERNATIONAL BUILDING CODE - NEW JERSEY EDITION 2015 REF - INTERNATIONAL BUILDING COD	RK 1,602 /ORK 1,853 RK 3,460 ING CODE - NEW JERSEY EDITION 2015 TAE 1004.1. OCCUPAN 3,460 MORE INFORMATION 0CCUPAN RATING REQUIREMENTS 2015 TAE 601 & 602 ING CODE - NEW JERSEY EDITION 2015 TAE 601 & 602 ING CODE - NEW JERSEY EDITION 2015 TAE 601 & 602 ING CODE - NEW JERSEY EDITION 2015 TAE 601 & 602 ING CODE - NEW JERSEY EDITION 2015 TAE 601 & 602 ING CODE - NEW JERSEY EDITION 2015 TAE 601 & 602 ING CODE - NEW JERSEY EDITION 2015 TAE 601 & 602 ING EXTERIOR 2 HR EXTERIOR 2 HR EXTERIOR X > 30 = 02 INTERIOR 2 HR ECONDARY MEMBERS 2 HR	
RST FLOOR AREA OF WORK 1,60 COND FLOOR AREA OF WORK 1,80 TAL GROSS AREA OF WORK 3,40 CCUPANT LOAD 2015 TAI F - INTERNATIONAL BUILDING CODE - NEW JERSEY EDITION 2015 TAI OCCUPA 3,460 VEA OF WORK 3,460 REA OF WORK 3,460 F - INTERNATIONAL BUILDING CODE - NEW JERSEY EDITION 2015 TAI REA OF WORK 3,460 F - INTERNATIONAL BUILDING CODE - NEW JERSEY EDITION 2015 TAI RE RESISTANCE RATING REQUIREMENTS 2015 TAI F - INTERNATIONAL BUILDING CODE - NEW JERSEY EDITION 2015 TAI MARY STRUCTURAL FRAME 2 HR ARING WALLS EXTERIOR INTERIOR 2 HR INTERIOR 2 HR OOR CONSTRUCTION & SECONDARY MEMBERS 1 HR ITERIOR WALL & CEILING FINISH REQUIREMENT 2015 TAI ITERIOR WALL & CEILING FINISH REQUIREMENT 803.9 IT ENCLOSURES AND EXIT PASSAGEWAYS CLA OR CONSTRUCTION & SAGE OND EXIT PASSAGEWAYS CLA OR RIDORS CLA OWS AND ENCLOSED SPACES CLA	FIRST FLOOR AREA OF WORK 1 SECOND FLOOR AREA OF WORK 1 TOTAL GROSS AREA OF WORK 3 OCCUPANT LOAD 2015 REF - INTERNATIONAL BUILDING CODE - NEW JERSEY EDITION 2015 OCCU 0CCU AREA OF WORK 3,460 NOTE: REFER TO EGRESS PLANS FOR MORE INFORMATION 0CCU REF - INTERNATIONAL BUILDING CODE - NEW JERSEY EDITION 2015 NOTE: REFER TO EGRESS PLANS FOR MORE INFORMATION 2015 REF - INTERNATIONAL BUILDING CODE - NEW JERSEY EDITION 2015 REF - INTERNATIONAL BUILDING CODE - NEW JERSEY EDITION 2015 REF - INTERNATIONAL BUILDING CODE - NEW JERSEY EDITION 2015 REF - INTERNATIONAL BUILDING CODE - NEW JERSEY EDITION 2015 REF - INTERNATIONAL BUILDING CODE - NEW JERSEY EDITION 2015 REF - INTERNATIONAL BUILDING CODE - NEW JERSEY EDITION 2015 RETERIOR 2 HR BEARING WALLS 2 HR NON BEARING WALLS & PARTITIONS X > 30 INTERIOR X > 30	/ORK 1,854 /ORK 1,854 /RK 3,460 D 2015 TAE 1004.1. OCCUPAN 3,460 3,460 MORE INFORMATION 2015 TAE RATING REQUIREMENTS 2015 TAE ING CODE - NEW JERSEY EDITION 2015 TAE MRE 2 HR EXTERIOR 2 INTERIOR 2 INTERIOR 2 HR EXTERIOR 2 INTERIOR 2 HR ECONDARY MEMBERS 2 HR	
RST FLOOR AREA OF WORK 1,60 COND FLOOR AREA OF WORK 1,80 TAL GROSS AREA OF WORK 3,40 CCUPANT LOAD 2015 TAI F - INTERNATIONAL BUILDING CODE - NEW JERSEY EDITION 2015 TAI OCCUPA 3,460 VEA OF WORK 3,460 REA OF WORK 3,460 F - INTERNATIONAL BUILDING CODE - NEW JERSEY EDITION 2015 TAI REA OF WORK 3,460 F - INTERNATIONAL BUILDING CODE - NEW JERSEY EDITION 2015 TAI RE RESISTANCE RATING REQUIREMENTS 2015 TAI F - INTERNATIONAL BUILDING CODE - NEW JERSEY EDITION 2015 TAI MARY STRUCTURAL FRAME 2 HR ARING WALLS EXTERIOR INTERIOR 2 HR INTERIOR 2 HR OOR CONSTRUCTION & SECONDARY MEMBERS 1 HR ITERIOR WALL & CEILING FINISH REQUIREMENT 2015 TAI ITERIOR WALL & CEILING FINISH REQUIREMENT 803.9 IT ENCLOSURES AND EXIT PASSAGEWAYS CLA OR CONSTRUCTION & SAGE OND EXIT PASSAGEWAYS CLA OR RIDORS CLA OWS AND ENCLOSED SPACES CLA	FIRST FLOOR AREA OF WORK 1 SECOND FLOOR AREA OF WORK 1 TOTAL GROSS AREA OF WORK 3 OCCUPANT LOAD 2015 REF - INTERNATIONAL BUILDING CODE - NEW JERSEY EDITION 2015 OCCU 0CCU AREA OF WORK 3,460 NOTE: REFER TO EGRESS PLANS FOR MORE INFORMATION 0CCU REF - INTERNATIONAL BUILDING CODE - NEW JERSEY EDITION 2015 NOTE: REFER TO EGRESS PLANS FOR MORE INFORMATION 2015 REF - INTERNATIONAL BUILDING CODE - NEW JERSEY EDITION 2015 REF - INTERNATIONAL BUILDING CODE - NEW JERSEY EDITION 2015 REF - INTERNATIONAL BUILDING CODE - NEW JERSEY EDITION 2015 REF - INTERNATIONAL BUILDING CODE - NEW JERSEY EDITION 2015 REF - INTERNATIONAL BUILDING CODE - NEW JERSEY EDITION 2015 BEARING WALLS 2 HR BEARING WALLS EXTERIOR INTERIOR 2 HR NON BEARING WALLS & PARTITIONS X > 30	RK 1,602 /ORK 1,853 RK 3,460 ING CODE - NEW JERSEY EDITION 2015 TAE 1004.1. OCCUPAN 3,460 MORE INFORMATION 0CCUPAN RATING REQUIREMENTS 3,460 MORE INFORMATION 2015 TAE 601 & 601 ME 2 HR EXTERIOR 2 HR INTERIOR 2 HR RTITIONS X > 30 = 0 INTERIOR 2 HR EXTERIOR X > 30 = 0 INTERIOR 2 HR	
COND FLOOR AREA OF WORK 1,85 DTAL GROSS AREA OF WORK 3,46 CCUPANT LOAD 2015 TAI 1004.1 F - INTERNATIONAL BUILDING CODE - NEW JERSEY EDITION 2015 TAI 1004.1 OCCUPA 3,460 REA OF WORK 3,460 F - INTERNATIONAL BUILDING CODE - NEW JERSEY EDITION 2015 TAI 601 & 60 IMARY STRUCTURAL FRAME 2 HR ARING WALLS EXTERIOR INTERIOR 2 HR OOR CONSTRUCTION & SECONDARY MEMBERS 2 HR OOF CONSTRUCTION & SECONDARY MEMBERS 1 HR ITERIOR WALL & CEILING FINISH REQUIREMENT 2015 TAI 803.9 (SPRINKL D) IT ERIOR WALL & CEILING FINISH REQUIREMENT 803.9 (SPRINKL D) IT ENCLOSURES AND EXIT PASSAGEWAYS CLA ORNIDORS CLA OWS AND ENCLOSED SPACES CLA	SECOND FLOOR AREA OF WORK 11 TOTAL GROSS AREA OF WORK 23 OCCUPANT LOAD 2015 REF - INTERNATIONAL BUILDING CODE - NEW JERSEY EDITION 2015 100 0CCU AREA OF WORK 3,460 NOTE: REFER TO EGRESS PLANS FOR MORE INFORMATION FIRE RESISTANCE RATING REQUIREMENTS REF - INTERNATIONAL BUILDING CODE - NEW JERSEY EDITION 2015 601 PRIMARY STRUCTURAL FRAME 2 HR BEARING WALLS & PARTITIONS 2015 INTERIOR 2 HR NON BEARING WALLS & PARTITIONS 2 HR X > 30	VORK 1,858 RK 3,460 ING CODE - NEW JERSEY EDITION 2015 TAE 1004.1. OCCUPAN 3,460 MORE INFORMATION 3,460 MORE INFORMATION 2015 TAE 601 & 60 MRE 2 HR EXTERIOR 2 INTERIOR 2 HR EXTERIOR 2 INTERIOR 2 HR EXTERIOR 2 HR EXTERIOR 2 HR EXTERIOR 2 HR EXTERIOR 2 HR	
TAL GROSS AREA OF WORK 3,46 CCUPANT LOAD 2015 TAI 1004.1 CCUPANT LOAD 2015 TAI 1004.1 F - INTERNATIONAL BUILDING CODE - NEW JERSEY EDITION 2015 TAI 1004.1 OCCUPA 3,460 REA OF WORK 3,460 REA OF WORK 3,460 FE: REFER TO EGRESS PLANS FOR MORE INFORMATION 2015 TAI 601 & 60 RE RESISTANCE RATING REQUIREMENTS 2015 TAI 601 & 60 F - INTERNATIONAL BUILDING CODE - NEW JERSEY EDITION 2015 TAI 601 & 60 IMARY STRUCTURAL FRAME 2 HR ARING WALLS EXTERIOR INTERIOR 2 HR OOR CONSTRUCTION & SECONDARY MEMBERS 2 HR OOF CONSTRUCTION & SECONDARY MEMBERS 1 HR ITERIOR WALL & CEILING FINISH REQUIREMENT 803.9 (SPRINKL D) IT ENCLOSURES AND EXIT PASSAGEWAYS CLA ORRIDORS CLA OWS AND ENCLOSED SPACES CLA	TOTAL GROSS AREA OF WORK 3 OCCUPANT LOAD 2015 REF - INTERNATIONAL BUILDING CODE - NEW JERSEY EDITION 2015 OCCU 0CCU AREA OF WORK 3,460 NOTE: REFER TO EGRESS PLANS FOR MORE INFORMATION 0CCU FIRE RESISTANCE RATING REQUIREMENTS 2015 REF - INTERNATIONAL BUILDING CODE - NEW JERSEY EDITION 2015 601 2015 PRIMARY STRUCTURAL FRAME 2 HR BEARING WALLS EXTERIOR INTERIOR 2 HR NON BEARING WALLS & PARTITIONS INTERIOR	RK 3,460 ING CODE - NEW JERSEY EDITION 2015 TAE 1004.1. OCCUPAN 3,460 MORE INFORMATION 2015 TAE 601 & 60 MORE ODE - NEW JERSEY EDITION 2015 TAE 601 & 60 ING CODE - NEW JERSEY EDITION 2015 TAE 601 & 60 ME 2 HR EXTERIOR 2 INTERIOR 2 HR RTITIONS X > 30 = 0 INTERIOR 2 HR ECONDARY MEMBERS 2 HR	
CCUPANT LOAD F - INTERNATIONAL BUILDING CODE - NEW JERSEY EDITION 2015 TAI 1004.1 OCCUPA 3,460 REA OF WORK 3,460 TE: REFER TO EGRESS PLANS FOR MORE INFORMATION 2015 TAI 001 & 60 RE RESISTANCE RATING REQUIREMENTS 2015 TAI 601 & 60 F - INTERNATIONAL BUILDING CODE - NEW JERSEY EDITION 2015 TAI 601 & 60 IMARY STRUCTURAL FRAME 2 HR ARING WALLS EXTERIOR INTERIOR 2 HR INTERIOR 2 HR INTERIOR 2 HR OOR CONSTRUCTION & SECONDARY MEMBERS 2 HR DOF CONSTRUCTION & SECONDARY MEMBERS 1 HR ITERIOR WALL & CEILING FINISH REQUIREMENT 803.9 F - INTERNATIONAL BUILDING CODE - NEW JERSEY EDITION 2015 TAI 803.9 DOF CONSTRUCTION & SECONDARY MEMBERS 1 HR ITERIOR WALL & CEILING FINISH REQUIREMENT 2015 TAI 803.9 F - INTERNATIONAL BUILDING CODE - NEW JERSEY EDITION 2015 TAI 803.9 IT ENCLOSURES AND EXIT PASSAGEWAYS CLA ORRIDORS CLA	OCCUPANT LOAD REF - INTERNATIONAL BUILDING CODE - NEW JERSEY EDITION 2015 100 OCCU AREA OF WORK 3,460 NOTE: REFER TO EGRESS PLANS FOR MORE INFORMATION 3,460 NOTE: REFER TO EGRESS PLANS FOR MORE INFORMATION 2015 REF - INTERNATIONAL BUILDING CODE - NEW JERSEY EDITION 2015 PRIMARY STRUCTURAL FRAME 2 HR BEARING WALLS EXTERIOR NON BEARING WALLS & PARTITIONS X > 30	ING CODE - NEW JERSEY EDITION 2015 TAE 1004.1. OCCUPAN 3,460 MORE INFORMATION 3,460 RATING REQUIREMENTS ING CODE - NEW JERSEY EDITION 2015 TAE 601 & 601 ING CODE - NEW JERSEY EDITION 2015 TAE 601 & 601 IME 2 HR EXTERIOR 2 INTERIOR 2 HR INTERIOR 2 HR EXTERIOR X > 30 = 0 INTERIOR 2 HR ECONDARY MEMBERS 2 HR	
F - INTERNATIONAL BUILDING CODE - NEW JERSEY EDITION 2015 TAI 1004.1 OCCUPA 3,460 REA OF WORK 3,460 TE: REFER TO EGRESS PLANS FOR MORE INFORMATION 2015 TAI 601 &	REF - INTERNATIONAL BUILDING CODE - NEW JERSEY EDITION 2015 100 OCCU AREA OF WORK 3,460 NOTE: REFER TO EGRESS PLANS FOR MORE INFORMATION 3,460 FIRE RESISTANCE RATING REQUIREMENTS FIRE RESISTANCE RATING REQUIREMENTS REF - INTERNATIONAL BUILDING CODE - NEW JERSEY EDITION 2015 PRIMARY STRUCTURAL FRAME 2 HR BEARING WALLS EXTERIOR INTERIOR 2 HR NON BEARING WALLS & PARTITIONS X > 30	ING CODE - NEW JERSEY EDITION 2015 TAB 1004.1. OCCUPAN 3,460 MORE INFORMATION RATING REQUIREMENTS ING CODE - NEW JERSEY EDITION 2015 TAB 601 & 60 ME 2 HR 2 HR EXTERIOR 2 HR EXTERIOR X > 30 = 0 INTERIOR 2 HR ECONDARY MEMBERS 2 HR	
1004.1 OCCUPA REA OF WORK 3,460 TE: REFER TO EGRESS PLANS FOR MORE INFORMATION INFORMATION RE RESISTANCE RATING REQUIREMENTS F - INTERNATIONAL BUILDING CODE - NEW JERSEY EDITION 2015 TAI 601 &60 IMARY STRUCTURAL FRAME 2 HR ARING WALLS EXTERIOR INTERIOR 2 HR N BEARING WALLS & PARTITIONS X > 30 = INTERIOR 2 HR OOR CONSTRUCTION & SECONDARY MEMBERS 2 HR OOF CONSTRUCTION & SECONDARY MEMBERS 1 HR ITERIOR WALL & CEILING FINISH REQUIREMENT 803.9 F - INTERNATIONAL BUILDING CODE - NEW JERSEY EDITION 2015 TAI 803.9 (SPRINKL) D) IT ENCLOSURES AND EXIT PASSAGEWAYS CLA ORMS AND ENCLOSED SPACES CLA	100 AREA OF WORK 3,460 NOTE: REFER TO EGRESS PLANS FOR MORE INFORMATION 3,460 FIRE RESISTANCE RATING REQUIREMENTS FIRE RESISTANCE RATING REQUIREMENTS REF - INTERNATIONAL BUILDING CODE - NEW JERSEY EDITION 2015 PRIMARY STRUCTURAL FRAME 2 HR BEARING WALLS EXTERIOR INTERIOR 2 HR NON BEARING WALLS & PARTITIONS X > 30	1004.1. OCCUPAN 3,460 MORE INFORMATION RATING REQUIREMENTS ING CODE - NEW JERSEY EDITION 2015 TAE 601 & 60 ME 2 HR EXTERIOR 2 INTERIOR 2 HR RTITIONS X > 30 = 0 INTERIOR 2 HR EXTERIOR 2 HR ECONDARY MEMBERS 2 HR	
1004.1 OCCUPA REA OF WORK 3,460 TE: REFER TO EGRESS PLANS FOR MORE INFORMATION INFORMATION RE RESISTANCE RATING REQUIREMENTS F - INTERNATIONAL BUILDING CODE - NEW JERSEY EDITION 2015 TAI 601 &60 IMARY STRUCTURAL FRAME 2 HR ARING WALLS EXTERIOR INTERIOR 2 HR N BEARING WALLS & PARTITIONS X > 30 = INTERIOR 2 HR OOR CONSTRUCTION & SECONDARY MEMBERS 2 HR OOF CONSTRUCTION & SECONDARY MEMBERS 1 HR ITERIOR WALL & CEILING FINISH REQUIREMENT 803.9 F - INTERNATIONAL BUILDING CODE - NEW JERSEY EDITION 2015 TAI 803.9 (SPRINKL) D) IT ENCLOSURES AND EXIT PASSAGEWAYS CLA ORMS AND ENCLOSED SPACES CLA	100 AREA OF WORK 3,460 NOTE: REFER TO EGRESS PLANS FOR MORE INFORMATION 3,460 FIRE RESISTANCE RATING REQUIREMENTS FIRE RESISTANCE RATING REQUIREMENTS REF - INTERNATIONAL BUILDING CODE - NEW JERSEY EDITION 2015 PRIMARY STRUCTURAL FRAME 2 HR BEARING WALLS EXTERIOR INTERIOR 2 HR NON BEARING WALLS & PARTITIONS X > 30	1004.1.OCCUPAN3,460MORE INFORMATIONRATING REQUIREMENTSING CODE - NEW JERSEY EDITION2015 TAE 601 &60ME2 HREXTERIOR2 HREXTERIOR2 HRRTITIONSX > 30 = 0INTERIOR2 HRECONDARY MEMBERS2 HR	
OCCUPA REA OF WORK 3,460 REFER TO EGRESS PLANS FOR MORE INFORMATION RE RESISTANCE RATING REQUIREMENTS RE RESISTANCE RATING REQUIREMENTS F - INTERNATIONAL BUILDING CODE - NEW JERSEY EDITION AUR ON BEARING WALLS EXTERIOR INTERIOR INTERIOR INTERIOR INTERIOR INTERIOR OC CONSTRUCTION & SECONDARY MEMBERS INTERIOR INTERIOR VALL & CEILING FINISH REQUIREMENT INTERIOR WALL & CEILING FINISH REQUIREMENT INTERNATIONAL BUILDING CODE - NEW JERSEY EDITION 2015 TAI 800F CONSTRUCTION & SECONDARY MEMBERS 1 HR ITERIOR WALL & CEILING FINISH REQUIREMENT INTERNATIONAL BUILDING CODE - NEW JERSEY EDITION 2015 TAI 800F CONSTRUCTION & SECONDARY MEMBERS 1 HR ITERIOR WALL & CEILING FINISH REQUIREMENT F - INTERNATIONAL BUILDING CODE - NEW JERSEY EDITION <td co<="" td=""><td>AREA OF WORKOCCUNOTE: REFER TO EGRESS PLANS FOR MORE INFORMATION3,460FIRE RESISTANCE RATING REQUIREMENTSREF - INTERNATIONAL BUILDING CODE - NEW JERSEY EDITION2015 601PRIMARY STRUCTURAL FRAME2 HRBEARING WALLSEXTERIORINTERIOR2 HRNON BEARING WALLS & PARTITIONSX > 30EXTERIORX > 30</td><td>OCCUPAN 3,460 MORE INFORMATION RATING REQUIREMENTS ING CODE - NEW JERSEY EDITION 2015 TAE 601 & 60 ME 2 HR EXTERIOR 2 HR INTERIOR 2 HR RTITIONS X > 30 = 0 INTERIOR 2 HR ECONDARY MEMBERS 2 HR</td></td>	<td>AREA OF WORKOCCUNOTE: REFER TO EGRESS PLANS FOR MORE INFORMATION3,460FIRE RESISTANCE RATING REQUIREMENTSREF - INTERNATIONAL BUILDING CODE - NEW JERSEY EDITION2015 601PRIMARY STRUCTURAL FRAME2 HRBEARING WALLSEXTERIORINTERIOR2 HRNON BEARING WALLS & PARTITIONSX > 30EXTERIORX > 30</td> <td>OCCUPAN 3,460 MORE INFORMATION RATING REQUIREMENTS ING CODE - NEW JERSEY EDITION 2015 TAE 601 & 60 ME 2 HR EXTERIOR 2 HR INTERIOR 2 HR RTITIONS X > 30 = 0 INTERIOR 2 HR ECONDARY MEMBERS 2 HR</td>	AREA OF WORKOCCUNOTE: REFER TO EGRESS PLANS FOR MORE INFORMATION3,460FIRE RESISTANCE RATING REQUIREMENTSREF - INTERNATIONAL BUILDING CODE - NEW JERSEY EDITION2015 601PRIMARY STRUCTURAL FRAME2 HRBEARING WALLSEXTERIORINTERIOR2 HRNON BEARING WALLS & PARTITIONSX > 30EXTERIORX > 30	OCCUPAN 3,460 MORE INFORMATION RATING REQUIREMENTS ING CODE - NEW JERSEY EDITION 2015 TAE 601 & 60 ME 2 HR EXTERIOR 2 HR INTERIOR 2 HR RTITIONS X > 30 = 0 INTERIOR 2 HR ECONDARY MEMBERS 2 HR
REA OF WORK 3,460 REFER TO EGRESS PLANS FOR MORE INFORMATION RE RESISTANCE RATING REQUIREMENTS PLANS FOR MORE INFORMATION RE RESISTANCE RATING REQUIREMENTS INTERNATIONAL BUILDING CODE - NEW JERSEY EDITION A015 TAI 601 & 601	AREA OF WORK 3,460 NOTE: REFER TO EGRESS PLANS FOR MORE INFORMATION INTERNATIONAL BUILDING CODE - NEW JERSEY EDITION PRIMARY STRUCTURAL BUILDING CODE - NEW JERSEY EDITION 2015 PRIMARY STRUCTURAL FRAME 2 HR BEARING WALLS INTERIOR NON BEARING WALLS & PARTITIONS X > 30	3,460 MORE INFORMATION RATING REQUIREMENTS ING CODE - NEW JERSEY EDITION 2015 TAE 601 & 600 IME 2 HR EXTERIOR 2 INTERIOR 2 HR RTITIONS X > 30 = 0 INTERIOR 2 HR EXTERIOR X > 30 = 0 INTERIOR 2 HR	
INTERIOR WALLS & PARTITIONS REFER TO EGRESS PLANS FOR MORE INFORMATION RE RESISTANCE RATING REQUIREMENTS F - INTERNATIONAL BUILDING CODE - NEW JERSEY EDITION 2015 TAI 601 & 601 INTERNATIONAL BUILDING CODE - NEW JERSEY EDITION INTERIOR	NOTE: REFER TO EGRESS PLANS FOR MORE INFORMATION FIRE RESISTANCE RATING REQUIREMENTS REF - INTERNATIONAL BUILDING CODE - NEW JERSEY EDITION 2015 PRIMARY STRUCTURAL FRAME 2 HR BEARING WALLS EXTERIOR INTERIOR 2 HR NON BEARING WALLS & PARTITIONS X > 30	MORE INFORMATION RATING REQUIREMENTS ING CODE - NEW JERSEY EDITION 2015 TAE 601 & 60 ME 2 HR EXTERIOR 2 INTERIOR 2 HR RTITIONS X > 30 = 0 INTERIOR 2 HR EXTERIOR 2 HR EXTERIOR 2 HR	
RE RESISTANCE RATING REQUIREMENTS F - INTERNATIONAL BUILDING CODE - NEW JERSEY EDITION 2015 TAI 601 &60 IMARY STRUCTURAL FRAME 2 HR ARING WALLS EXTERIOR INTERIOR 2 HR INTERIOR WALL & CEILING FINISH REQUIREMENT ITERIOR WALL & CEILING FINISH REQUIREMENT F - INTERNATIONAL BUILDING CODE - NEW JERSEY EDITION 2015 TAI 803.9 (SPRINKL D) D) IT ENCLOSURES AND EXIT PASSAGEWAYS CLA OOMS AND ENCLOSED SPACES CLA	FIRE RESISTANCE RATING REQUIREMENTS REF - INTERNATIONAL BUILDING CODE - NEW JERSEY EDITION 2015 PRIMARY STRUCTURAL FRAME 2 HR BEARING WALLS EXTERIOR INTERIOR 2 HR NON BEARING WALLS & PARTITIONS X > 30	RATING REQUIREMENTSING CODE - NEW JERSEY EDITION2015 TAE 601 &60ME2 HREXTERIOR2 HREXTERIOR2 HRRTITIONSX > 30 = 0INTERIOR2 HRECONDARY MEMBERS2 HR	
F - INTERNATIONAL BUILDING CODE - NEW JERSEY EDITION 2015 TAI 601 &6 IMARY STRUCTURAL FRAME 2 HR ARING WALLS EXTERIOR INTERIOR 2 HR ON BEARING WALLS & PARTITIONS EXTERIOR INTERIOR 2 HR ON BEARING WALLS & PARTITIONS X > 30 = INTERIOR 2 HR OOR CONSTRUCTION & SECONDARY MEMBERS 2 HR DOF CONSTRUCTION & SECONDARY MEMBERS 1 HR ITERIOR WALL & CEILING FINISH REQUIREMENT 2015 TAI 803.9 F - INTERNATIONAL BUILDING CODE - NEW JERSEY EDITION 2015 TAI 803.9 (SPRINKL D) D) IT ENCLOSURES AND EXIT PASSAGEWAYS CLA OOMS AND ENCLOSED SPACES CLA	REF - INTERNATIONAL BUILDING CODE - NEW JERSEY EDITION 2015 601 PRIMARY STRUCTURAL FRAME 2 HR BEARING WALLS EXTERIOR INTERIOR 2 HR NON BEARING WALLS & PARTITIONS 2 HR EXTERIOR X > 30	ING CODE - NEW JERSEY EDITION2015 TAE 601 &60ME2 HREXTERIOR2 HRINTERIOR2 HRRTITIONSX > 30 = 0INTERIOR2 HRECONDARY MEMBERS2 HR	
601 & 601 &	601 PRIMARY STRUCTURAL FRAME 2 HR BEARING WALLS EXTERIOR INTERIOR 2 HR NON BEARING WALLS & PARTITIONS EXTERIOR X > 30	601 & 60 ME 2 HR EXTERIOR 2 INTERIOR 2 HR RTITIONS X > 30 = 0 INTERIOR 2 HR ECONDARY MEMBERS 2 HR	
IMARY STRUCTURAL FRAME 2 HR ARING WALLS EXTERIOR INTERIOR 2 HR INTERIOR 2 HR INTERIOR WALLS & PARTITIONS EXTERIOR 2 HR OOR CONSTRUCTION & SECONDARY MEMBERS 2 HR OOF CONSTRUCTION & SECONDARY MEMBERS 2 HR OOF CONSTRUCTION & SECONDARY MEMBERS 1 HR ITERIOR WALL & CEILING FINISH REQUIREMENT F - INTERNATIONAL BUILDING CODE - NEW JERSEY EDITION 1 TENCLOSURES AND EXIT PASSAGEWAYS CLA OOMS AND ENCLOSED SPACES CLA	PRIMARY STRUCTURAL FRAME 2 HR BEARING WALLS EXTERIOR INTERIOR 2 HR NON BEARING WALLS & PARTITIONS 2 HR EXTERIOR X > 30	EXTERIOR 2 INTERIOR 2 HR RTITIONS EXTERIOR X > 30 = 0 INTERIOR 2 HR ECONDARY MEMBERS 2 HR	
ARING WALLS EXTERIOR EXTERIOR INTERIOR INTERIOR 2 HR ON BEARING WALLS & PARTITIONS X > 30 = INTERIOR 2 HR OOR CONSTRUCTION & SECONDARY MEMBERS 2 HR OOF CONSTRUCTION & SECONDARY MEMBERS 1 HR ITERIOR WALL & CEILING FINISH REQUIREMENT F - INTERNATIONAL BUILDING CODE - NEW JERSEY EDITION 2015 TAI 803.9 (SPRINKL D) IT ENCLOSURES AND EXIT PASSAGEWAYS CLA OMS AND ENCLOSED SPACES CLA	BEARING WALLS EXTERIOR EXTERIOR INTERIOR INTERIOR 2 HR NON BEARING WALLS & PARTITIONS X > 30	EXTERIOR 2 INTERIOR 2 HR RTITIONS EXTERIOR X > 30 = 0 INTERIOR 2 HR ECONDARY MEMBERS 2 HR	
EXTERIORINTERIOR2 HRINTERIOR2 HRINTERIOREXTERIORX > 30 =INTERIORINTERIOR2 HROOR CONSTRUCTION & SECONDARY MEMBERS2 HROOF CONSTRUCTION & SECONDARY MEMBERS1 HRITERIOR WALL & CEILING FINISH REQUIREMENTF - INTERNATIONAL BUILDING CODE - NEW JERSEY EDITION2015 TAI 803.9 (SPRINKL D)IT ENCLOSURES AND EXIT PASSAGEWAYSCLAOMS AND ENCLOSED SPACESCLA	EXTERIOR INTERIOR 2 HR NON BEARING WALLS & PARTITIONS EXTERIOR X > 30	INTERIOR 2 HR RTITIONS EXTERIOR X > 30 = 0 INTERIOR 2 HR ECONDARY MEMBERS 2 HR	
INTERIOR2 HRINTERIOREXTERIOREXTERIORX > 30 =INTERIOR2 HROOR CONSTRUCTION & SECONDARY MEMBERS2 HRDOF CONSTRUCTION & SECONDARY MEMBERS1 HRITERIOR WALL & CEILING FINISH REQUIREMENTF - INTERNATIONAL BUILDING CODE - NEW JERSEY EDITION2015 TAI 803.9 (SPRINKL D)IT ENCLOSURES AND EXIT PASSAGEWAYSCLAOMS AND ENCLOSED SPACESCLA	INTERIOR 2 HR NON BEARING WALLS & PARTITIONS EXTERIOR X > 30	INTERIOR 2 HR RTITIONS EXTERIOR X > 30 = 0 INTERIOR 2 HR ECONDARY MEMBERS 2 HR	
INTERIOR2 HRINTERIOREXTERIOREXTERIORX > 30 =INTERIOR2 HROOR CONSTRUCTION & SECONDARY MEMBERS2 HRDOF CONSTRUCTION & SECONDARY MEMBERS1 HRITERIOR WALL & CEILING FINISH REQUIREMENTF - INTERNATIONAL BUILDING CODE - NEW JERSEY EDITION2015 TAI 803.9 (SPRINKL D)IT ENCLOSURES AND EXIT PASSAGEWAYSCLAOMS AND ENCLOSED SPACESCLA	INTERIOR 2 HR NON BEARING WALLS & PARTITIONS EXTERIOR X > 30	INTERIOR 2 HR EXTERIOR X > 30 = 0 INTERIOR 2 HR ECONDARY MEMBERS 2 HR	
DN BEARING WALLS & PARTITIONS EXTERIOR X > 30 = INTERIOR 2 HR OOR CONSTRUCTION & SECONDARY MEMBERS 2 HR DOF CONSTRUCTION & SECONDARY MEMBERS 1 HR INTERIOR WALL & CEILING FINISH REQUIREMENT INTERIOR WALL & CEILING FINISH REQUIREMENT INTERNATIONAL BUILDING CODE - NEW JERSEY EDITION 1 TENCLOSURES AND EXIT PASSAGEWAYS ORRIDORS CLA DOMS AND ENCLOSED SPACES CLA	NON BEARING WALLS & PARTITIONS EXTERIOR X > 30	EXTERIOR X > 30 = 0 INTERIOR 2 HR ECONDARY MEMBERS 2 HR	
EXTERIORX > 30 =INTERIOR2 HROOR CONSTRUCTION & SECONDARY MEMBERS2 HROOF CONSTRUCTION & SECONDARY MEMBERS1 HRITERIOR WALL & CEILING FINISH REQUIREMENTF - INTERNATIONAL BUILDING CODE - NEW JERSEY EDITION2015 TAI 803.9 (SPRINKL D)IT ENCLOSURES AND EXIT PASSAGEWAYSCLAORRIDORSCLAOMS AND ENCLOSED SPACESCLA	EXTERIOR X > 30	EXTERIOR X > 30 = 0 INTERIOR 2 HR ECONDARY MEMBERS 2 HR	
INTERIOR 2 HR OOR CONSTRUCTION & SECONDARY MEMBERS 2 HR OOF CONSTRUCTION & SECONDARY MEMBERS 1 HR ITERIOR WALL & CEILING FINISH REQUIREMENT F - INTERNATIONAL BUILDING CODE - NEW JERSEY EDITION 2015 TAI 803.9 (SPRINKL D) IT ENCLOSURES AND EXIT PASSAGEWAYS CLA ORRIDORS CLA		INTERIOR 2 HR ECONDARY MEMBERS 2 HR	
OOR CONSTRUCTION & SECONDARY MEMBERS 2 HR OOF CONSTRUCTION & SECONDARY MEMBERS 1 HR ITERIOR WALL & CEILING FINISH REQUIREMENT F - INTERNATIONAL BUILDING CODE - NEW JERSEY EDITION 2015 TAI 803.9 (SPRINKL D) IT ENCLOSURES AND EXIT PASSAGEWAYS CLA OMS AND ENCLOSED SPACES CLA	INTERIOR 2 HR	ECONDARY MEMBERS 2 HR	
OOF CONSTRUCTION & SECONDARY MEMBERS 1 HR ITERIOR WALL & CEILING FINISH REQUIREMENT F - INTERNATIONAL BUILDING CODE - NEW JERSEY EDITION 2015 TAI 803.9 (SPRINKL D) IT ENCLOSURES AND EXIT PASSAGEWAYS CLA ORRIDORS CLA DOMS AND ENCLOSED SPACES CLA			
ITERIOR WALL & CEILING FINISH REQUIREMENT F - INTERNATIONAL BUILDING CODE - NEW JERSEY EDITION 2015 TAI 803.9 (SPRINKL D) IT ENCLOSURES AND EXIT PASSAGEWAYS CLA ORRIDORS CLA DOMS AND ENCLOSED SPACES CLA	FLOOR CONSTRUCTION & SECONDARY MEMBERS 2 HR		
F - INTERNATIONAL BUILDING CODE - NEW JERSEY EDITION 2015 TAI 803.9 (SPRINKL D) IT ENCLOSURES AND EXIT PASSAGEWAYS CLA ORRIDORS CLA DOMS AND ENCLOSED SPACES CLA	ROOF CONSTRUCTION & SECONDARY MEMBERS 1 HR		
F - INTERNATIONAL BUILDING CODE - NEW JERSEY EDITION 2015 TAI 803.9 (SPRINKL D) IT ENCLOSURES AND EXIT PASSAGEWAYS CLA ORRIDORS CLA DOMS AND ENCLOSED SPACES CLA			
803.9 (SPRINKL D) IT ENCLOSURES AND EXIT PASSAGEWAYS CLA DRRIDORS CLA DOMS AND ENCLOSED SPACES	INTERIOR WALL & CEILING FINISH REQUIREIVIEN		
IT ENCLOSURES AND EXIT PASSAGEWAYS CLA DRRIDORS CLA DOMS AND ENCLOSED SPACES CLA			
D) IT ENCLOSURES AND EXIT PASSAGEWAYS ORRIDORS OOMS AND ENCLOSED SPACES CLA			
IT ENCLOSURES AND EXIT PASSAGEWAYS CLA ORRIDORS CLA DOMS AND ENCLOSED SPACES CLA		803.9	
ORRIDORS CLA OOMS AND ENCLOSED SPACES CLA		803.9 (SPRINKLI	
OOMS AND ENCLOSED SPACES CLA		803.9 (SPRINKLI D)	
		803.9 (SPRINKLI D) T PASSAGEWAYS CLAS	
UMBING FIXTURE CALCULATION		803.9 (SPRINKLI D) T PASSAGEWAYS CLAS	
	PLUMBING FIXTURE CALCULATION	803.9 (SPRINKLI D) T PASSAGEWAYS CLAS ACES	
		803.9 (SPRINKLI D) T PASSAGEWAYS CLAS ACES	
		803.9 (SPRINKLI D) T PASSAGEWAYS CLAS CLAS ACES CLAS	
	WATER CLOSETS PROVIDED	803.9 (SPRINKLI D) T PASSAGEWAYS CLAS PLUMBING CODE 2015 TAE	
7.21.1	1	803.9 (SPRINKLI D) T PASSAGEWAYS CLAS ACES CLAS RE CALCULATION PLUMBING CODE 2015 TAE 7.21.1	
ATER CLOSETS PROVIDED		803.9 (SPRINKLI D) T PASSAGEWAYS CLAS ACES CLAS RE CALCULATION PLUMBING CODE 2015 TAE 7.21.1	
ATER CLOSETS PROVIDED MEN 24		803.9 (SPRINKLI D) T PASSAGEWAYS CLAS ACES CLAS MEN 24	
TER CLOSETS PROVIDED 7.21.7 MEN 24 WOMEN 32	WOMEN 32	803.9 (SPRINKLID) T PASSAGEWAYS CLAS CLAS ACES CLAS MEN 24	
TATER CLOSETS PROVIDED 7.21.7 MEN 24 WOMEN 32 VATORIES PROVIDED 1000000000000000000000000000000000000	WOMEN 32 LAVATORIES PROVIDED	803.9 (SPRINKLID) T PASSAGEWAYS CLAS ACES CLAS QUISTAN PLUMBING CODE 2015 TAN 7.21.1 D MEN 24 WOMEN 32	
TER CLOSETS PROVIDED 7.21.7 MEN 24 WOMEN 32	WOMEN 32 LAVATORIES PROVIDED	803.9 (SPRINKLI D) T PASSAGEWAYS CLAS ACES CLAS QUISTAN PLUMBING CODE 2015 TAN 7.21.1 D MEN QUISTAN WOMEN 32	
TATER CLOSETS PROVIDED 7.21.7 MEN 24 WOMEN 32 VATORIES PROVIDED 1000000000000000000000000000000000000	WOMEN 32 LAVATORIES PROVIDED MEN 20	803.9 (SPRINKLI D) T PASSAGEWAYS CLAS ACES CLAS RE CALCULATION PLUMBING CODE 2015 TAE 7.21.1 MEN 24 WOMEN 32	
7.21.* ATER CLOSETS PROVIDED MEN 24 WOMEN 32 VATORIES PROVIDED MEN 20 WOMEN 24	WOMEN 32 LAVATORIES PROVIDED MEN 20	803.9 (SPRINKLI D) T PASSAGEWAYS CLAS ACES CLAS MEN 20 WOMEN 24	
7.21.* ATER CLOSETS PROVIDED MEN 24 WOMEN 32 VATORIES PROVIDED MEN 20 WOMEN 24 NKING FOUNTAIN NOT PROVIDED - EXCEPTIONS WHEN DRINKING WATER SERVICE IS AVAILABLE	WOMEN 32 LAVATORIES PROVIDED MEN 20 WOMEN 24 DRINKING FOUNTAIN NOT PROVIDED - EXCEPTIONS WHEN DRINKING WATER SERVICE IS AVAILABLE	803.9 (SPRINKLI D) T PASSAGEWAYS CLAS ACES CLAS Q0 WOMEN Q0 WOMEN Q0 WOMEN Q1 WOMEN Q2	
T.21.* ATER CLOSETS PROVIDED MEN 24 WOMEN 32 VATORIES PROVIDED MEN 20 WOMEN 24 24 NKING FOUNTAIN NOT PROVIDED - EXCEPTIONS WHEN DRINKING WATER SERVICE IS AVAILABLE ORTABLE FIRE EXTINGUISHERS	WOMEN 32 LAVATORIES PROVIDED MEN 20 MEN 24 DRINKING FOUNTAIN NOT PROVIDED - EXCEPTIONS WHEN DRINKING WATER SERVICE IS AVAILABLE PORTABLE FIRE EXTINGUISHERS	803.9 (SPRINKLI D) T PASSAGEWAYS CLAS ACES CLAS PLUMBING CODE 2015 TAE WOMEN 20 WOMEN 24 WOMEN 24 EXCEPTIONS WHEN DRINKING WATER SERVICE IS AVAILABLE CTINGUISHERS	
T.21.* ATER CLOSETS PROVIDED MEN 24 WOMEN 32 VATORIES PROVIDED MEN 20 WOMEN 24 NKING FOUNTAIN NOT PROVIDED - EXCEPTIONS WHEN DRINKING WATER SERVICE IS AVAILABLE DRTABLE FIRE EXTINGUISHERS F - INTERNATIONAL BUILDING CODE - NEW JERSEY EDITION 2015 TAI	WOMEN 32 LAVATORIES PROVIDED MEN 20 WOMEN 24 WOMEN DRINKING FOUNTAIN NOT PROVIDED - EXCEPTIONS WHEN DRINKING WATER SERVICE IS AVAILABLE PORTABLE FIRE EXTINGUISHERS REF - INTERNATIONAL BUILDING CODE - NEW JERSEY EDITION 2015	803.9 (SPRINKLID) T PASSAGEWAYS CLAS QUIDING CODE 2015 TAB QUIDING CODE - NEW JERSEY EDITION 2015 TAB	
ATER CLOSETS PROVIDED MEN 24 MEN 24 WOMEN 32 VATORIES PROVIDED MEN 20 WOMEN 24 WOMEN 24 NKING FOUNTAIN NOT PROVIDED - EXCEPTIONS WHEN DRINKING WATER SERVICE IS AVAILABLE ORTABLE FIRE EXTINGUISHERS FF - INTERNATIONAL BUILDING CODE - NEW JERSEY EDITION 2015 TAI 906.3(1)	WOMEN 32 LAVATORIES PROVIDED MEN 20 WOMEN 24 WOMEN DRINKING FOUNTAIN NOT PROVIDED - EXCEPTIONS WHEN DRINKING WATER SERVICE IS AVAILABLE PORTABLE FIRE EXTINGUISHERS REF - INTERNATIONAL BUILDING CODE - NEW JERSEY EDITION 2015 906	803.9 (SPRINKLI) D) T PASSAGEWAYS CLAS ACES CLAS RE CALCULATION PLUMBING CODE 2015 TAB 7.21.1 D MEN 24 WOMEN 32 MEN 20 WOMEN 21 WOMEN 22 MEN 20 WOMEN 22 WOMEN 24 EXCEPTIONS WHEN DRINKING WATER SERVICE IS AVAILABLE CTINGUISHERS DING CODE - NEW JERSEY EDITION 2015 TAB 906.3(1	
ATER CLOSETS PROVIDED MEN 24 MEN 24 WOMEN 32 VATORIES PROVIDED MEN 20 WOMEN 24 NKING FOUNTAIN NOT PROVIDED - EXCEPTIONS WHEN DRINKING WATER SERVICE IS AVAILABLE ORTABLE FIRE EXTINGUISHERS F - INTERNATIONAL BUILDING CODE - NEW JERSEY EDITION 2015 TAI 906.3(1) GHT (LOW) HAZARD OCCUPANCY 1	WOMEN 32 LAVATORIES PROVIDED MEN 20 20 WOMEN 24 DRINKING FOUNTAIN NOT PROVIDED - EXCEPTIONS WHEN DRINKING WATER SERVICE IS AVAILABLE PORTABLE FIRE EXTINGUISHERS REF - INTERNATIONAL BUILDING CODE - NEW JERSEY EDITION 2015 906 LIGHT (LOW) HAZARD OCCUPANCY 2015	803.9 (SPRINKLID) T PASSAGEWAYS CLAS ACES CLAS RE CALCULATION PLUMBING CODE 2015 TAB 7.21.1 MEN 24 WOMEN 32 MEN 24 WOMEN 24 EXCEPTIONS WHEN DRINKING WATER SERVICE IS AVAILABLE CTINGUISHERS DING CODE - NEW JERSEY EDITION 2015 TAB 906.3(1	
ATER CLOSETS PROVIDED MEN 24 MEN 24 WOMEN 32 VATORIES PROVIDED MEN 20 WOMEN 24 NKING FOUNTAIN NOT PROVIDED - EXCEPTIONS WHEN DRINKING WATER SERVICE IS AVAILABLE ORTABLE FIRE EXTINGUISHERS F - INTERNATIONAL BUILDING CODE - NEW JERSEY EDITION 2015 TAI 906.3(1) GHT (LOW) HAZARD OCCUPANCY 1	WOMEN 32 LAVATORIES PROVIDED MEN 20 WOMEN 24 WOMEN DRINKING FOUNTAIN NOT PROVIDED - EXCEPTIONS WHEN DRINKING WATER SERVICE IS AVAILABLE PORTABLE FIRE EXTINGUISHERS REF - INTERNATIONAL BUILDING CODE - NEW JERSEY EDITION 2015 906	803.9 (SPRINKLID) T PASSAGEWAYS CLAS ACES CLAS RE CALCULATION PLUMBING CODE 2015 TAE 7.21.1 MEN 24 WOMEN 32 MEN 24 WOMEN 24 EXCEPTIONS WHEN DRINKING WATER SERVICE IS AVAILABLE CTINGUISHERS DING CODE - NEW JERSEY EDITION 2015 TAE 906.3(1	
T.21.* ATER CLOSETS PROVIDED MEN 24 WOMEN 32 VATORIES PROVIDED MEN 20 WOMEN 24 NKING FOUNTAIN NOT PROVIDED - EXCEPTIONS WHEN DRINKING WATER SERVICE IS AVAILABLE ORTABLE FIRE EXTINGUISHERS F - INTERNATIONAL BUILDING CODE - NEW JERSEY EDITION 2015 TAI 906.3(1) OHT (LOW) HAZARD OCCUPANCY NIMUM RATED SINGLE EXTINGUISHER 111111111111111111111111111111111111	WOMEN 32 LAVATORIES PROVIDED MEN 20 MEN 24 DRINKING FOUNTAIN NOT PROVIDED - EXCEPTIONS WHEN DRINKING WATER SERVICE IS AVAILABLE PORTABLE FIRE EXTINGUISHERS REF - INTERNATIONAL BUILDING CODE - NEW JERSEY EDITION 2015 JUIGHT (LOW) HAZARD OCCUPANCY MINIMUM RATED SINGLE EXTINGUISHER International extension	803.9 (SPRINKLI D) T PASSAGEWAYS CLAS CLAS CLAS ACES CLAS RE CALCULATION 2015 TAE PLUMBING CODE 2015 TAE 7.21.1 20 MEN 24 WOMEN 32 MEN 20 WOMEN 24 EXCEPTIONS WHEN DRINKING WATER SERVICE IS AVAILABLE CTINGUISHERS 2015 TAE DING CODE - NEW JERSEY EDITION 2015 TAE JPANCY 11NGUISHER	
T.21.* ATER CLOSETS PROVIDED MEN 24 WOMEN 32 VATORIES PROVIDED MEN 20 WOMEN 24 NKING FOUNTAIN NOT PROVIDED - EXCEPTIONS WHEN DRINKING WATER SERVICE IS AVAILABLE ORTABLE FIRE EXTINGUISHERS F - INTERNATIONAL BUILDING CODE - NEW JERSEY EDITION 2015 TAI 906.3(13) OHT (LOW) HAZARD OCCUPANCY NIMUM RATED SINGLE EXTINGUISHER 3,00 XIMUM FLOOR AREA PER UNIT OF A 3,00	WOMEN 32 LAVATORIES PROVIDED MEN 20 MEN 24 WOMEN DRINKING FOUNTAIN NOT PROVIDED - EXCEPTIONS WHEN DRINKING WATER SERVICE IS AVAILABLE PORTABLE FIRE EXTINGUISHERS REF - INTERNATIONAL BUILDING CODE - NEW JERSEY EDITION 2015 906 LIGHT (LOW) HAZARD OCCUPANCY MINIMUM RATED SINGLE EXTINGUISHER MAXIMUM FLOOR AREA PER UNIT OF A	803.9 (SPRINKLI D) T T PASSAGEWAYS CLAS CLAS ACES CLAS RE 2015 RE 20 WOMEN 24 EXCEPTIONS WHEN DRINKING WATER SERVICE IS AVAILABLE CE MEN QUING CODE - NEW JERSEY EDITION 2015 VINGUISHER 20 RUNIT OF A 3,000	
7.21.* ATER CLOSETS PROVIDED MEN 24 WOMEN 32 VATORIES PROVIDED MEN 20 WOMEN 24 NKING FOUNTAIN NOT PROVIDED - EXCEPTIONS WHEN DRINKING WATER SERVICE IS AVAILABLE 20 ORTABLE FIRE EXTINGUISHER 2015 TAI 906.3(1 GHT (LOW) HAZARD OCCUPANCY 2015 TAI 906.3(1 NIMUM RATED SINGLE EXTINGUISHER 3,000 XIMUM FLOOR AREA PER UNIT OF A 3,000 XIMUM FLORR AREA FOR EXTINGUISHERb 11,25	WOMEN32LAVATORIES PROVIDEDMEN20MEN24WOMENDRINKING FOUNTAIN NOT PROVIDED - EXCEPTIONS WHEN DRINKING WATER SERVICE IS AVAILABLEPORTABLE FIRE EXTINGUISHERSREF - INTERNATIONAL BUILDING CODE - NEW JERSEY EDITION2015906LIGHT (LOW) HAZARD OCCUPANCYMINIMUM RATED SINGLE EXTINGUISHERMAXIMUM FLOOR AREA PER UNIT OF A03MAXIMUM FLORR AREA FOR EXTINGUISHERb	803.9 (SPRINKLI D) T PASSAGEWAYS CLAS CLAS CLAS ACES CLAS RE CALCULATION 2015 TAB PLUMBING CODE 2015 TAB 7.21.1 7.21.1 MEN 24 WOMEN 32 MEN 20 WOMEN 24 EXCEPTIONS WHEN DRINKING WATER SERVICE IS AVAILABLE KTINGUISHERS 2015 TAB 906.3(1 JPANCY TINGUISHER 20 QUIT OF A 3,000 EXTINGUISHERb 11,250	
7.21.* ATER CLOSETS PROVIDED MEN 24 WOMEN 32 VATORIES PROVIDED MEN 20 WOMEN 24 NKING FOUNTAIN NOT PROVIDED - EXCEPTIONS WHEN DRINKING WATER SERVICE IS AVAILABLE 20 ORTABLE FIRE EXTINGUISHER 2015 TAI 906.3(2015 TAI ORTABLE SINGLE EXTINGUISHER 2015 TAI WIMUM RATED SINGLE EXTINGUISHER 2015 TAI XIMUM FLOOR AREA PER UNIT OF A 3,000 XIMUM FLORR AREA FOR EXTINGUISHERb 11,25	WOMEN32LAVATORIES PROVIDEDMEN20MEN21WOMEN24WOMENDRINKING FOUNTAIN NOT PROVIDED - EXCEPTIONS WHEN DRINKING WATER SERVICE IS AVAILABLEPORTABLE FIRE EXTINGUISHERSREF - INTERNATIONAL BUILDING CODE - NEW JERSEY EDITION2015906LIGHT (LOW) HAZARD OCCUPANCYMINIMUM RATED SINGLE EXTINGUISHERMAXIMUM FLOOR AREA PER UNIT OF A33MAXIMUM FLORR AREA FOR EXTINGUISHERb11MAXIMUM TRAVEL DISTANCE TO EXTINGUISHER	803.9 (SPRINKLI D) T PASSAGEWAYS CLAS CLAS CLAS ACES CLAS RE CALCULATION 2015 TAB PLUMBING CODE 2015 TAB 7.21.1 7.21.1 MEN 24 WOMEN 32 MEN 24 WOMEN 24 EXCEPTIONS WHEN DRINKING WATER SERVICE IS AVAILABLE TINGUISHERS 2015 TAB DING CODE - NEW JERSEY EDITION 2015 TAB DING CODE - NEW JERSEY EDITION 2015 TAB 906.3(1 906.3(1 JPANCY 20 TINGUISHER 23 RUNIT OF A 3,000 REXTINGUISHER 75 F	
	PLUMBING FIXTURE CALCULATION REF - NATIONAL STANDARD PLUMBING CODE 20 WATER CLOSETS PROVIDED	T PASSAGEWAYS	
		803.9 (SPRINKL D) T PASSAGEWAYS CLA ACES CLA RE CALCULATION PLUMBING CODE 2015 TAB	
7.21.1	WATER CLOSETS PROVIDED	803.9 (SPRINKLD) T PASSAGEWAYS CLA CLA ACES CLA RE CALCULATION PLUMBING CODE 2015 TAE 7.21.1	
7.21.1	MENI 24	803.9 (SPRINKLD) T PASSAGEWAYS CLA CLA ACES CLA RE CALCULATION PLUMBING CODE 2015 TAE 7.21.1	
ATER CLOSETS PROVIDED		803.9 (SPRINKL D) T PASSAGEWAYS CLA ACES CLAS RE CALCULATION PLUMBING CODE 2015 TAE 7.21.1	
ATER CLOSETS PROVIDED MEN 24		803.9 (SPRINKL D) T PASSAGEWAYS CLAS ACES CLAS MEN Z4	
TER CLOSETS PROVIDED 7.21.7 MEN 24 WOMEN 32	WOMEN 32	803.9 (SPRINKL D) T PASSAGEWAYS CLAS ACES CLAS MEN Z4	
TER CLOSETS PROVIDED 7.21.7 MEN 24 WOMEN 32	WOMEN 32	803.9 (SPRINKL D) T PASSAGEWAYS CLA ACES CLA MEN 24	
TATER CLOSETS PROVIDED 7.21.7 MEN 24 WOMEN 32 VATORIES PROVIDED 1000000000000000000000000000000000000	WOMEN 32 LAVATORIES PROVIDED	803.9 (SPRINKL D) T PASSAGEWAYS CLA ACES CLAS RE CALCULATION PLUMBING CODE 2015 TAB 7.21.1 D MEN 24 WOMEN 32	
TATER CLOSETS PROVIDED MEN 24 WOMEN 32 VATORIES PROVIDED MEN 20	WOMEN 32 LAVATORIES PROVIDED MEN 20	803.9 (SPRINKL D) T PASSAGEWAYS CLA ACES CLAS RE CALCULATION PLUMBING CODE 2015 TAE 7.21.1 MEN 24 WOMEN 32	
TATER CLOSETS PROVIDED MEN 24 WOMEN 32 VATORIES PROVIDED MEN 20	WOMEN 32 LAVATORIES PROVIDED MEN 20	803.9 (SPRINKL D) T PASSAGEWAYS CLA ACES CLAS RE CALCULATION PLUMBING CODE 2015 TAE 7.21.1 MEN 24 WOMEN 32	
7.21.* ATER CLOSETS PROVIDED MEN 24 WOMEN 32 VATORIES PROVIDED MEN 20 WOMEN 24	WOMEN 32 LAVATORIES PROVIDED MEN 20 WOMEN 24	803.9 (SPRINKL D) T PASSAGEWAYS CLA ACES CLAS PLUMBING CODE 2015 TAS MEN 20 WOMEN 24	
7.21.* ATER CLOSETS PROVIDED MEN 24 WOMEN 32 VATORIES PROVIDED MEN 20 WOMEN 24 NKING FOUNTAIN NOT PROVIDED - EXCEPTIONS WHEN DRINKING WATER SERVICE IS AVAILABLE	WOMEN 32 LAVATORIES PROVIDED MEN Q0 20 WOMEN 24 DRINKING FOUNTAIN NOT PROVIDED - EXCEPTIONS WHEN DRINKING WATER SERVICE IS AVAILABLE	803.9 (SPRINKL D) T PASSAGEWAYS CLA ACES CLA RE CALCULATION PLUMBING CODE 2015 TAI 7.21.7 MEN 24 WOMEN 32 MEN 20 WOMEN 24 EXCEPTIONS WHEN DRINKING WATER SERVICE IS AVAILABLE	
7.21.* ATER CLOSETS PROVIDED MEN 24 WOMEN 32 VATORIES PROVIDED MEN 20 WOMEN 24 NKING FOUNTAIN NOT PROVIDED - EXCEPTIONS WHEN DRINKING WATER SERVICE IS AVAILABLE	WOMEN 32 LAVATORIES PROVIDED MEN Q0 20 WOMEN 24 DRINKING FOUNTAIN NOT PROVIDED - EXCEPTIONS WHEN DRINKING WATER SERVICE IS AVAILABLE	803.9 (SPRINKL D) T PASSAGEWAYS CLA ACES CLA PLUMBING CODE 2015 TAI MEN 20 WOMEN 24 WOMEN 24 EXCEPTIONS WHEN DRINKING WATER SERVICE IS AVAILABLE	
T.21. ATER CLOSETS PROVIDED MEN 24 WOMEN 32 VATORIES PROVIDED MEN 20 WOMEN 24 24 NKING FOUNTAIN NOT PROVIDED - EXCEPTIONS WHEN DRINKING WATER SERVICE IS AVAILABLE TORTABLE FIRE EXTINGUISHERS	WOMEN 32 LAVATORIES PROVIDED MEN 20 WOMEN 24 DRINKING FOUNTAIN NOT PROVIDED - EXCEPTIONS WHEN DRINKING WATER SERVICE IS AVAILABLE PORTABLE FIRE EXTINGUISHERS Image: Comparison of the service is available of t	803.6 (SPRINKL D) T PASSAGEWAYS CLA ACES CLA PLUMBING CODE 2015 TA 7.21.70 MEN MEN 20 WOMEN 24 WOMEN 24 EXCEPTIONS WHEN DRINKING WATER SERVICE IS AVAILABLE CTINGUISHERS	
T.21.* ATER CLOSETS PROVIDED MEN 24 WOMEN 32 VATORIES PROVIDED MEN 20 WOMEN 24 NKING FOUNTAIN NOT PROVIDED - EXCEPTIONS WHEN DRINKING WATER SERVICE IS AVAILABLE DRTABLE FIRE EXTINGUISHERS F - INTERNATIONAL BUILDING CODE - NEW JERSEY EDITION 2015 TAI	WOMEN 32 LAVATORIES PROVIDED MEN MEN 20 WOMEN 24 DRINKING FOUNTAIN NOT PROVIDED - EXCEPTIONS WHEN DRINKING WATER SERVICE IS AVAILABLE PORTABLE FIRE EXTINGUISHERS REF - INTERNATIONAL BUILDING CODE - NEW JERSEY EDITION 2015	803.9 (SPRINKL D) T PASSAGEWAYS CLA ACES CLA CLA ACES CLA RE CALCULATION PLUMBING CODE 2015 TAI 7.21.1 D MEN 24 WOMEN 32 MEN 20 WOMEN 24 WOMEN 20 WOMEN 24 EXCEPTIONS WHEN DRINKING WATER SERVICE IS AVAILABLE CTINGUISHERS DING CODE - NEW JERSEY EDITION 2015 TAI	
ATER CLOSETS PROVIDED MEN 24 MEN 24 WOMEN 32 VATORIES PROVIDED MEN 20 WOMEN 24 24 NKING FOUNTAIN NOT PROVIDED - EXCEPTIONS WHEN DRINKING WATER SERVICE IS AVAILABLE ORTABLE FIRE EXTINGUISHERS F - INTERNATIONAL BUILDING CODE - NEW JERSEY EDITION 2015 TAI	WOMEN 32 LAVATORIES PROVIDED MEN MEN 20 WOMEN 24 DRINKING FOUNTAIN NOT PROVIDED - EXCEPTIONS WHEN DRINKING WATER SERVICE IS AVAILABLE PORTABLE FIRE EXTINGUISHERS REF - INTERNATIONAL BUILDING CODE - NEW JERSEY EDITION 2015	803.9 (SPRINKL D) T PASSAGEWAYS CLA ACES CLA RE CALCULATION PLUMBING CODE 2015 TAI 7.21.7 MEN 24 WOMEN 32 MEN 24 WOMEN 24 WOMEN 24 EXCEPTIONS WHEN DRINKING WATER SERVICE IS AVAILABLE CTINGUISHERS DING CODE - NEW JERSEY EDITION 2015 TAI 2015 TAI 7.21.7	
ATER CLOSETS PROVIDED MEN 24 MEN 24 WOMEN 32 VATORIES PROVIDED MEN 20 WOMEN 24 WOMEN 24 NKING FOUNTAIN NOT PROVIDED - EXCEPTIONS WHEN DRINKING WATER SERVICE IS AVAILABLE ORTABLE FIRE EXTINGUISHERS FF - INTERNATIONAL BUILDING CODE - NEW JERSEY EDITION 2015 TAI 906.3(WOMEN 32 LAVATORIES PROVIDED MEN 20 WOMEN 24 WOMEN DRINKING FOUNTAIN NOT PROVIDED - EXCEPTIONS WHEN DRINKING WATER SERVICE IS AVAILABLE PORTABLE FIRE EXTINGUISHERS REF - INTERNATIONAL BUILDING CODE - NEW JERSEY EDITION 2015 906	803.9 (SPRINKL D) T PASSAGEWAYS CLA ACES CLA RE CALCULATION PLUMBING CODE 2015 TAI 7.21.* D MEN 24 WOMEN 32 MEN 24 WOMEN 24 EXCEPTIONS WHEN DRINKING WATER SERVICE IS AVAILABLE CTINGUISHERS DING CODE - NEW JERSEY EDITION 2015 TAI 906.3(
ATER CLOSETS PROVIDED MEN 24 MEN 24 WOMEN 32 VATORIES PROVIDED MEN 20 WOMEN 24 WOMEN 24 NKING FOUNTAIN NOT PROVIDED - EXCEPTIONS WHEN DRINKING WATER SERVICE IS AVAILABLE ORTABLE FIRE EXTINGUISHERS FF - INTERNATIONAL BUILDING CODE - NEW JERSEY EDITION 2015 TAI 906.3(1)	WOMEN 32 LAVATORIES PROVIDED MEN MEN 20 WOMEN 24 DRINKING FOUNTAIN NOT PROVIDED - EXCEPTIONS WHEN DRINKING WATER SERVICE IS AVAILABLE PORTABLE FIRE EXTINGUISHERS REF - INTERNATIONAL BUILDING CODE - NEW JERSEY EDITION 2015 906 906	803.9 (SPRINKL D) T PASSAGEWAYS CLA ACES CLA RE CALCULATION PLUMBING CODE 2015 TAI 7.21.* MEN 24 WOMEN 32 MEN 20 WOMEN 24 WOMEN 24 EXCEPTIONS WHEN DRINKING WATER SERVICE IS AVAILABLE CING CODE - NEW JERSEY EDITION 2015 TAI 906.3(1)	
ATER CLOSETS PROVIDED MEN 24 MEN 24 WOMEN 32 VATORIES PROVIDED MEN 20 WOMEN 24 NKING FOUNTAIN NOT PROVIDED - EXCEPTIONS WHEN DRINKING WATER SERVICE IS AVAILABLE ORTABLE FIRE EXTINGUISHERS F - INTERNATIONAL BUILDING CODE - NEW JERSEY EDITION 2015 TAI 906.3(GHT (LOW) HAZARD OCCUPANCY 2015 TAI 906.3(WOMEN 32 LAVATORIES PROVIDED MEN 20 20 WOMEN 24 DRINKING FOUNTAIN NOT PROVIDED - EXCEPTIONS WHEN DRINKING WATER SERVICE IS AVAILABLE PORTABLE FIRE EXTINGUISHERS REF - INTERNATIONAL BUILDING CODE - NEW JERSEY EDITION 2015 906 LIGHT (LOW) HAZARD OCCUPANCY 2015	803.9 (SPRINKL D) T PASSAGEWAYS CLA ACES CLA RE CALCULATION PLUMBING CODE 2015 TAI 7.21.* D MEN 24 WOMEN 32 MEN 20 WOMEN 24 WOMEN 24 WOMEN 22 MEN 20 WOMEN 24 WOMEN 24 EXCEPTIONS WHEN DRINKING WATER SERVICE IS AVAILABLE CTINGUISHERS DING CODE - NEW JERSEY EDITION 2015 TAI 906.3(JPANCY	
ATER CLOSETS PROVIDED MEN 24 MEN 24 WOMEN 32 VATORIES PROVIDED MEN 20 WOMEN 24 NKING FOUNTAIN NOT PROVIDED - EXCEPTIONS WHEN DRINKING WATER SERVICE IS AVAILABLE ORTABLE FIRE EXTINGUISHERS F - INTERNATIONAL BUILDING CODE - NEW JERSEY EDITION 2015 TAI 906.3(GHT (LOW) HAZARD OCCUPANCY 2015 TAI 906.3(WOMEN 32 LAVATORIES PROVIDED MEN 20 20 WOMEN 24 DRINKING FOUNTAIN NOT PROVIDED - EXCEPTIONS WHEN DRINKING WATER SERVICE IS AVAILABLE PORTABLE FIRE EXTINGUISHERS REF - INTERNATIONAL BUILDING CODE - NEW JERSEY EDITION 2015 906 LIGHT (LOW) HAZARD OCCUPANCY 2015	803.9 (SPRINKL D) T PASSAGEWAYS CLA ACES CLA RE CALCULATION PLUMBING CODE 2015 TAI 7.21.* D MEN 24 WOMEN 32 MEN 20 WOMEN 24 WOMEN 24 WOMEN 22 MEN 20 WOMEN 24 WOMEN 24 EXCEPTIONS WHEN DRINKING WATER SERVICE IS AVAILABLE CTINGUISHERS DING CODE - NEW JERSEY EDITION 2015 TAI 906.3(JPANCY	
T.21. ATER CLOSETS PROVIDED MEN 24 WOMEN 32 VATORIES PROVIDED MEN 20 WOMEN 24 NKING FOUNTAIN NOT PROVIDED - EXCEPTIONS WHEN DRINKING WATER SERVICE IS AVAILABLE DRTABLE FIRE EXTINGUISHERS F - INTERNATIONAL BUILDING CODE - NEW JERSEY EDITION 2015 TAI 906.3(GHT (LOW) HAZARD OCCUPANCY NIMUM RATED SINGLE EXTINGUISHER	WOMEN 32 LAVATORIES PROVIDED MEN 20 MEN 24 WOMEN DRINKING FOUNTAIN NOT PROVIDED - EXCEPTIONS WHEN DRINKING WATER SERVICE IS AVAILABLE PORTABLE FIRE EXTINGUISHERS REF - INTERNATIONAL BUILDING CODE - NEW JERSEY EDITION 2015 906 LIGHT (LOW) HAZARD OCCUPANCY MINIMUM RATED SINGLE EXTINGUISHER	803.9 (SPRINKL D) T PASSAGEWAYS CLA CLA CLA ACES CLA RE CALCULATION 2015 TAI PLUMBING CODE 2015 TAI 7.21.* 0 MEN 24 WOMEN 32 MEN 24 EXCEPTIONS WHEN DRINKING WATER SERVICE IS AVAILABLE CING CODE - NEW JERSEY EDITION 2015 TAI 906.3(IPANCY TINGUISHER	
T.21. ATER CLOSETS PROVIDED MEN 24 WOMEN 32 VATORIES PROVIDED MEN 20 WOMEN 24 NKING FOUNTAIN NOT PROVIDED - EXCEPTIONS WHEN DRINKING WATER SERVICE IS AVAILABLE DRTABLE FIRE EXTINGUISHERS F - INTERNATIONAL BUILDING CODE - NEW JERSEY EDITION 2015 TAI 906.3(GHT (LOW) HAZARD OCCUPANCY NIMUM RATED SINGLE EXTINGUISHER	WOMEN 32 LAVATORIES PROVIDED MEN 20 MEN 24 WOMEN DRINKING FOUNTAIN NOT PROVIDED - EXCEPTIONS WHEN DRINKING WATER SERVICE IS AVAILABLE PORTABLE FIRE EXTINGUISHERS REF - INTERNATIONAL BUILDING CODE - NEW JERSEY EDITION 2015 906 LIGHT (LOW) HAZARD OCCUPANCY MINIMUM RATED SINGLE EXTINGUISHER Image: Colspan="2">Colspan="2">COLSPANCY	803.9 (SPRINKL D) T PASSAGEWAYS CLA CLA CLA ACES CLA RE CALCULATION 2015 TAI PLUMBING CODE 2015 TAI 7.21.* 0 MEN 24 WOMEN 32 MEN 24 EXCEPTIONS WHEN DRINKING WATER SERVICE IS AVAILABLE CING CODE - NEW JERSEY EDITION 2015 TAI 906.3(IPANCY TINGUISHER	
7.21.* ATER CLOSETS PROVIDED MEN 24 WOMEN 32 VATORIES PROVIDED MEN 20 WOMEN 24 NKING FOUNTAIN NOT PROVIDED - EXCEPTIONS WHEN DRINKING WATER SERVICE IS AVAILABLE ORTABLE FIRE EXTINGUISHERS F - INTERNATIONAL BUILDING CODE - NEW JERSEY EDITION 2015 TAI 906.3(OHT (LOW) HAZARD OCCUPANCY NIMUM RATED SINGLE EXTINGUISHER 3,00 XIMUM FLOOR AREA PER UNIT OF A 3,00	WOMEN32LAVATORIES PROVIDEDMEN20MEN21WOMEN24WOMENDRINKING FOUNTAIN NOT PROVIDED - EXCEPTIONS WHEN DRINKING WATER SERVICE IS AVAILABLEPORTABLE FIRE EXTINGUISHERSREF - INTERNATIONAL BUILDING CODE - NEW JERSEY EDITION2015906LIGHT (LOW) HAZARD OCCUPANCYMINIMUM RATED SINGLE EXTINGUISHERMAXIMUM FLOOR AREA PER UNIT OF A3	803.9 (SPRINKL D) T PASSAGEWAYS CLA ACES CLA RE CALCULATION PLUMBING CODE 2015 TAI 7.21.* D MEN 24 WOMEN 32 MEN 24 WOMEN 32 MEN 24 WOMEN 22 MEN 24 WOMEN 24 EXCEPTIONS WHEN DRINKING WATER SERVICE IS AVAILABLE CTINGUISHERS DING CODE - NEW JERSEY EDITION 2015 TAI 906.3(JPANCY TINGUISHER 2015 TAI 3,00	
7.21. ATER CLOSETS PROVIDED MEN 24 WOMEN 32 VATORIES PROVIDED MEN 20 WOMEN 24 NKING FOUNTAIN NOT PROVIDED - EXCEPTIONS WHEN DRINKING WATER SERVICE IS AVAILABLE 20 ORTABLE FIRE EXTINGUISHERS 2015 TA FF - INTERNATIONAL BUILDING CODE - NEW JERSEY EDITION 2015 TA 906.3(2015 TA SHT (LOW) HAZARD OCCUPANCY 2015 TA NIMUM RATED SINGLE EXTINGUISHER 2015 TA XIMUM FLOOR AREA PER UNIT OF A 3,000 XIMUM FLORR AREA FOR EXTINGUISHERb 11,25	WOMEN32LAVATORIES PROVIDEDMEN20MEN21WOMEN24WOMENDRINKING FOUNTAIN NOT PROVIDED - EXCEPTIONS WHEN DRINKING WATER SERVICE IS AVAILABLEPORTABLE FIRE EXTINGUISHERSREF - INTERNATIONAL BUILDING CODE - NEW JERSEY EDITION2015906LIGHT (LOW) HAZARD OCCUPANCYMINIMUM RATED SINGLE EXTINGUISHERMAXIMUM FLOOR AREA PER UNIT OF A31MAXIMUM FLORR AREA FOR EXTINGUISHERb	803.9 (SPRINKL D) T PASSAGEWAYS CLA CLA CLA ACES CLA RECALCULATION 2015 TA PLUMBING CODE 2015 TA PLUMBING CODE 2015 TA MEN 24 WOMEN 32 MEN 24 WOMEN 24 EXCEPTIONS WHEN DRINKING WATER SERVICE IS AVAILABLE CING CODE - NEW JERSEY EDITION 2015 TA DING CODE - NEW JERSEY EDITION 2015 TA 906.3(906.3(JPANCY TINGUISHER QUNIT OF A 3,000 EXTINGUISHERb 11,25	
7.21.: ATER CLOSETS PROVIDED MEN 24 WOMEN 32 VATORIES PROVIDED MEN 20 WOMEN 24 NKING FOUNTAIN NOT PROVIDED - EXCEPTIONS WHEN DRINKING WATER SERVICE IS AVAILABLE 20 ORTABLE FIRE EXTINGUISHER 2015 TAI 906.3(2015 TAI GHT (LOW) HAZARD OCCUPANCY 2015 TAI NIMUM RATED SINGLE EXTINGUISHER 2015 TAI XIMUM FLOOR AREA PER UNIT OF A 3,000 XIMUM FLORR AREA FOR EXTINGUISHERb 11,25	WOMEN32LAVATORIES PROVIDEDMEN20MEN21WOMEN24WOMENDRINKING FOUNTAIN NOT PROVIDED - EXCEPTIONS WHEN DRINKING WATER SERVICE IS AVAILABLEPORTABLE FIRE EXTINGUISHERSREF - INTERNATIONAL BUILDING CODE - NEW JERSEY EDITION2015906LIGHT (LOW) HAZARD OCCUPANCYMINIMUM RATED SINGLE EXTINGUISHERMAXIMUM FLOOR AREA PER UNIT OF A31MAXIMUM FLORR AREA FOR EXTINGUISHERb	803.9 (SPRINKL D) T PASSAGEWAYS CLA ACES CLA ACES CLA RECALCULATION PLUMBING CODE 2015 TAI 7.21.* MEN 24 WOMEN 32 MEN 24 WOMEN 24 WOMEN 24 WOMEN 24 WOMEN 24 EXCEPTIONS WHEN DRINKING WATER SERVICE IS AVAILABLE CING CODE - NEW JERSEY EDITION 2015 TAI 906.3(JPANCY TINGUISHER QUNIT OF A	
F - INTERNATIONAL BUILDING CODE - NEW JERSEY EDITION 2015 TAI 803.9 (SPRINKL D) IT ENCLOSURES AND EXIT PASSAGEWAYS CLA ORRIDORS CLA DOMS AND ENCLOSED SPACES CLA	ROUF CONSTRUCTION & SECONDARY MEMBERS [1 HR		
F - INTERNATIONAL BUILDING CODE - NEW JERSEY EDITION 2015 TAI 803.9 (SPRINKL D) IT ENCLOSURES AND EXIT PASSAGEWAYS CLA ORRIDORS CLA DOMS AND ENCLOSED SPACES CLA	ROOF CONSTRUCTION & SECONDARY MEMBERS 1 HR		
ITERIOR WALL & CEILING FINISH REQUIREMENT F - INTERNATIONAL BUILDING CODE - NEW JERSEY EDITION 2015 TAI 803.9 (SPRINKL D) IT ENCLOSURES AND EXIT PASSAGEWAYS CLA ORRIDORS CLA DOMS AND ENCLOSED SPACES CLA	ROOF CONSTRUCTION & SECONDARY MEMBERS 1 HR		
ITERIOR WALL & CEILING FINISH REQUIREMENT F - INTERNATIONAL BUILDING CODE - NEW JERSEY EDITION 2015 TAI 803.9 (SPRINKL D) IT ENCLOSURES AND EXIT PASSAGEWAYS CLA ORRIDORS CLA DOMS AND ENCLOSED SPACES CLA			
ITERIOR WALL & CEILING FINISH REQUIREMENT F - INTERNATIONAL BUILDING CODE - NEW JERSEY EDITION 2015 TAI 803.9 (SPRINKL D) IT ENCLOSURES AND EXIT PASSAGEWAYS CLA ORRIDORS CLA DOMS AND ENCLOSED SPACES CLA	FLOOR CONSTRUCTION & SECONDARY MEMBERS 2 HR		
OOF CONSTRUCTION & SECONDARY MEMBERS 1 HR ITERIOR WALL & CEILING FINISH REQUIREMENT F - INTERNATIONAL BUILDING CODE - NEW JERSEY EDITION 2015 TAI 803.9 (SPRINKL D) IT ENCLOSURES AND EXIT PASSAGEWAYS CLA OMS AND ENCLOSED SPACES			
OOF CONSTRUCTION & SECONDARY MEMBERS 1 HR ITERIOR WALL & CEILING FINISH REQUIREMENT F - INTERNATIONAL BUILDING CODE - NEW JERSEY EDITION 2015 TA 803.9 (SPRINKI D) IT ENCLOSURES AND EXIT PASSAGEWAYS CLA OMS AND ENCLOSED SPACES			
OOR CONSTRUCTION & SECONDARY MEMBERS 2 HR OOF CONSTRUCTION & SECONDARY MEMBERS 1 HR ITERIOR WALL & CEILING FINISH REQUIREMENT F - INTERNATIONAL BUILDING CODE - NEW JERSEY EDITION 2015 TA 803.9 (SPRINKI D) IT ENCLOSURES AND EXIT PASSAGEWAYS CLA OMS AND ENCLOSED SPACES CLA	2111	ECONDARY MEMBERS 2 HR	
OOR CONSTRUCTION & SECONDARY MEMBERS 2 HR OOF CONSTRUCTION & SECONDARY MEMBERS 1 HR ITERIOR WALL & CEILING FINISH REQUIREMENT F - INTERNATIONAL BUILDING CODE - NEW JERSEY EDITION 2015 TA 803.9 (SPRINKI D) IT ENCLOSURES AND EXIT PASSAGEWAYS CLA OMS AND ENCLOSED SPACES CLA		ECONDARY MEMBERS 2 HR	
OOF CONSTRUCTION & SECONDARY MEMBERS 1 HR ITERIOR WALL & CEILING FINISH REQUIREMENT F - INTERNATIONAL BUILDING CODE - NEW JERSEY EDITION 2015 TA 803.9 (SPRINKI D) IT ENCLOSURES AND EXIT PASSAGEWAYS CLA OMS AND ENCLOSED SPACES			
OOF CONSTRUCTION & SECONDARY MEMBERS 1 HR ITERIOR WALL & CEILING FINISH REQUIREMENT F - INTERNATIONAL BUILDING CODE - NEW JERSEY EDITION 2015 TA 803.9 (SPRINKI D) IT ENCLOSURES AND EXIT PASSAGEWAYS CLA OMS AND ENCLOSED SPACES			
OOF CONSTRUCTION & SECONDARY MEMBERS 1 HR ITERIOR WALL & CEILING FINISH REQUIREMENT F - INTERNATIONAL BUILDING CODE - NEW JERSEY EDITION 2015 TA 803.3 (SPRINK) D) IT ENCLOSURES AND EXIT PASSAGEWAYS CLA OMS AND ENCLOSED SPACES			
OOF CONSTRUCTION & SECONDARY MEMBERS 1 HR ITERIOR WALL & CEILING FINISH REQUIREMENT F - INTERNATIONAL BUILDING CODE - NEW JERSEY EDITION 2015 TA 803.3 (SPRINK) D) IT ENCLOSURES AND EXIT PASSAGEWAYS CLA OMS AND ENCLOSED SPACES			
OOR CONSTRUCTION & SECONDARY MEMBERS 2 HR OOF CONSTRUCTION & SECONDARY MEMBERS 1 HR ITERIOR WALL & CEILING FINISH REQUIREMENT F - INTERNATIONAL BUILDING CODE - NEW JERSEY EDITION 2015 TA 803.9 (SPRINKLD) D) IT ENCLOSURES AND EXIT PASSAGEWAYS CLA OMS AND ENCLOSED SPACES	<u> </u>	ECONDARY MEMBERS 2 HR	
OOR CONSTRUCTION & SECONDARY MEMBERS 2 HR DOF CONSTRUCTION & SECONDARY MEMBERS 1 HR ITERIOR WALL & CEILING FINISH REQUIREMENT F - INTERNATIONAL BUILDING CODE - NEW JERSEY EDITION 2015 TA 803.9 (SPRINKI D) IT ENCLOSURES AND EXIT PASSAGEWAYS CLA DORS AND ENCLOSED SPACES CLA	2111	ECONDARY MEMBERS 2 HR	
OOR CONSTRUCTION & SECONDARY MEMBERS 2 HR DOF CONSTRUCTION & SECONDARY MEMBERS 1 HR ITERIOR WALL & CEILING FINISH REQUIREMENT F - INTERNATIONAL BUILDING CODE - NEW JERSEY EDITION 2015 TA 803.0 (SPRINKI D) IT ENCLOSURES AND EXIT PASSAGEWAYS CLA DORS AND ENCLOSED SPACES CLA		ECONDARY MEMBERS 2 HR	
OOR CONSTRUCTION & SECONDARY MEMBERS 2 HR DOF CONSTRUCTION & SECONDARY MEMBERS 1 HR ITERIOR WALL & CEILING FINISH REQUIREMENT F - INTERNATIONAL BUILDING CODE - NEW JERSEY EDITION 2015 TA 803.0 (SPRINKI D) IT ENCLOSURES AND EXIT PASSAGEWAYS CLA DOMS AND ENCLOSED SPACES		ECONDARY MEMBERS 2 HR	
OOR CONSTRUCTION & SECONDARY MEMBERS 2 HR DOF CONSTRUCTION & SECONDARY MEMBERS 1 HR ITERIOR WALL & CEILING FINISH REQUIREMENT F - INTERNATIONAL BUILDING CODE - NEW JERSEY EDITION 2015 TA 803.1 (SPRINK D) IT ENCLOSURES AND EXIT PASSAGEWAYS CLA OMS AND ENCLOSED SPACES CLA	IN LERIOR 2 HR	ECONDARY MEMBERS 2 HR	
OOR CONSTRUCTION & SECONDARY MEMBERS 2 HR DOF CONSTRUCTION & SECONDARY MEMBERS 1 HR ITERIOR WALL & CEILING FINISH REQUIREMENT F - INTERNATIONAL BUILDING CODE - NEW JERSEY EDITION 2015 TA 803.0 (SPRINKI D) IT ENCLOSURES AND EXIT PASSAGEWAYS CLA DORS AND ENCLOSED SPACES CLA	IN LERIOR 2 HR	ECONDARY MEMBERS 2 HR	
OOR CONSTRUCTION & SECONDARY MEMBERS 2 HR DOF CONSTRUCTION & SECONDARY MEMBERS 1 HR ITERIOR WALL & CEILING FINISH REQUIREMENT F - INTERNATIONAL BUILDING CODE - NEW JERSEY EDITION 2015 TA 803.0 (SPRINKI D) IT ENCLOSURES AND EXIT PASSAGEWAYS CLA DORS AND ENCLOSED SPACES CLA	INTERIOR 2 HR	ECONDARY MEMBERS 2 HR	
OOR CONSTRUCTION & SECONDARY MEMBERS 2 HR DOF CONSTRUCTION & SECONDARY MEMBERS 1 HR ITERIOR WALL & CEILING FINISH REQUIREMENT F - INTERNATIONAL BUILDING CODE - NEW JERSEY EDITION 2015 TA 803.0 (SPRINKI D) IT ENCLOSURES AND EXIT PASSAGEWAYS CLA DORS AND ENCLOSED SPACES CLA	INTERIOR 2 HR	ECONDARY MEMBERS 2 HR	
OOR CONSTRUCTION & SECONDARY MEMBERS 2 HR DOF CONSTRUCTION & SECONDARY MEMBERS 1 HR ITERIOR WALL & CEILING FINISH REQUIREMENT F - INTERNATIONAL BUILDING CODE - NEW JERSEY EDITION 2015 TA 803.0 (SPRINKI D) IT ENCLOSURES AND EXIT PASSAGEWAYS CLA DORS AND ENCLOSED SPACES CLA		ECONDARY MEMBERS 2 HR	
OOF CONSTRUCTION & SECONDARY MEMBERS 1 HR ITERIOR WALL & CEILING FINISH REQUIREMENT F - INTERNATIONAL BUILDING CODE - NEW JERSEY EDITION 2015 TA 803.9 (SPRINKI D) IT ENCLOSURES AND EXIT PASSAGEWAYS CLA ORRIDORS CLA DOMS AND ENCLOSED SPACES CLA	•		
OOF CONSTRUCTION & SECONDARY MEMBERS 1 HR ITERIOR WALL & CEILING FINISH REQUIREMENT F - INTERNATIONAL BUILDING CODE - NEW JERSEY EDITION 2015 TA 803.9 (SPRINKI D) IT ENCLOSURES AND EXIT PASSAGEWAYS CLA OMS AND ENCLOSED SPACES	FLOOR CONSTRUCTION & SECONDARY MEMBERS		
ITERIOR WALL & CEILING FINISH REQUIREMENT F - INTERNATIONAL BUILDING CODE - NEW JERSEY EDITION 2015 TA 803.9 (SPRINKI D) IT ENCLOSURES AND EXIT PASSAGEWAYS CLA ORRIDORS CLA DOMS AND ENCLOSED SPACES CLA			
ITERIOR WALL & CEILING FINISH REQUIREMENT F - INTERNATIONAL BUILDING CODE - NEW JERSEY EDITION 2015 TA 803.9 (SPRINKI D) IT ENCLOSURES AND EXIT PASSAGEWAYS CLA ORRIDORS CLA DOMS AND ENCLOSED SPACES CLA			
ITERIOR WALL & CEILING FINISH REQUIREMENT F - INTERNATIONAL BUILDING CODE - NEW JERSEY EDITION 2015 TA 803.9 (SPRINKID) IT ENCLOSURES AND EXIT PASSAGEWAYS CLA ORRIDORS CLA DOMS AND ENCLOSED SPACES CLA			


CLIENT	
Global Spectrum	
2301 Boardwalk	
Atlantic City, NJ 08401	
CRDA	
15 S Pennsylvania Avenue	
Atlantic City, NJ 08401	
Architect	
SOSH Architects	
1020 Atlantic Avenue	
Atlantic City, NJ 08401	
T: 609.345.5222	
Contact: Chris Menchin	
MEPFA Engineer	
Concord Atlantic Engineers	
2311 Atlantic Avenue	
Atlantic City, NJ 08401	
T: 609.246.7255	
Contact: Anthony Caucci	

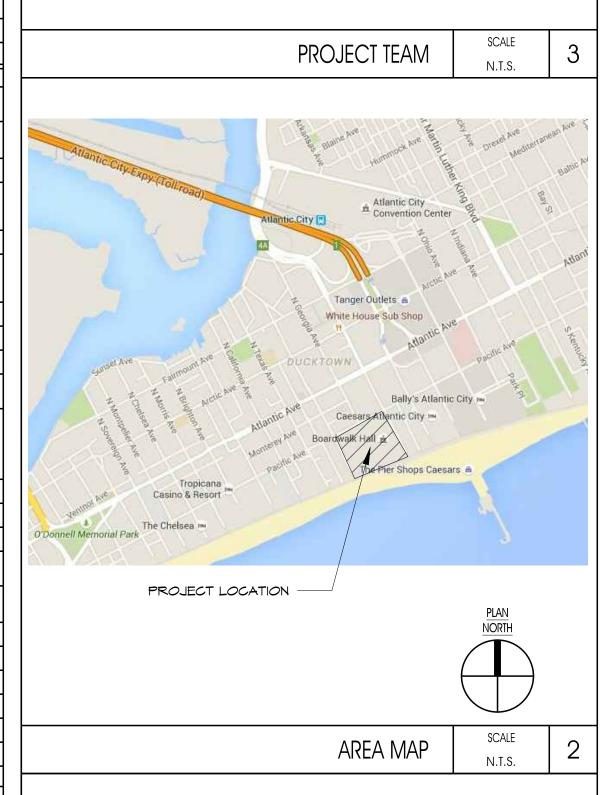


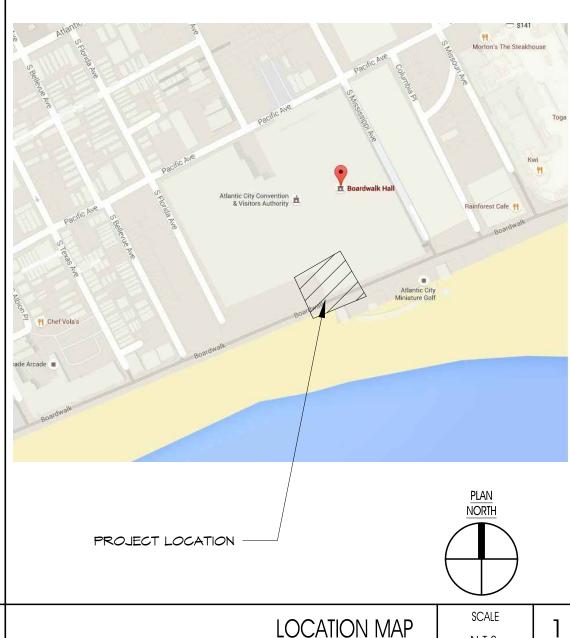

SOSH
atlantic citynew york1020 Atlantic Avenue145 West 57th StreetAtlantic City, NJ 08401New York, NY 10019T: 609.345.5222T: 212.246.2770F: 609.345.7486F: 212.246.2771
Thomas J. Sykes, A.I.A., P.P.
William A. Salerno, A.I.A., P.P. Founding Principal Nory Hazaveh, A.I.A., P.P. Founding Principal Mark Petrella, A.I.A.
Principal Christopher M. Menchin, NCARB Principal Kimberly McCarron, NCARB Principal
w w w . s o s h a r c h . c o m
Boardwalk Hall Your BIST SEAT AT THE SHORE
AC BOARDWALK HALL RESTROOM RENOVATION
2301 BOARDWALK, ATLANTIC CITY, NJ 08401
SUBMISSIONS
1 2016.11.30 ADDENDUM #2 10-14-2016 CONSTRUCTION DOCUMENTS
NO. I DATE: I DESCRIPTION: DRAWING TITLE:
COVER SHEET
DRAWN BY: SB DRAWING NO. REVIEWED BY: CM
PROJECT NO. 15243.00.001 AC-000

KEY	DEMOLITION NOTES LEGEND			
	DESCRIPTION REMOVE PORTION OF EXISTING WALL CONSTRUC	ΤΙΩΝ' ΡΔΤΩΗ		
01	AND REPAIR FLOOR, CEILING, AND SURROUNDIN CONSTRUCTION AS REQUIRED			
01	REMOVE EXISTING DOOR AND FRAME; PATCH AN			
02	FLOOR, CEILING, AND SURROUNDING WALL CON REQUIRED	STRUCTION AS	>	
∧ 0 <u>2A</u>	REMOVE TRANSOM PANEL ABOVE DOOR & INFIL SURROUNDING CONSTRUCTION	L TO MATCH		
1 03	NOT USED			
	REMOVE EXISTING PLUMBING FIXTURES, WATER LINES TO BE RELOCATED AS NECESSARY FOR NEV		R	
04	INSTALL; ADDITIONAL FLOOR & WALL DEMOLITIC REQUIRED			
	REMOVE EXISTING FLOOR FINISH & PREP FLOOR	FOR NEW		
	FINISH;SEE ALSO NOTE #3 REMOVE ALL EXISTING TOILET PARTITIONS & DO	ORS		
07	REMOVE ALL EXISTING RESTROOM ACCESSORIES			
08	REMOVE EXISTING RADIANT HEATERS & COVERS BELOW FLOOR & PATCH AS NEEDED	; CAP PIPING		
	REMOVE EXISTING GWB CEILING AND LIGHT FIXT REMOVE EXISTING STONE SHELVES	URES		
	REMOVE EXISTING CEILING IN ITS ENTIRETY			
12	REMOVE EXISTING CEILING FIXTURES; REFER TO INFO	MEP FOR MOR	E	
13	REMOVE EXISTING EXPOSED SPRINKLER LINES; RIPROTECTION FOR MORE INFO	EFER TO FIRE		
14	REMOVE EXISTING HEADER			
	EXISTING JANITOR CLOSET DOORS TO REMAIN; R DOOR WITH SIMILAR	\sim		
	RELOČATE EXISTING DOOR & FRAME; SEE DOOR MORE INFO		C C	
	RELOCATE EXPOSED SPRINKLER PIPE STRIP PAINT FROM EXISTING WINDOWS & PREP	FOR NEW FINI	SH	
1/			•	
	DEMOLITION NOTES EXISTING JANITORS CLOSETS TO REMAIN; DOORS	STO BF SANDE	D	
	& PAINTED; CLEAN &/OR REPAIR EXISTING DOOR	RHARDWARE	-	
	REFER TO MEP DRAWINGS FOR ADDITIONAL INFO FILL CRACKS IN EXISTING CONCRETE SLAB PRIOR		ON	
#3	OF PROPOSED FLOOR FINISHES DOOR AND FRAMES NOTED TO BE REMOVED SHA			
#4	RETURNED TO OWNER REMOVE & REPLACE ALL EXHAUST GRILLS, TYP FO			
#5	RESTROOMS; SEE MEP DRAWINGS			
	DEMOLITION LEGEND	SCALE NTS	3	

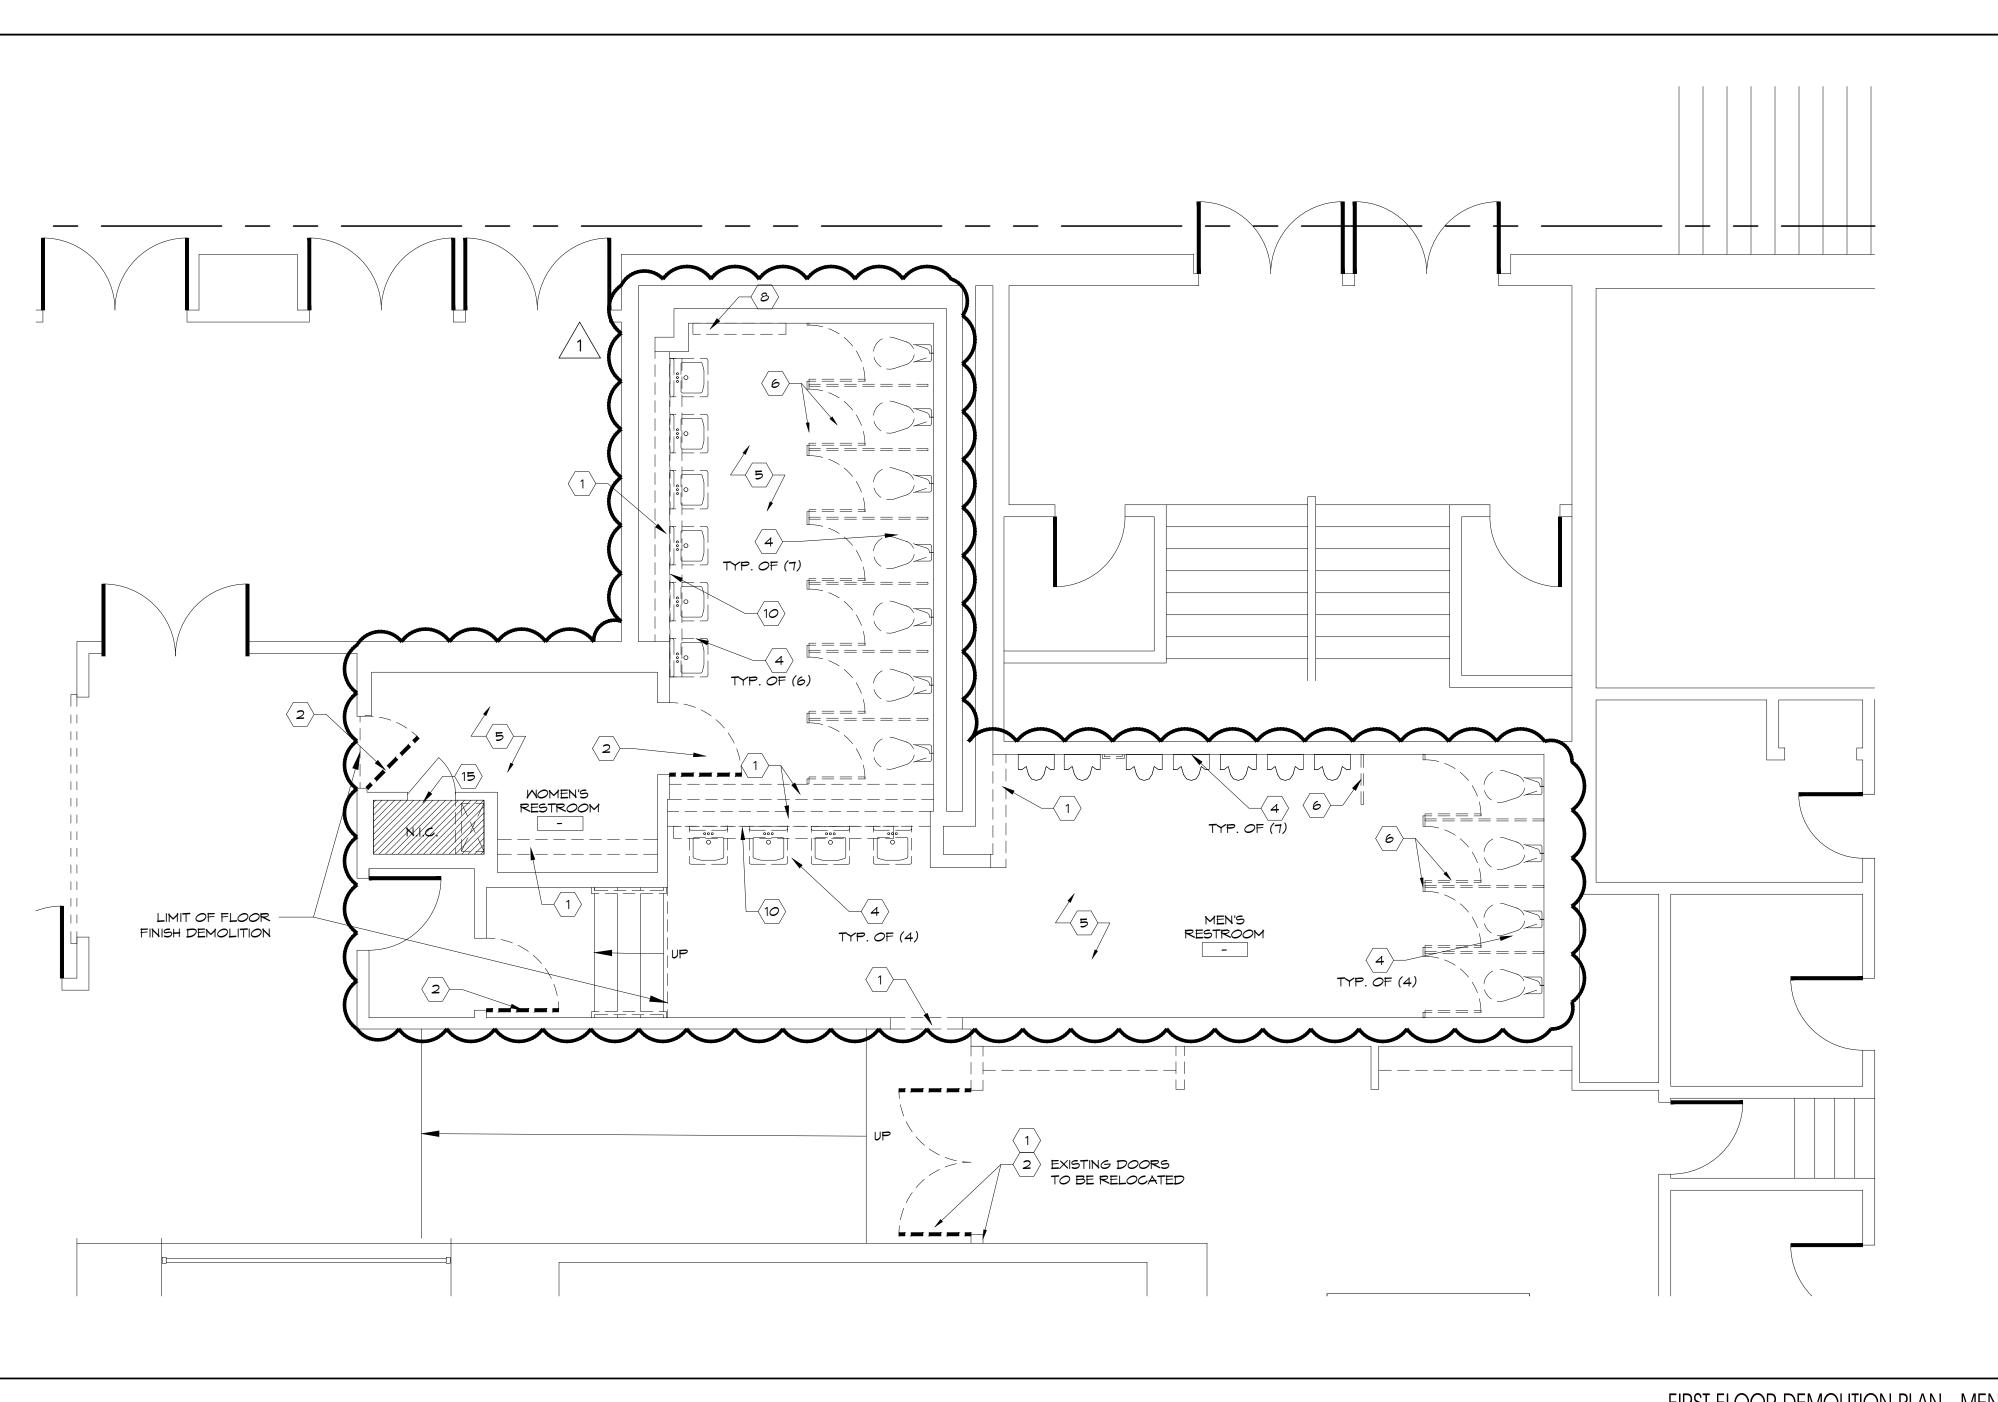

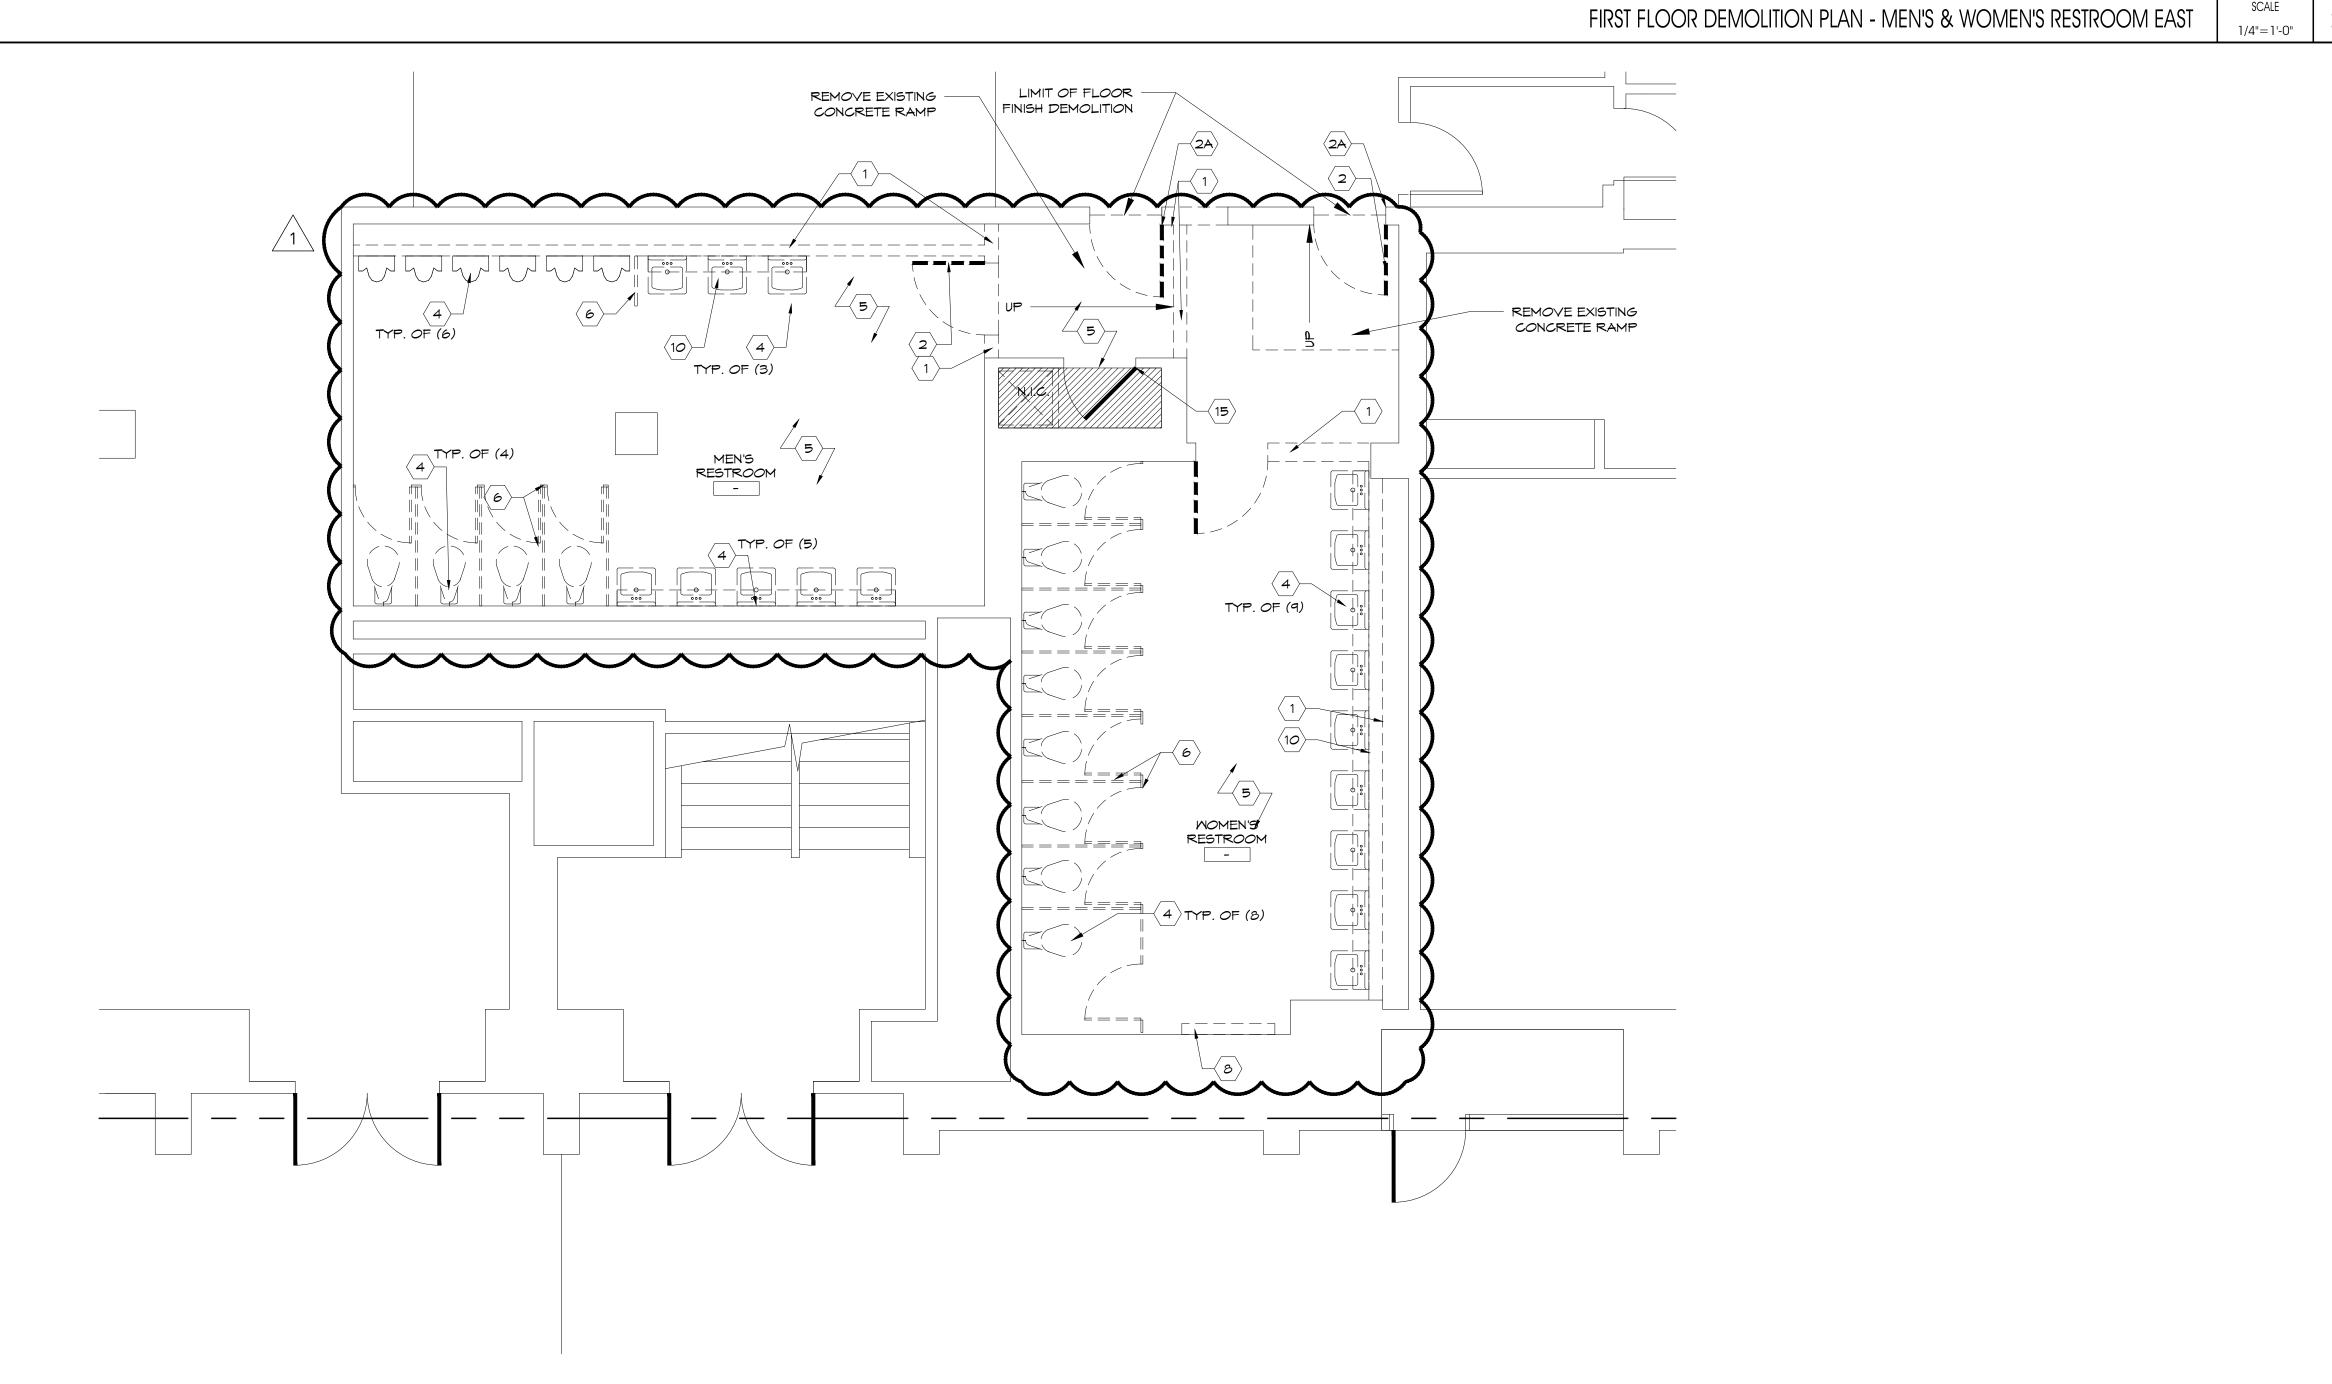


SCALE 1-4"=1'-0"


Solution State Sta
Thomas J. Sykes, A.I.A., P.P. Founding Principal William A. Salerno, A.I.A., P.P. Founding Principal Nory Hazaveh, A.I.A., P.P. Founding Principal Mark Petrella, A.I.A. Principal Christopher M. Menchin, NCARB Principal Kimberly McCarron, NCARB Principal
www.sosharch.com
Boardwalk Hall YOUR BEST SEAT AT THE SHOWE
AC BOARDWALK HALL RESTROOM RENOVATION
2301 BOARDWALK, ATLANTIC CITY, NJ 08401
SUBMISSIONS
1 + 2016.11.30 + ADDENDUM #2 I 10-14-2016 I CONSTRUCTION DOCUMENTS
NO. I DATE: I DESCRIPTION:
DRAWING TITLE: FIRST FLOOR RESTROOM DEMOLITION PLANS
DRAWN BY: PS DRAWING NO. REVIEWED BY: CM PROJECT NO. 15243.00.001 AD-101

SCALE

	DEMOLITION NOTES LEGEND
KEY	DESCRIPTION
UNIBER	REMOVE PORTION OF EXISTING WALL CONSTRUCTION; PATCH
01	AND REPAIR FLOOR, CEILING, AND SURROUNDING WALL CONSTRUCTION AS REQUIRED
02	REMOVE EXISTING DOOR AND FRAME; PATCH AND REPAIR FLOOR, CEILING, AND SURROUNDING WALL CONSTRUCTION AS REQUIRED
	REMOVE TRANSOM PANEL ABOVE DOOR & INFILL TO MATCH SURROUNDING CONSTRUCTION
	NOT USED
	REMOVE EXISTING PLUMBING FIXTURES, WATER LINES & SEWER
04	LINES TO BE RELOCATED AS NECESSARY FOR NEW FIXTURE INSTALL; ADDITIONAL FLOOR & WALL DEMOLITION MAY BE REQUIRED
	REMOVE EXISTING FLOOR FINISH & PREP FLOOR FOR NEW
	FINISH;SEE ALSO NOTE #3 REMOVE ALL EXISTING TOILET PARTITIONS & DOORS
07	REMOVE ALL EXISTING RESTROOM ACCESSORIES REMOVE EXISTING RADIANT HEATERS & COVERS; CAP PIPING
	BELOW FLOOR & PATCH AS NEEDED REMOVE EXISTING GWB CEILING AND LIGHT FIXTURES
	REMOVE EXISTING STONE SHELVES
	REMOVE EXISTING CEILING IN ITS ENTIRETY REMOVE EXISTING CEILING FIXTURES; REFER TO MEP FOR MORE
12	INFO REMOVE EXISTING EXPOSED SPRINKLER LINES; REFER TO FIRE
	PROTECTION FOR MORE INFO REMOVE EXISTING HEADER
15	EXISTING JANITOR CLOSET DOORS TO REMAIN; REPLACE GRILL IN
	RELOCATE EXISTING DOOR & FRAME; SEE DOOR SCHEDULE FOR MORE INFO
16	RELOCATE EXPOSED SPRINKLER PIPE
17	STRIP PAINT FROM EXISTING WINDOWS & PREP FOR NEW FINISH
	DEMOLITION NOTES EXISTING JANITORS CLOSETS TO REMAIN; DOORS TO BE SANDED
#1	& PAINTED; CLEAN &/OR REPAIR EXISTING DOOR HARDWARE
	REFER TO MEP DRAWINGS FOR ADDITIONAL INFORMATION FILL CRACKS IN EXISTING CONCRETE SLAB PRIOR TO APPLICATION OF PROPOSED FLOOR FINISHES
	DOOR AND FRAMES NOTED TO BE REMOVED SHALL BE RETURNED TO OWNER
	REMOVE & REPLACE ALL EXHAUST GRILLS, TYP FOR ALL RESTROOMS; SEE MEP DRAWINGS
#5	

DEMOLITION NOTES	SCALE	2	
	N.T.S.	0	

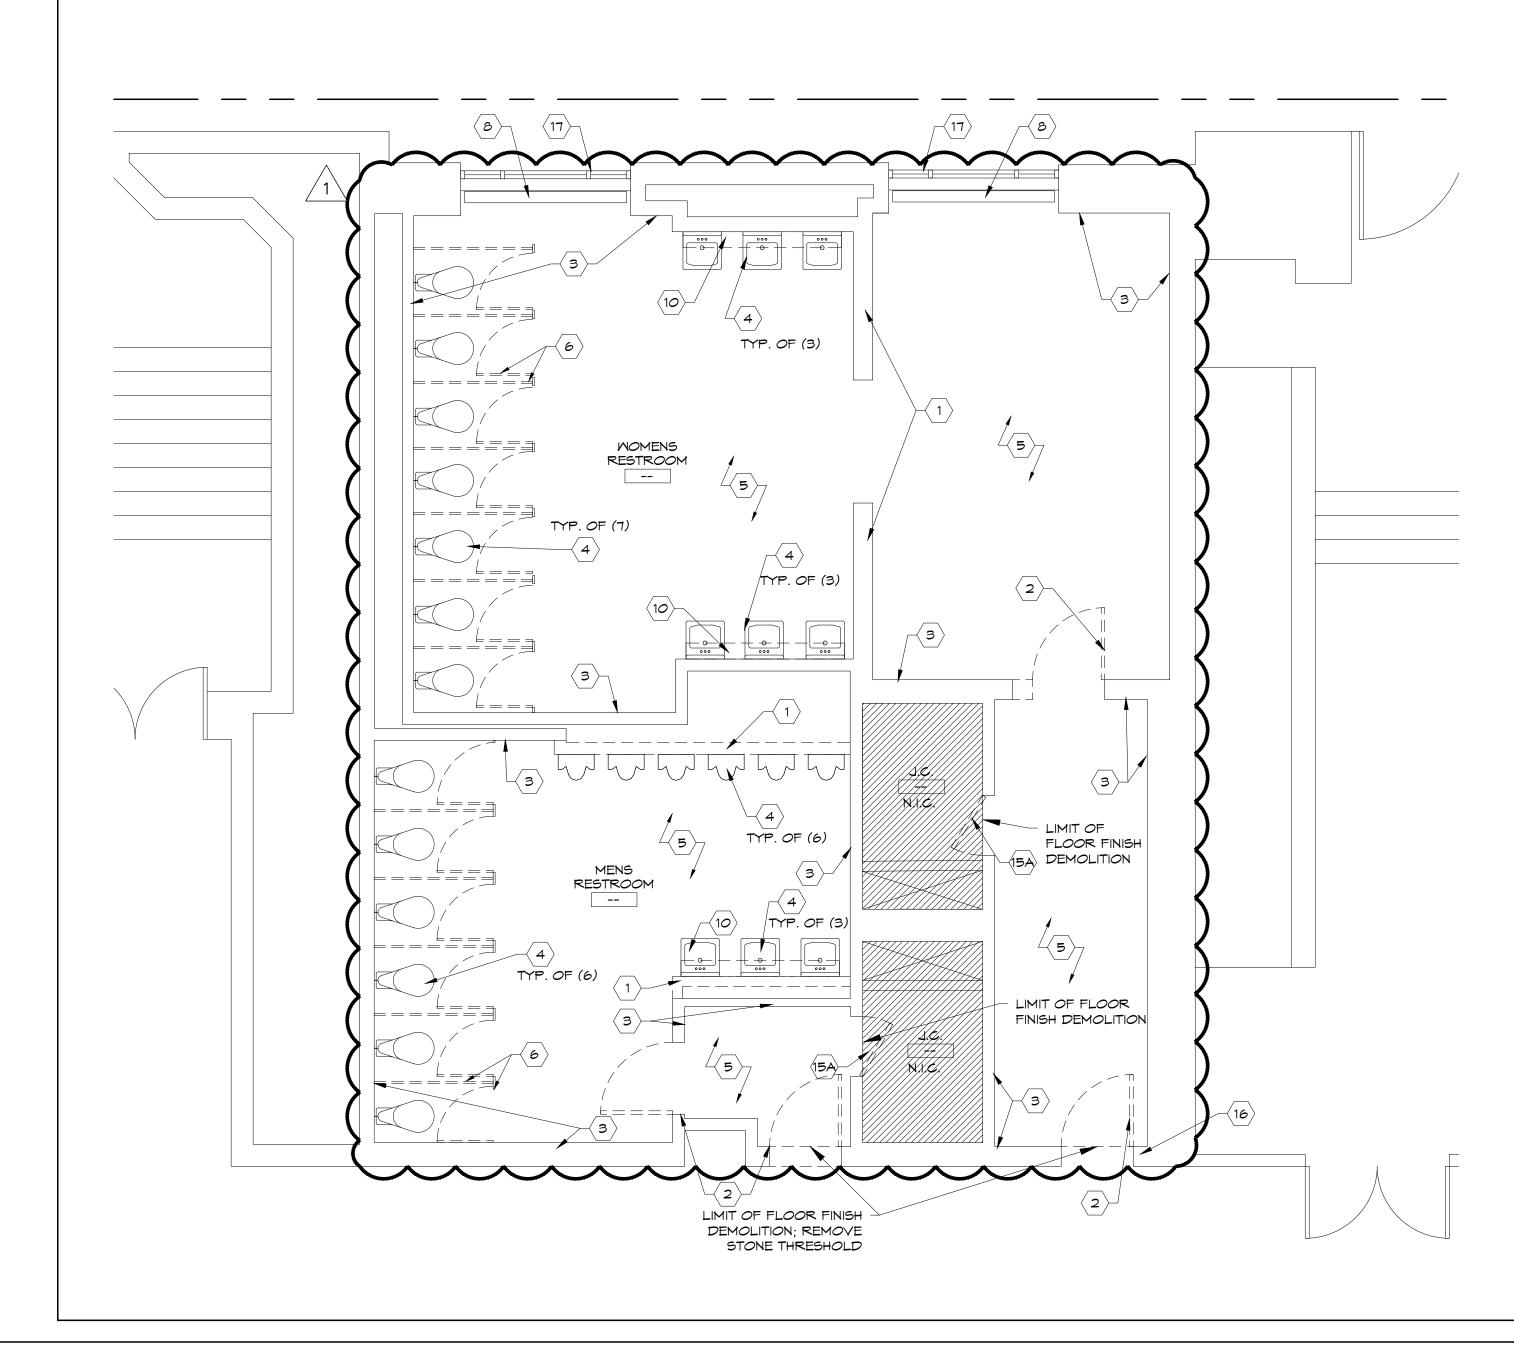

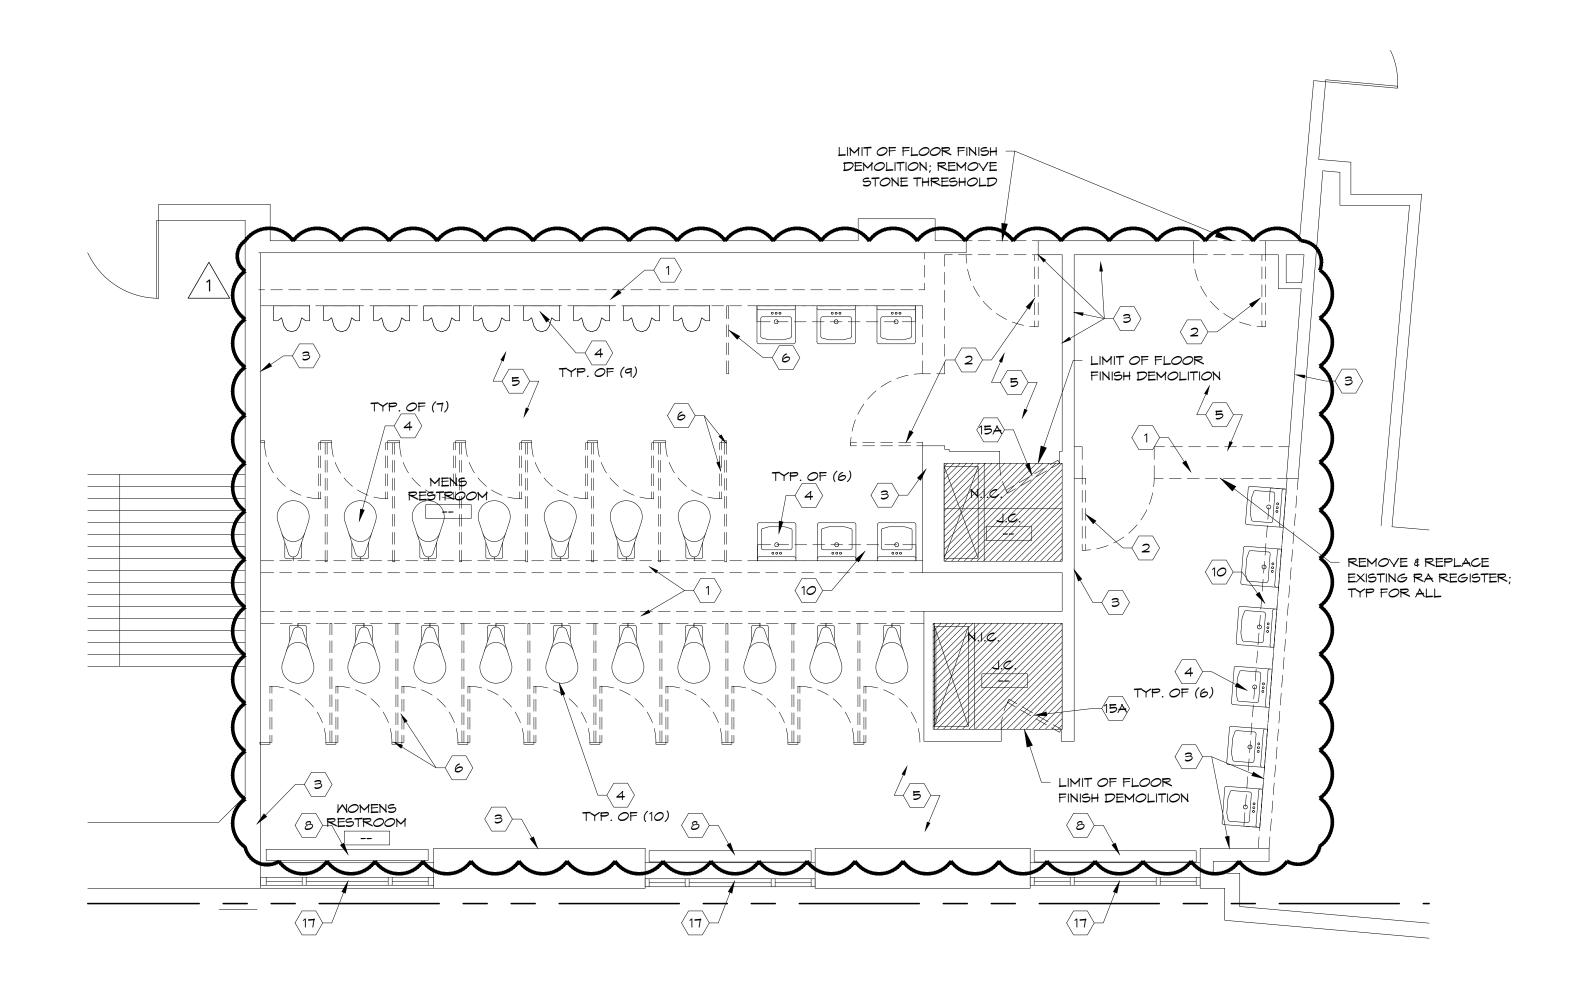



SECOND FLOOR DEMOLITION PLAN - MEN'S AND WOMEN'S RESTROOM EAST	SCALE	
SECOND FLOOR DEIVIOLITION FLAN - IVIEINS AND WOIVIEINS RESTROOIVI EAST	1/4"=1'-0"	

SCALE . 1/4"=1'-0"

SOSH
atlantic city new york 1020 Atlantic Avenue 145 West 57th Street Atlantic City, NJ 08401 New York, NY 10019 T: 609.345.5222 T: 212.246.2770 F: 609.345.7486 F: 212.246.2770
www.sosharch.com Thomas J. Sykes, A.I.A., P.P. Founding Principal
William A. Salerno, A.I.A., P.P. Founding Principal Nory Hazaveh, A.I.A., P.P. Founding Principal Mark Petrella, A.I.A.
Principal Christopher M. Menchin, NCARB Principal Kimberly McCarron, NCARB
Principal
www.sosharch.com
Boardwalk Hall YOUR BEST SEAT AT THE SHOWE
AC BOARDWALK HALL RESTROOM RENOVATION
2301 BOARDWALK, ATLANTIC CITY, NJ 08401
SUBMISSIONS
 1 2016.11.30 ADDENDUM #2
I 10-14-2016 I CONSTRUCTION DOCUMENTS NO. I DATE: I DESCRIPTION:
DRAWING TITLE: SECOND FLOOR RESTROOM
DEMOLITION PLANS
DRAWN BY: PS DRAWING NO. REVIEWED BY: CM PROJECT NO. 1 5 0 4 2 00 001 ADD-102
15243.00.001

KEY	DEMOLITION NOTES LEGEND DESCRIPTION
NOWBER	REMOVE PORTION OF EXISTING WALL CONSTRUCTION; PATCH AND REPAIR FLOOR, CEILING, AND SURROUNDING WALL
01	CONSTRUCTION AS REQUIRED REMOVE EXISTING DOOR AND FRAME; PATCH AND REPAIR
02	FLOOR, CEILING, AND SURROUNDING WALL CONSTRUCTION AS REQUIRED
02A	REMOVE TRANSOM PANEL ABOVE DOOR & INFILL TO MATCH SURROUNDING CONSTRUCTION
	NOT USED
	REMOVE EXISTING PLUMBING FIXTURES, WATER LINES & SEWER LINES TO BE RELOCATED AS NECESSARY FOR NEW FIXTURE INSTALL; ADDITIONAL FLOOR & WALL DEMOLITION MAY BE
04	REQUIRED REMOVE EXISTING FLOOR FINISH & PREP FLOOR FOR NEW
	FINISH;SEE ALSO NOTE #3 REMOVE ALL EXISTING TOILET PARTITIONS & DOORS
	REMOVE ALL EXISTING RESTROOM ACCESSORIES
	REMOVE EXISTING RADIANT HEATERS & COVERS; CAP PIPING BELOW FLOOR & PATCH AS NEEDED
	REMOVE EXISTING GWB CEILING AND LIGHT FIXTURES REMOVE EXISTING STONE SHELVES
	REMOVE EXISTING CEILING IN ITS ENTIRETY REMOVE EXISTING CEILING FIXTURES; REFER TO MEP FOR MORE
	INFO REMOVE EXISTING EXPOSED SPRINKLER LINES; REFER TO FIRE PROTECTION FOR MORE INFO
	REMOVE EXISTING HEADER
	EXISTING JANITOR CLOSET DOORS TO REMAIN; REPLACE GRILL IN DOOR WITH SIMILAR
	RELOČATE EXISTING DOOR & FRAME; SEĚ DOOR SCHEĎULE FÖR MORE INFO
	RELOCATE EXPOSED SPRINKLER PIPE STRIP PAINT FROM EXISTING WINDOWS & PREP FOR NEW FINISH
	DEMOLITION NOTES
#1	EXISTING JANITORS CLOSETS TO REMAIN; DOORS TO BE SANDED & PAINTED; CLEAN &/OR REPAIR EXISTING DOOR HARDWARE
#2	REFER TO MEP DRAWINGS FOR ADDITIONAL INFORMATION FILL CRACKS IN EXISTING CONCRETE SLAB PRIOR TO APPLICATION
	OF PROPOSED FLOOR FINISHES DOOR AND FRAMES NOTED TO BE REMOVED SHALL BE
	RETURNED TO OWNER REMOVE & REPLACE ALL EXHAUST GRILLS, TYP FOR ALL
#5	RESTROOMS; SEE MEP DRAWINGS
	SCALE SCALE
	DEMOLITION LEGEND SCALE 3

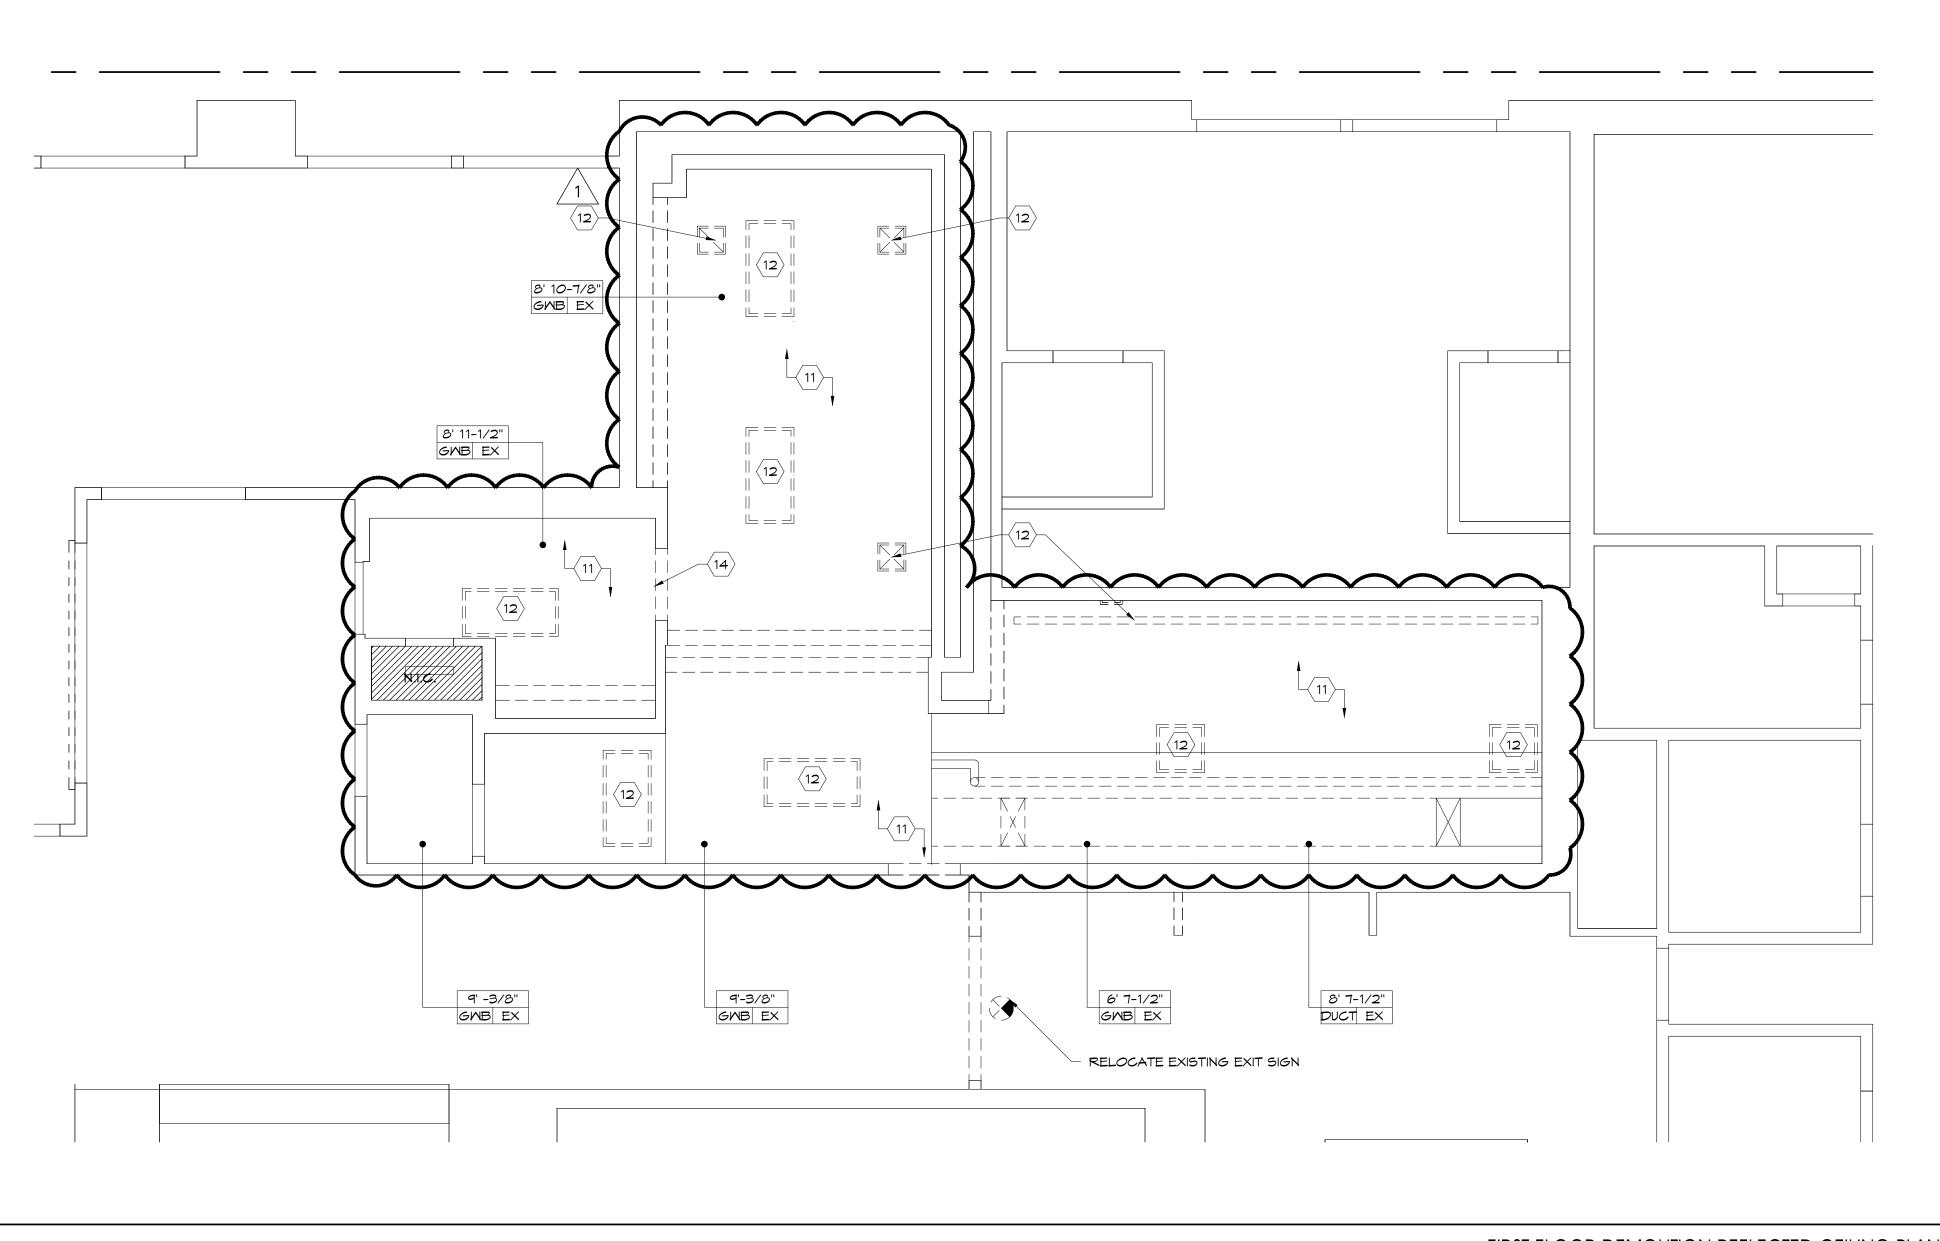

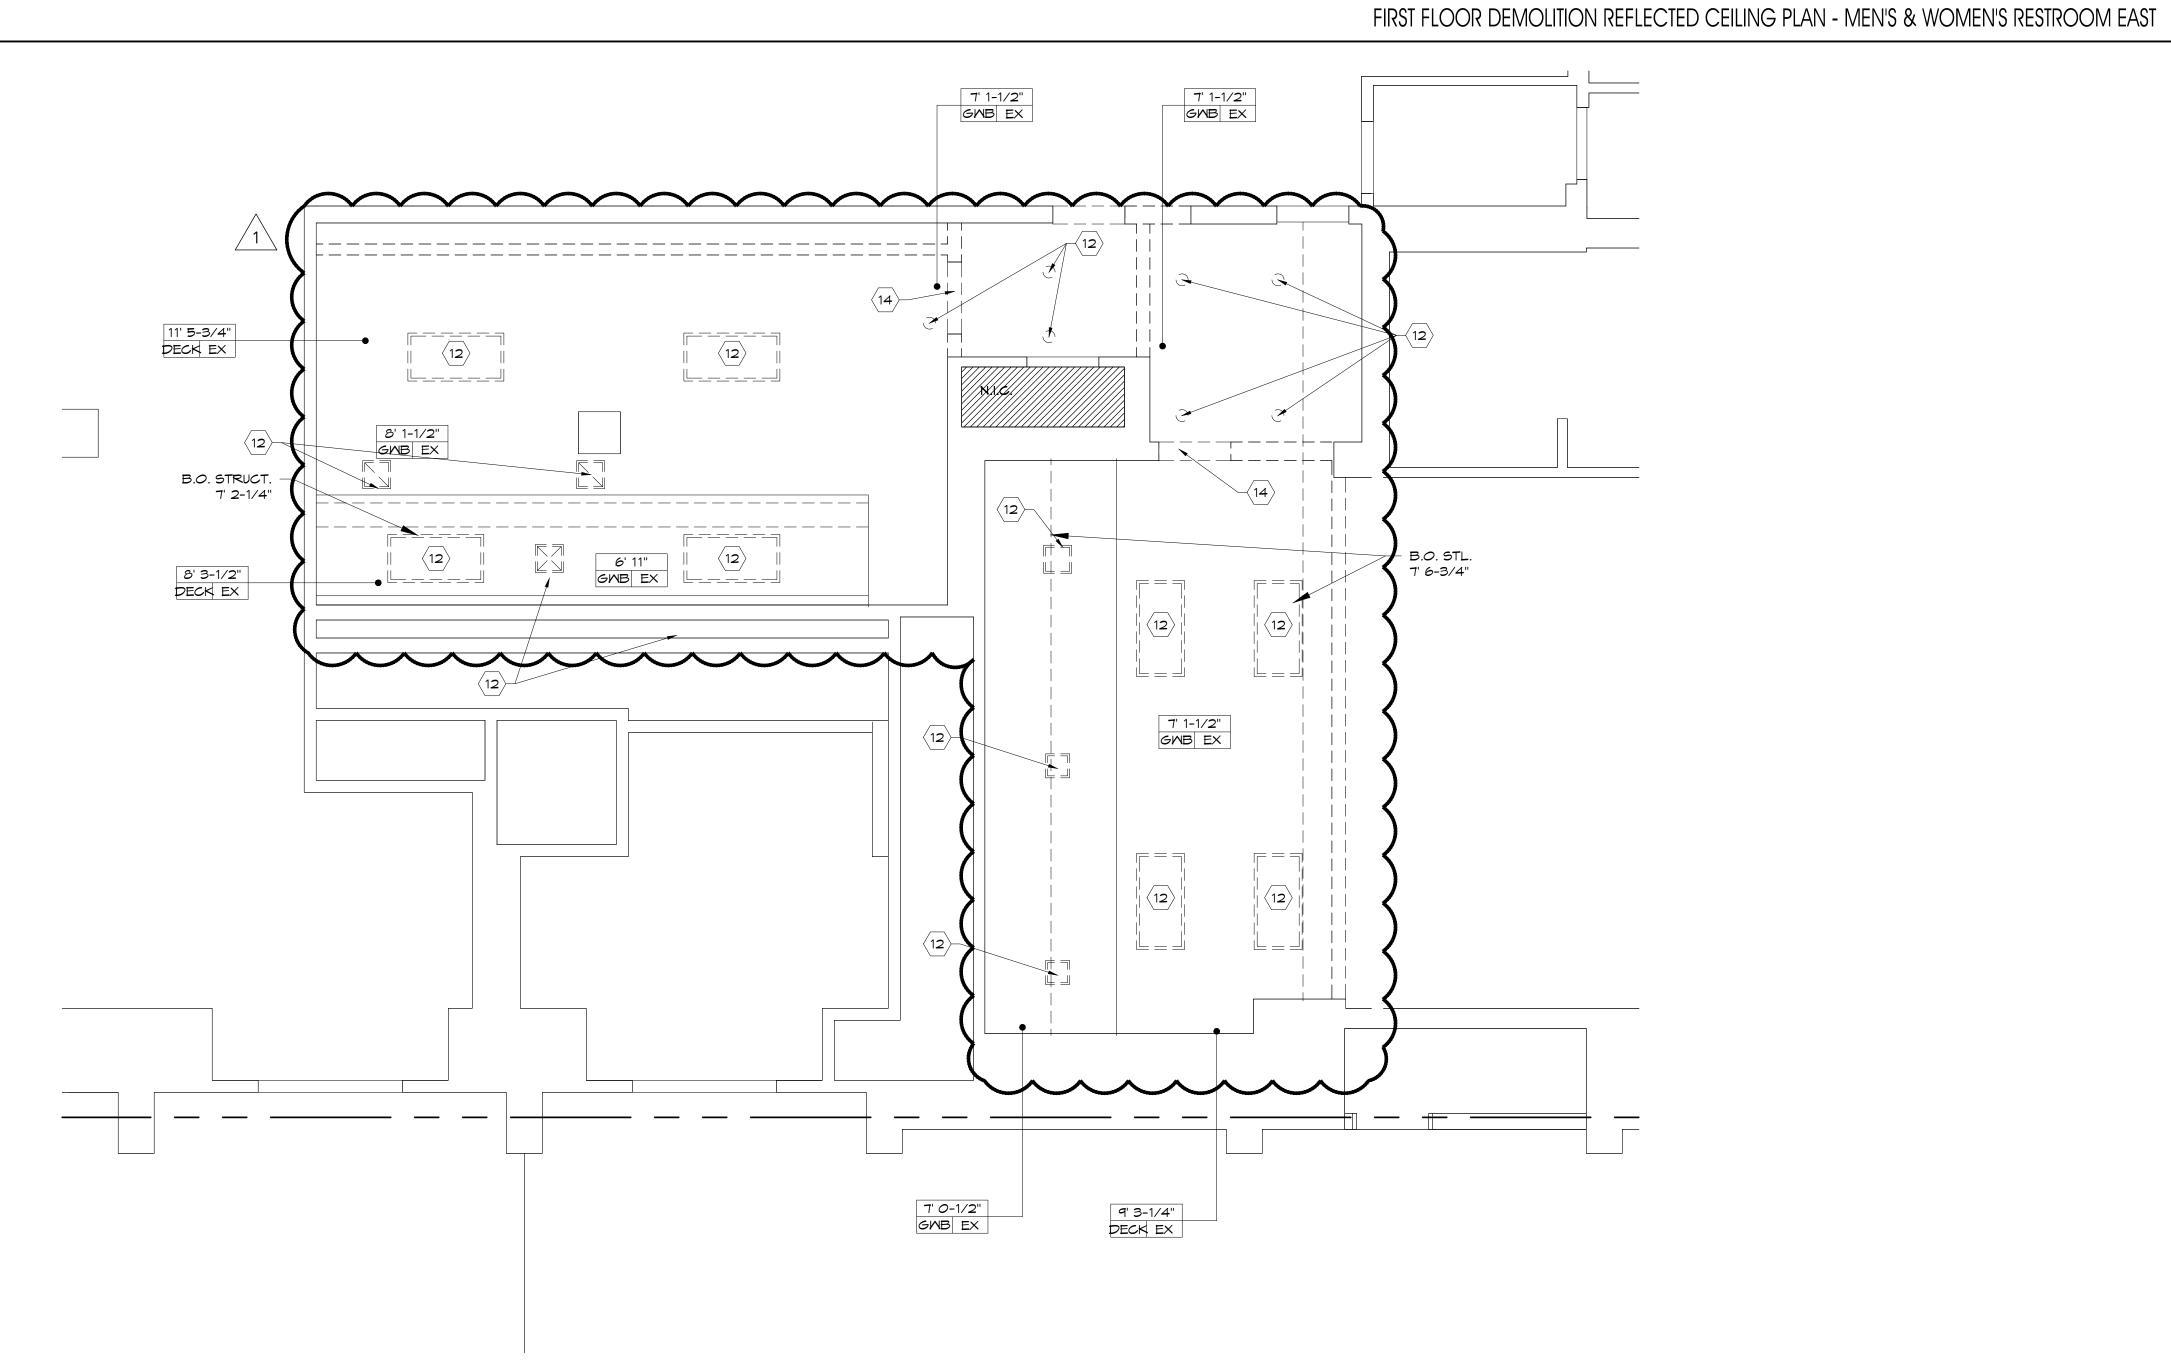


Atlantic City NU 08401
Atlantic City, NJ 08401 New York, NY 10019 T: 609.345.5222 T: 212.246.2770 F: 609.345.7486 F: 212.246.2770 www.sosharch.com Thomas J. Sykes, A.I.A., P.P. Founding Principal William A. Salerno, A.I.A., P.P. Founding Principal Nory Hazaveh, A.I.A., P.P. Founding Principal Mark Petrella, A.I.A. Principal Christopher M. Menchin, NCARB Principal Kimberly McCarron, NCARB Principal
www.sosharch.com Www.sosharch.com Scardwalk Voux Bust Skar Ar The Show AC BOARDWALK HALL RESTROOM RENOVATION
2301 BOARDWALK, ATLANTIC CITY, NJ 08401 SUBMISSIONS
I I I I
DRAWING TITLE: FIRST FLOOR RESTROOM DEMOLITION REFLECTED CEILING PLANS
DRAWN BY: PS DRAWING NO. REVIEWED BY: CM PROJECT NO. 15243.00.001 AD-201


SCALE

1/4"=1'-0"

	DEMOLITION NOTES LEGEND
KEY	DESCRIPTION
UNIBER	REMOVE PORTION OF EXISTING WALL CONSTRUCTION; PATCH
01	AND REPAIR FLOOR, CEILING, AND SURROUNDING WALL CONSTRUCTION AS REQUIRED
02	REMOVE EXISTING DOOR AND FRAME; PATCH AND REPAIR FLOOR, CEILING, AND SURROUNDING WALL CONSTRUCTION AS REQUIRED
	REMOVE TRANSOM PANEL ABOVE DOOR & INFILL TO MATCH SURROUNDING CONSTRUCTION
	NOT USED
	REMOVE EXISTING PLUMBING FIXTURES, WATER LINES & SEWER
04	LINES TO BE RELOCATED AS NECESSARY FOR NEW FIXTURE INSTALL; ADDITIONAL FLOOR & WALL DEMOLITION MAY BE REQUIRED
	REMOVE EXISTING FLOOR FINISH & PREP FLOOR FOR NEW
	FINISH;SEE ALSO NOTE #3 REMOVE ALL EXISTING TOILET PARTITIONS & DOORS
07	REMOVE ALL EXISTING RESTROOM ACCESSORIES REMOVE EXISTING RADIANT HEATERS & COVERS; CAP PIPING
	BELOW FLOOR & PATCH AS NEEDED REMOVE EXISTING GWB CEILING AND LIGHT FIXTURES
	REMOVE EXISTING STONE SHELVES
	REMOVE EXISTING CEILING IN ITS ENTIRETY REMOVE EXISTING CEILING FIXTURES; REFER TO MEP FOR MORE
12	INFO REMOVE EXISTING EXPOSED SPRINKLER LINES; REFER TO FIRE
	PROTECTION FOR MORE INFO REMOVE EXISTING HEADER
15	EXISTING JANITOR CLOSET DOORS TO REMAIN; REPLACE GRILL IN
	RELOCATE EXISTING DOOR & FRAME; SEE DOOR SCHEDULE FOR MORE INFO
16	RELOCATE EXPOSED SPRINKLER PIPE
17	STRIP PAINT FROM EXISTING WINDOWS & PREP FOR NEW FINISH
	DEMOLITION NOTES EXISTING JANITORS CLOSETS TO REMAIN; DOORS TO BE SANDED
#1	& PAINTED; CLEAN &/OR REPAIR EXISTING DOOR HARDWARE
	REFER TO MEP DRAWINGS FOR ADDITIONAL INFORMATION FILL CRACKS IN EXISTING CONCRETE SLAB PRIOR TO APPLICATION OF PROPOSED FLOOR FINISHES
	DOOR AND FRAMES NOTED TO BE REMOVED SHALL BE RETURNED TO OWNER
	REMOVE & REPLACE ALL EXHAUST GRILLS, TYP FOR ALL RESTROOMS; SEE MEP DRAWINGS
#5	


DEMOLITION NOTES	SCALE	2	
	N.T.S.	0	

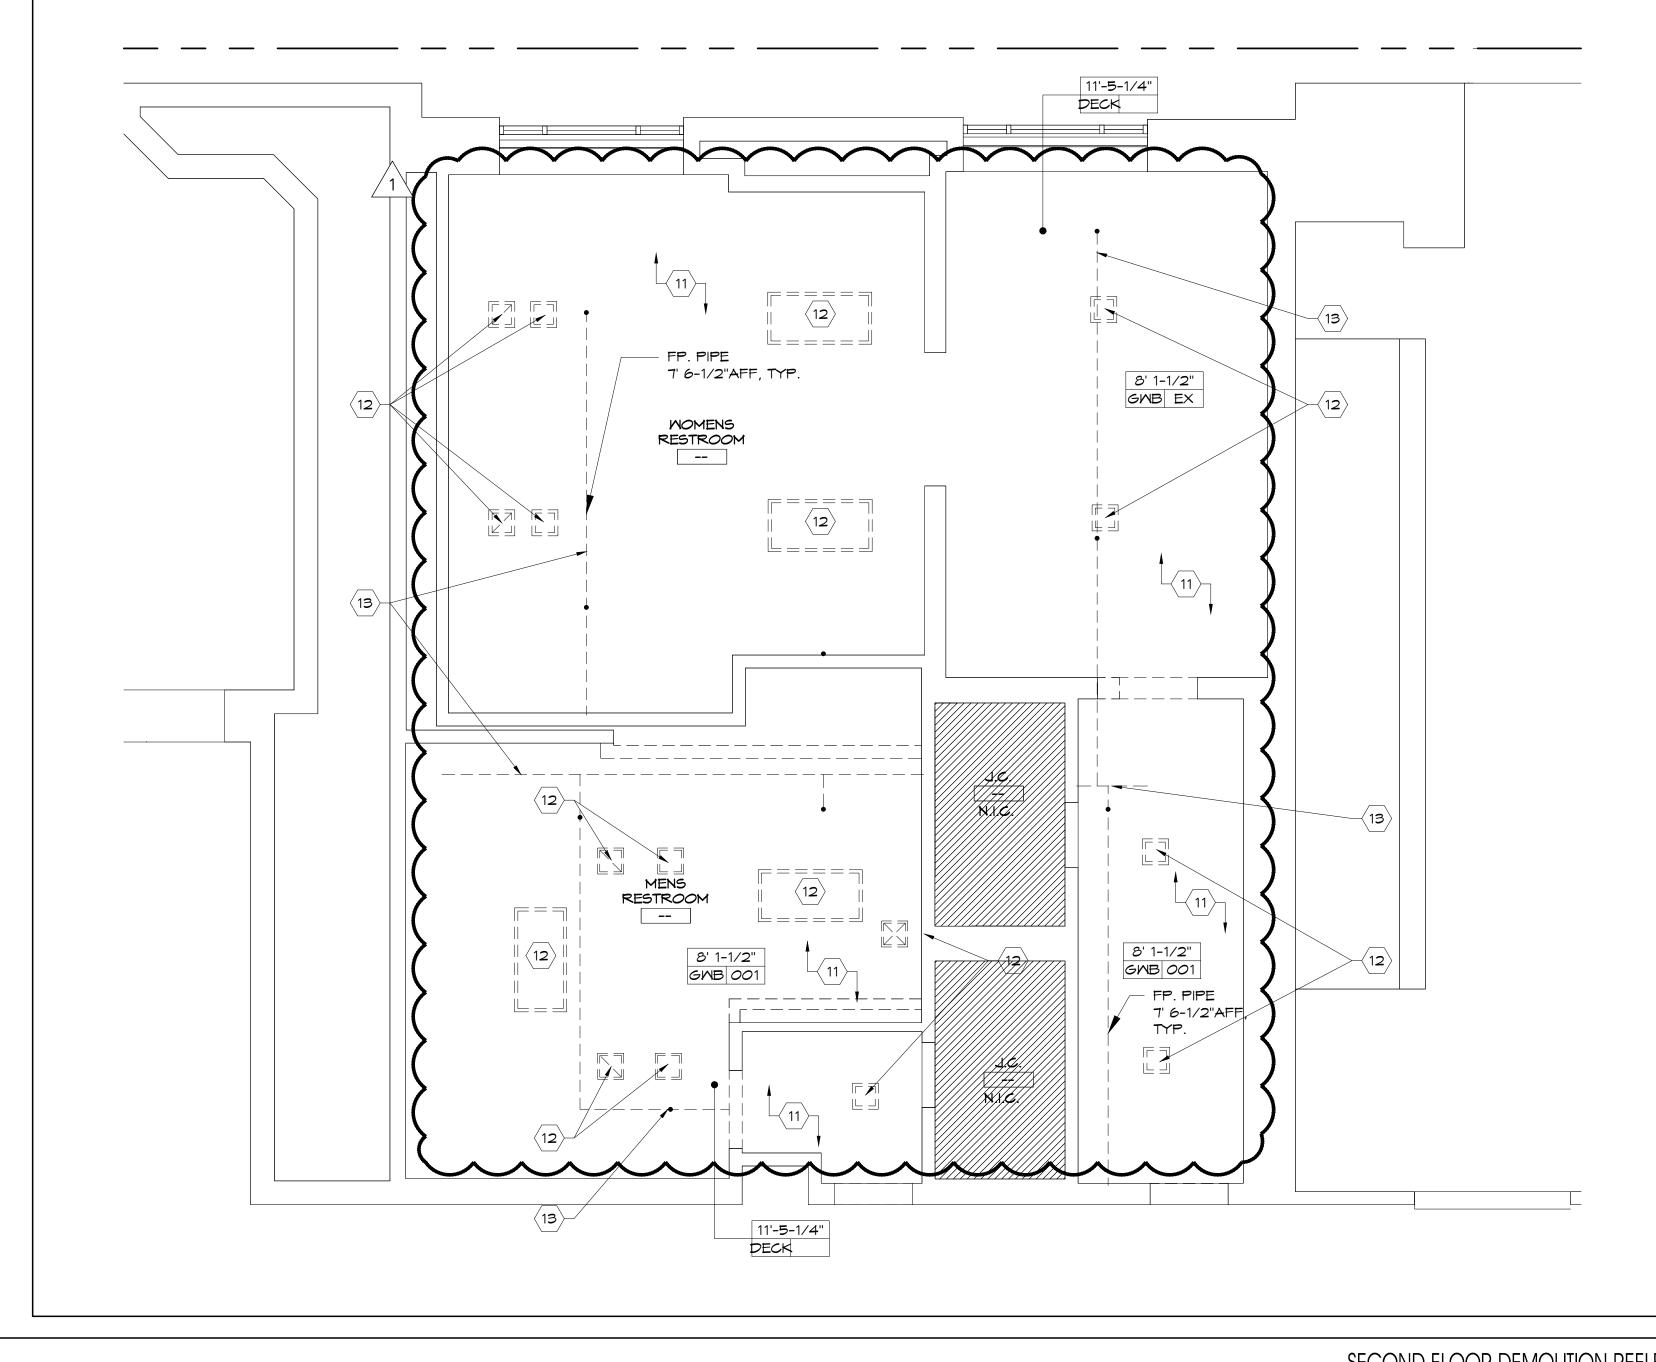


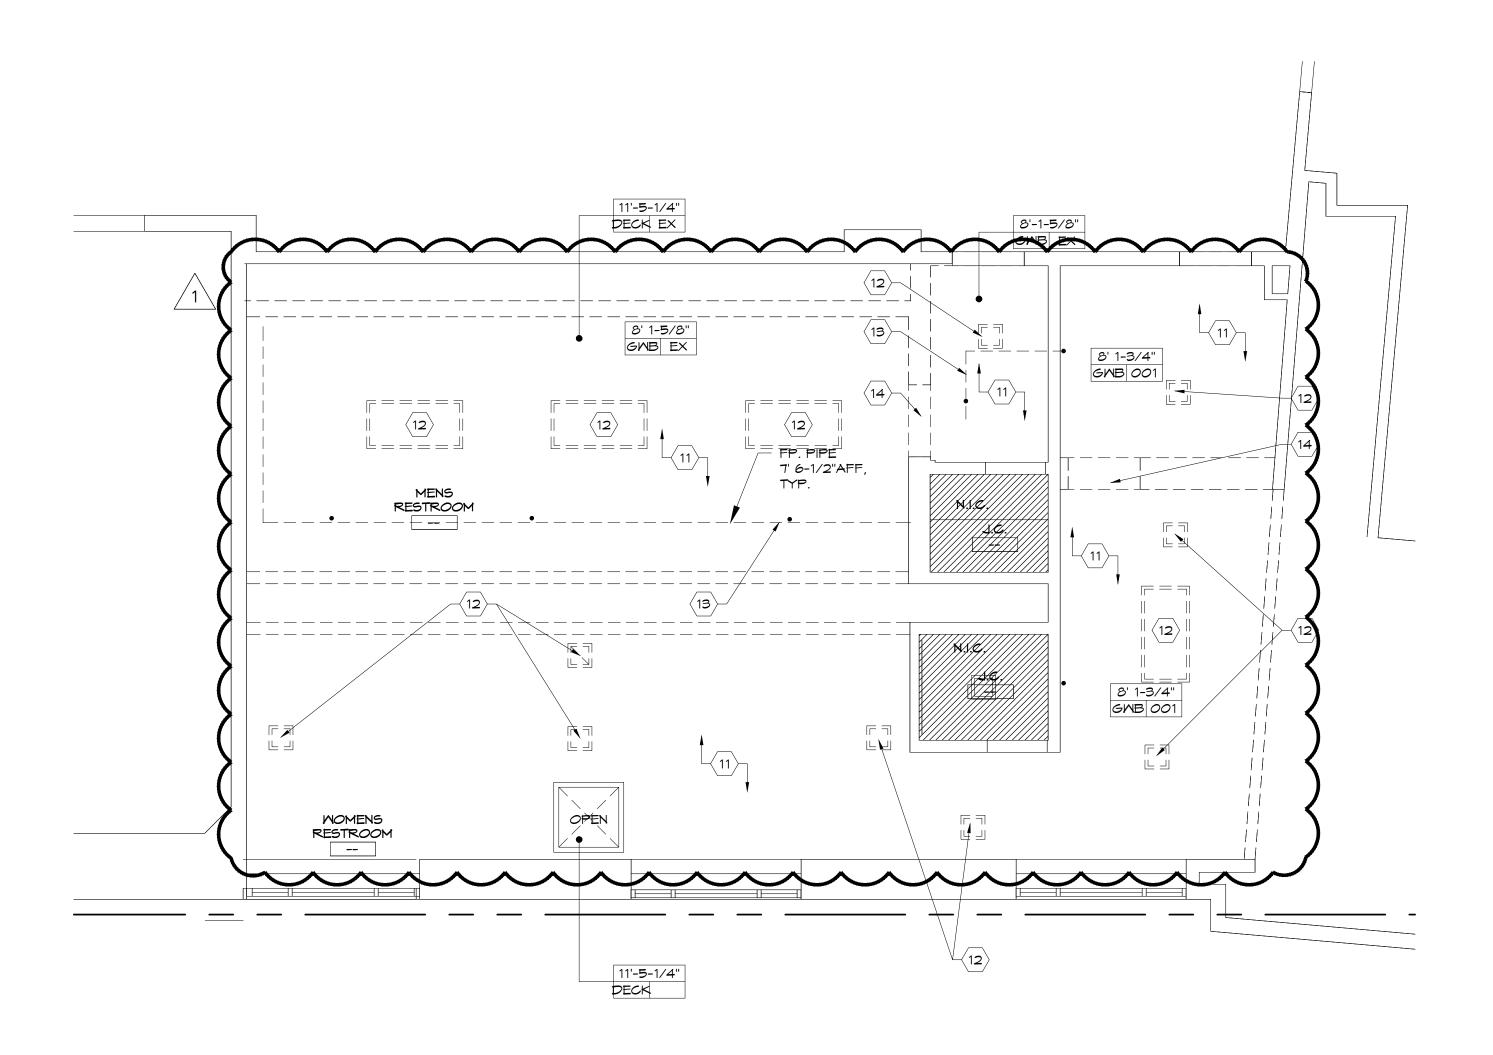


SCALE SECOND FLOOR DEMOLITION REFLECTED CEILING PLAN - MEN'S AND WOMEN'S RESTROOM EAST 1/4"=1'-0"


Atlantic City, NJ 08401 T: 609.345.5222 F: 609.345.7486 Konstantic City, NJ 08401 T: 609.345.7486 Konstantic City, NJ 08401 T: 212.246.2770 F: 212.246.2770 F: 212.246.2770 F: 212.246.2770 F: 212.246.2770 F: 212.246.2770
Thomas J. Sykes, A.I.A., P.P. Founding Principal William A. Salerno, A.I.A., P.P. Founding Principal Nory Hazaveh, A.I.A., P.P. Founding Principal Mark Petrella, A.I.A. Principal Christopher M. Menchin, NCARB Principal Kimberly McCarron, NCARB Principal
Control of the second s
SUBMISSIONS
I I I I
SECOND FLOOR RESTROOM DEMOLITION REFLECTED CEILING PLAN
DRAWN BY: PS DRAWING NO. REVIEWED BY: CM PROJECT NO. 15243.00.001 ADJ-202

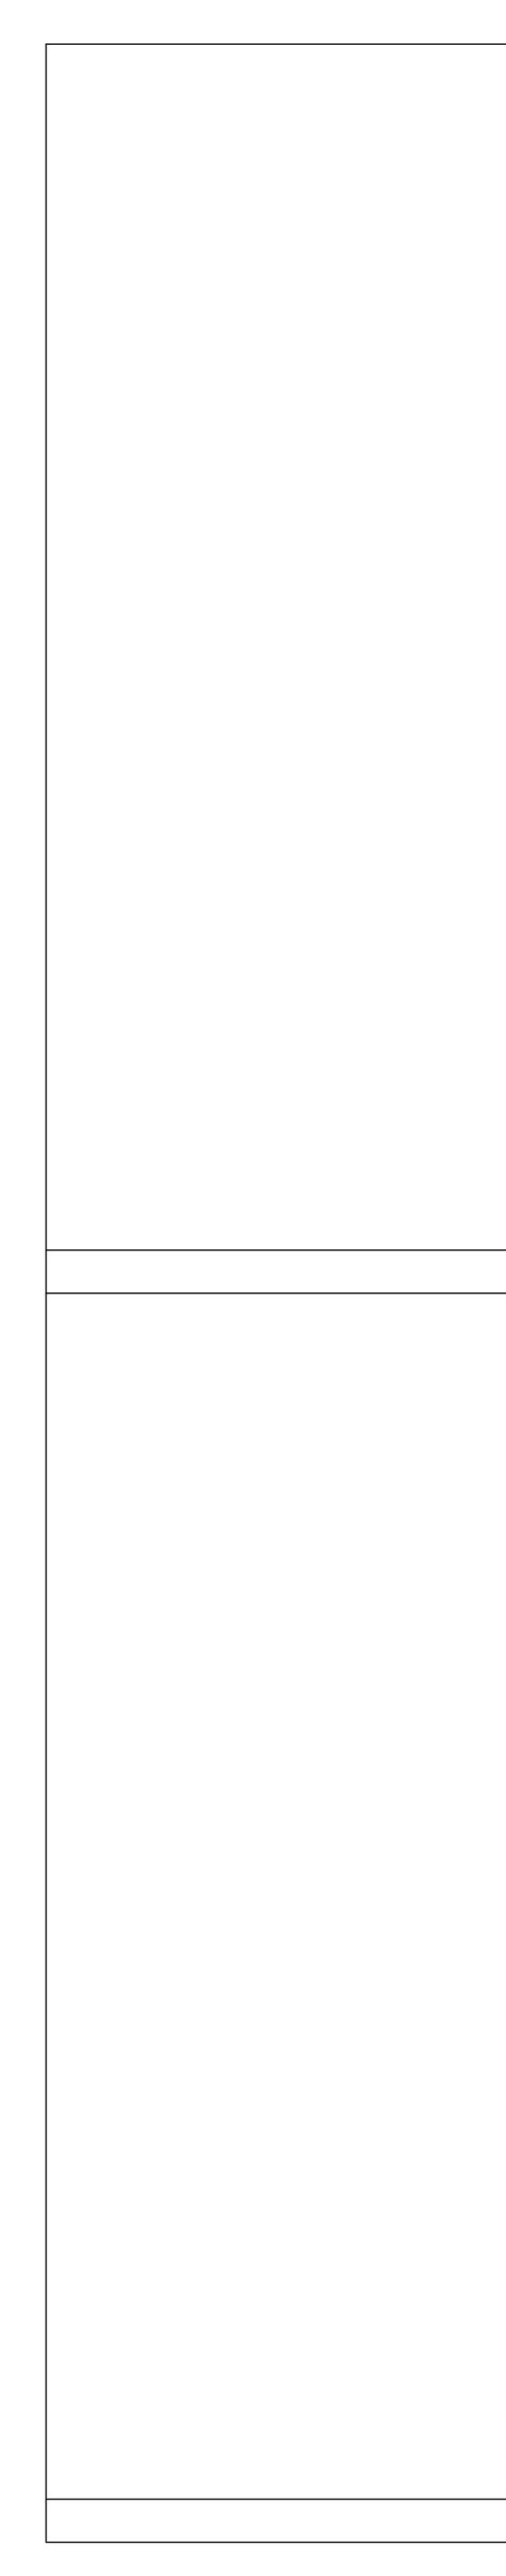


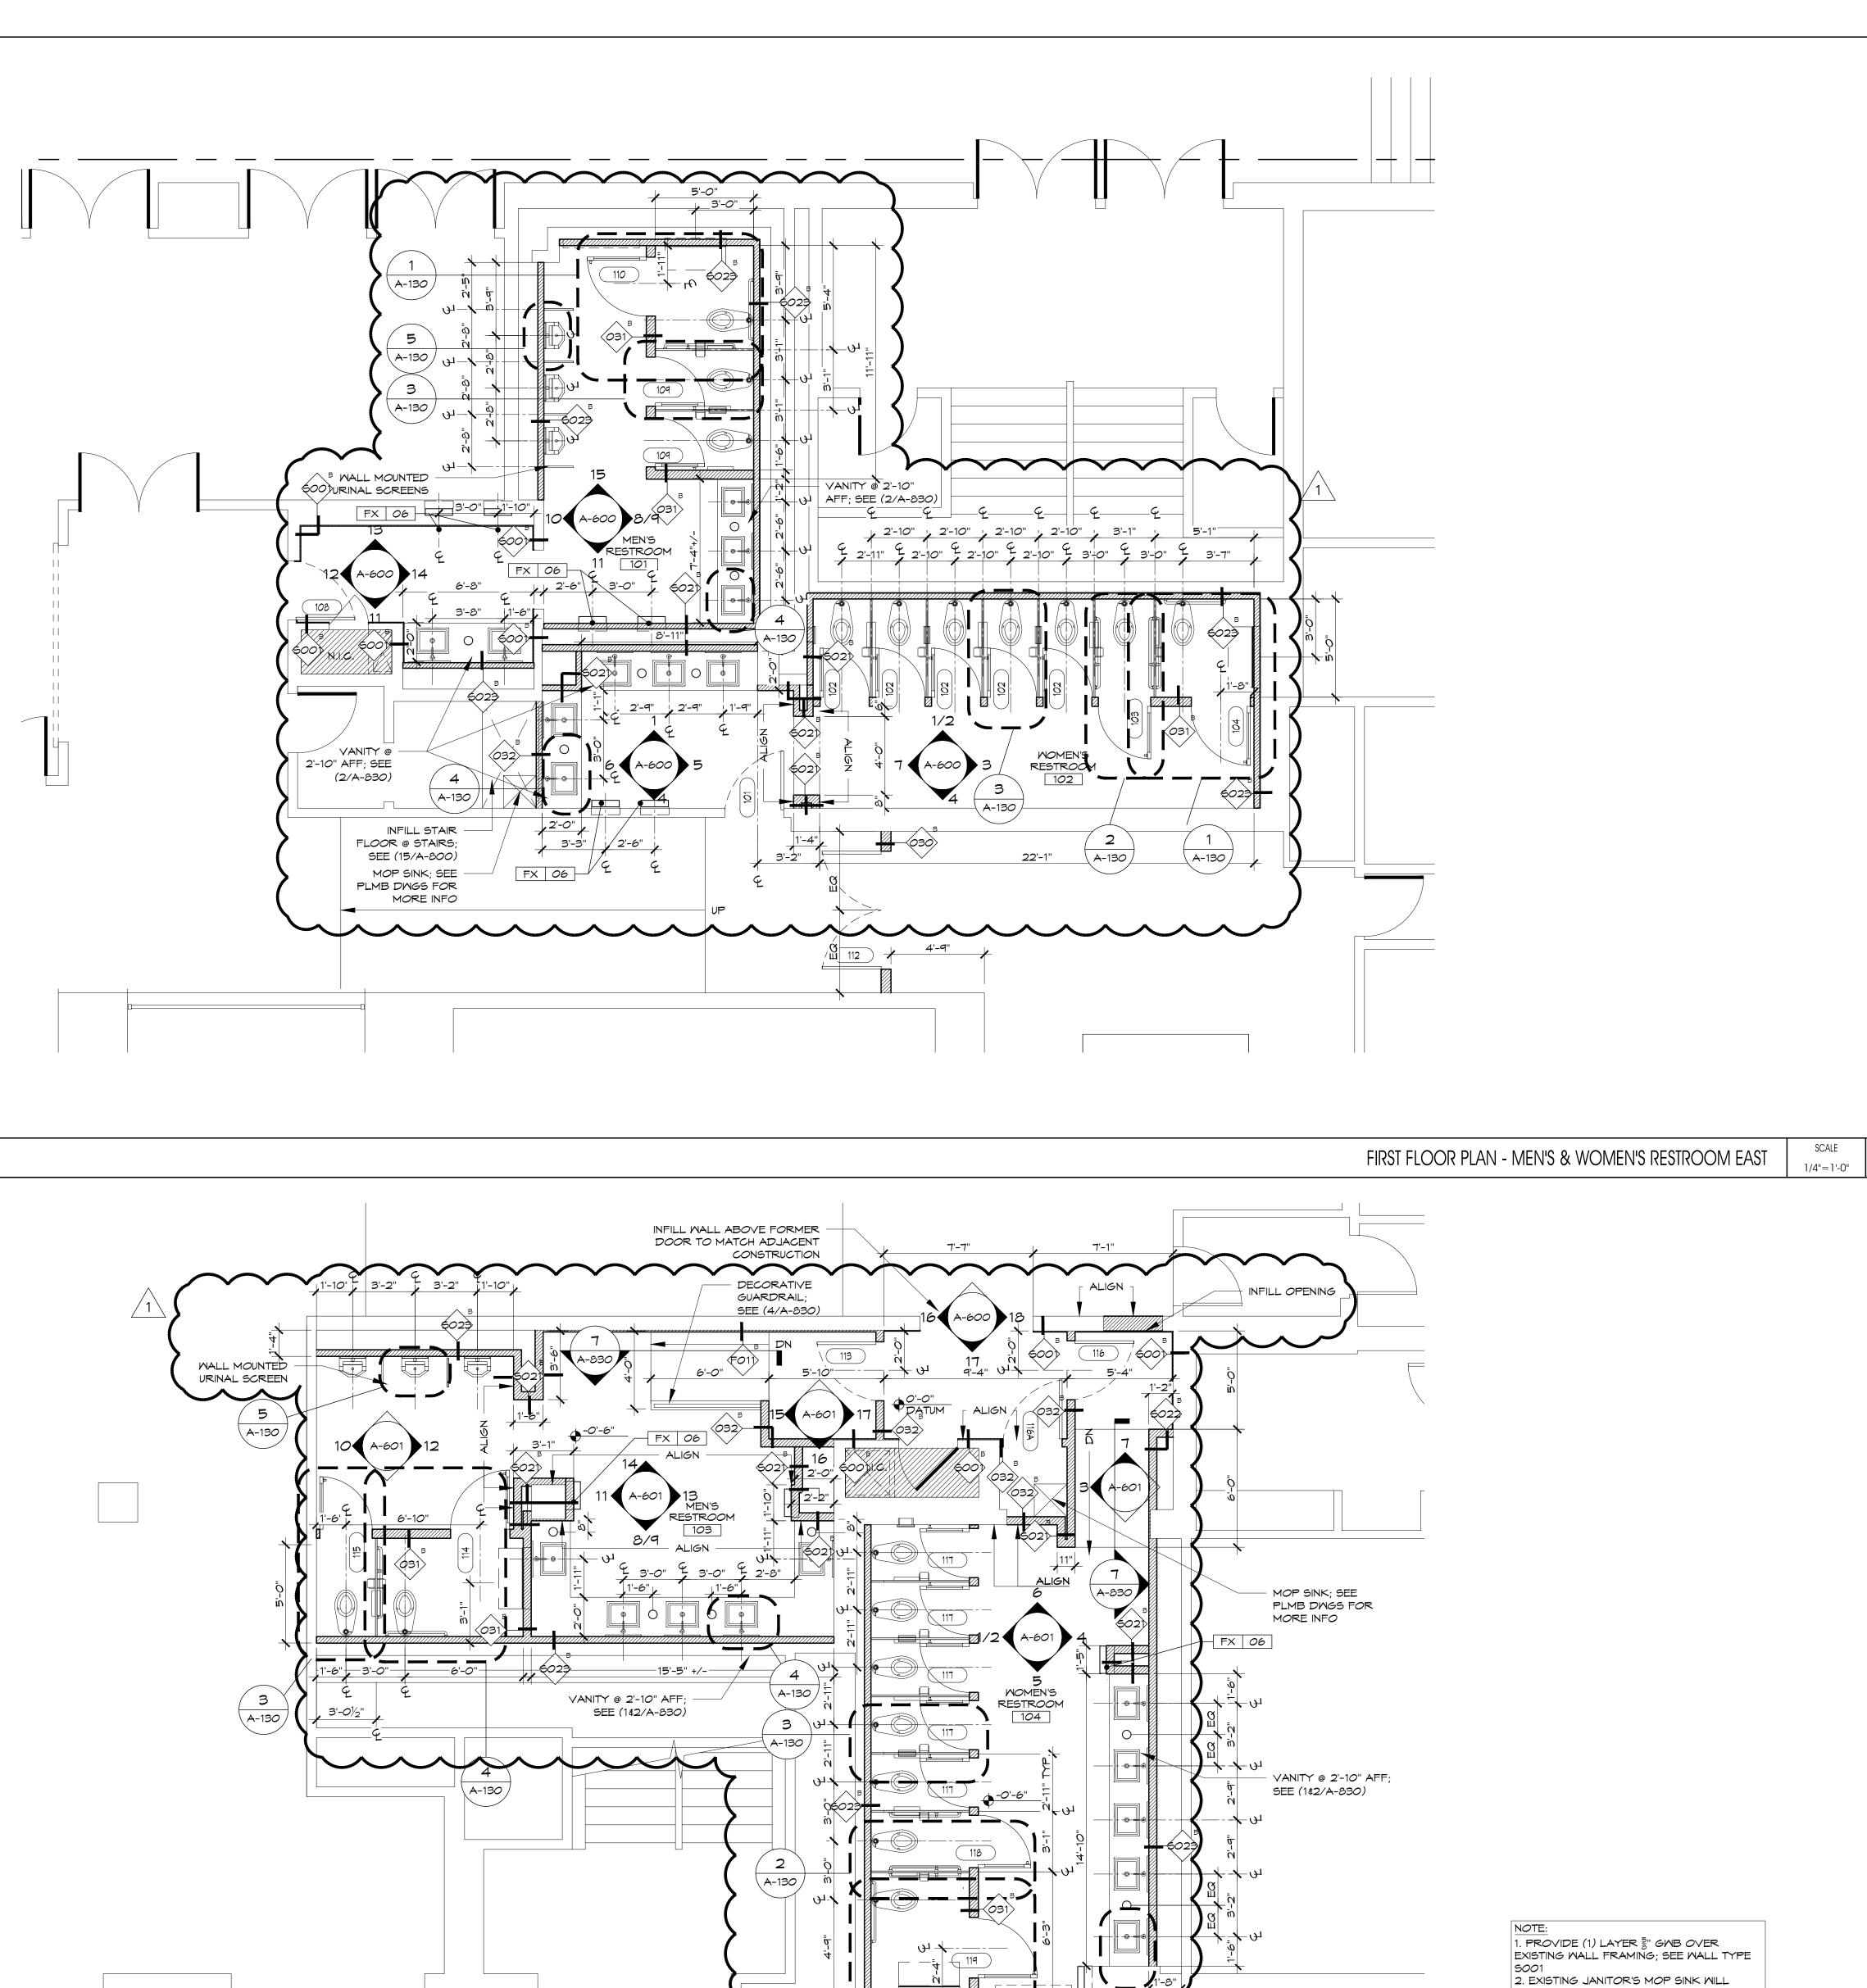


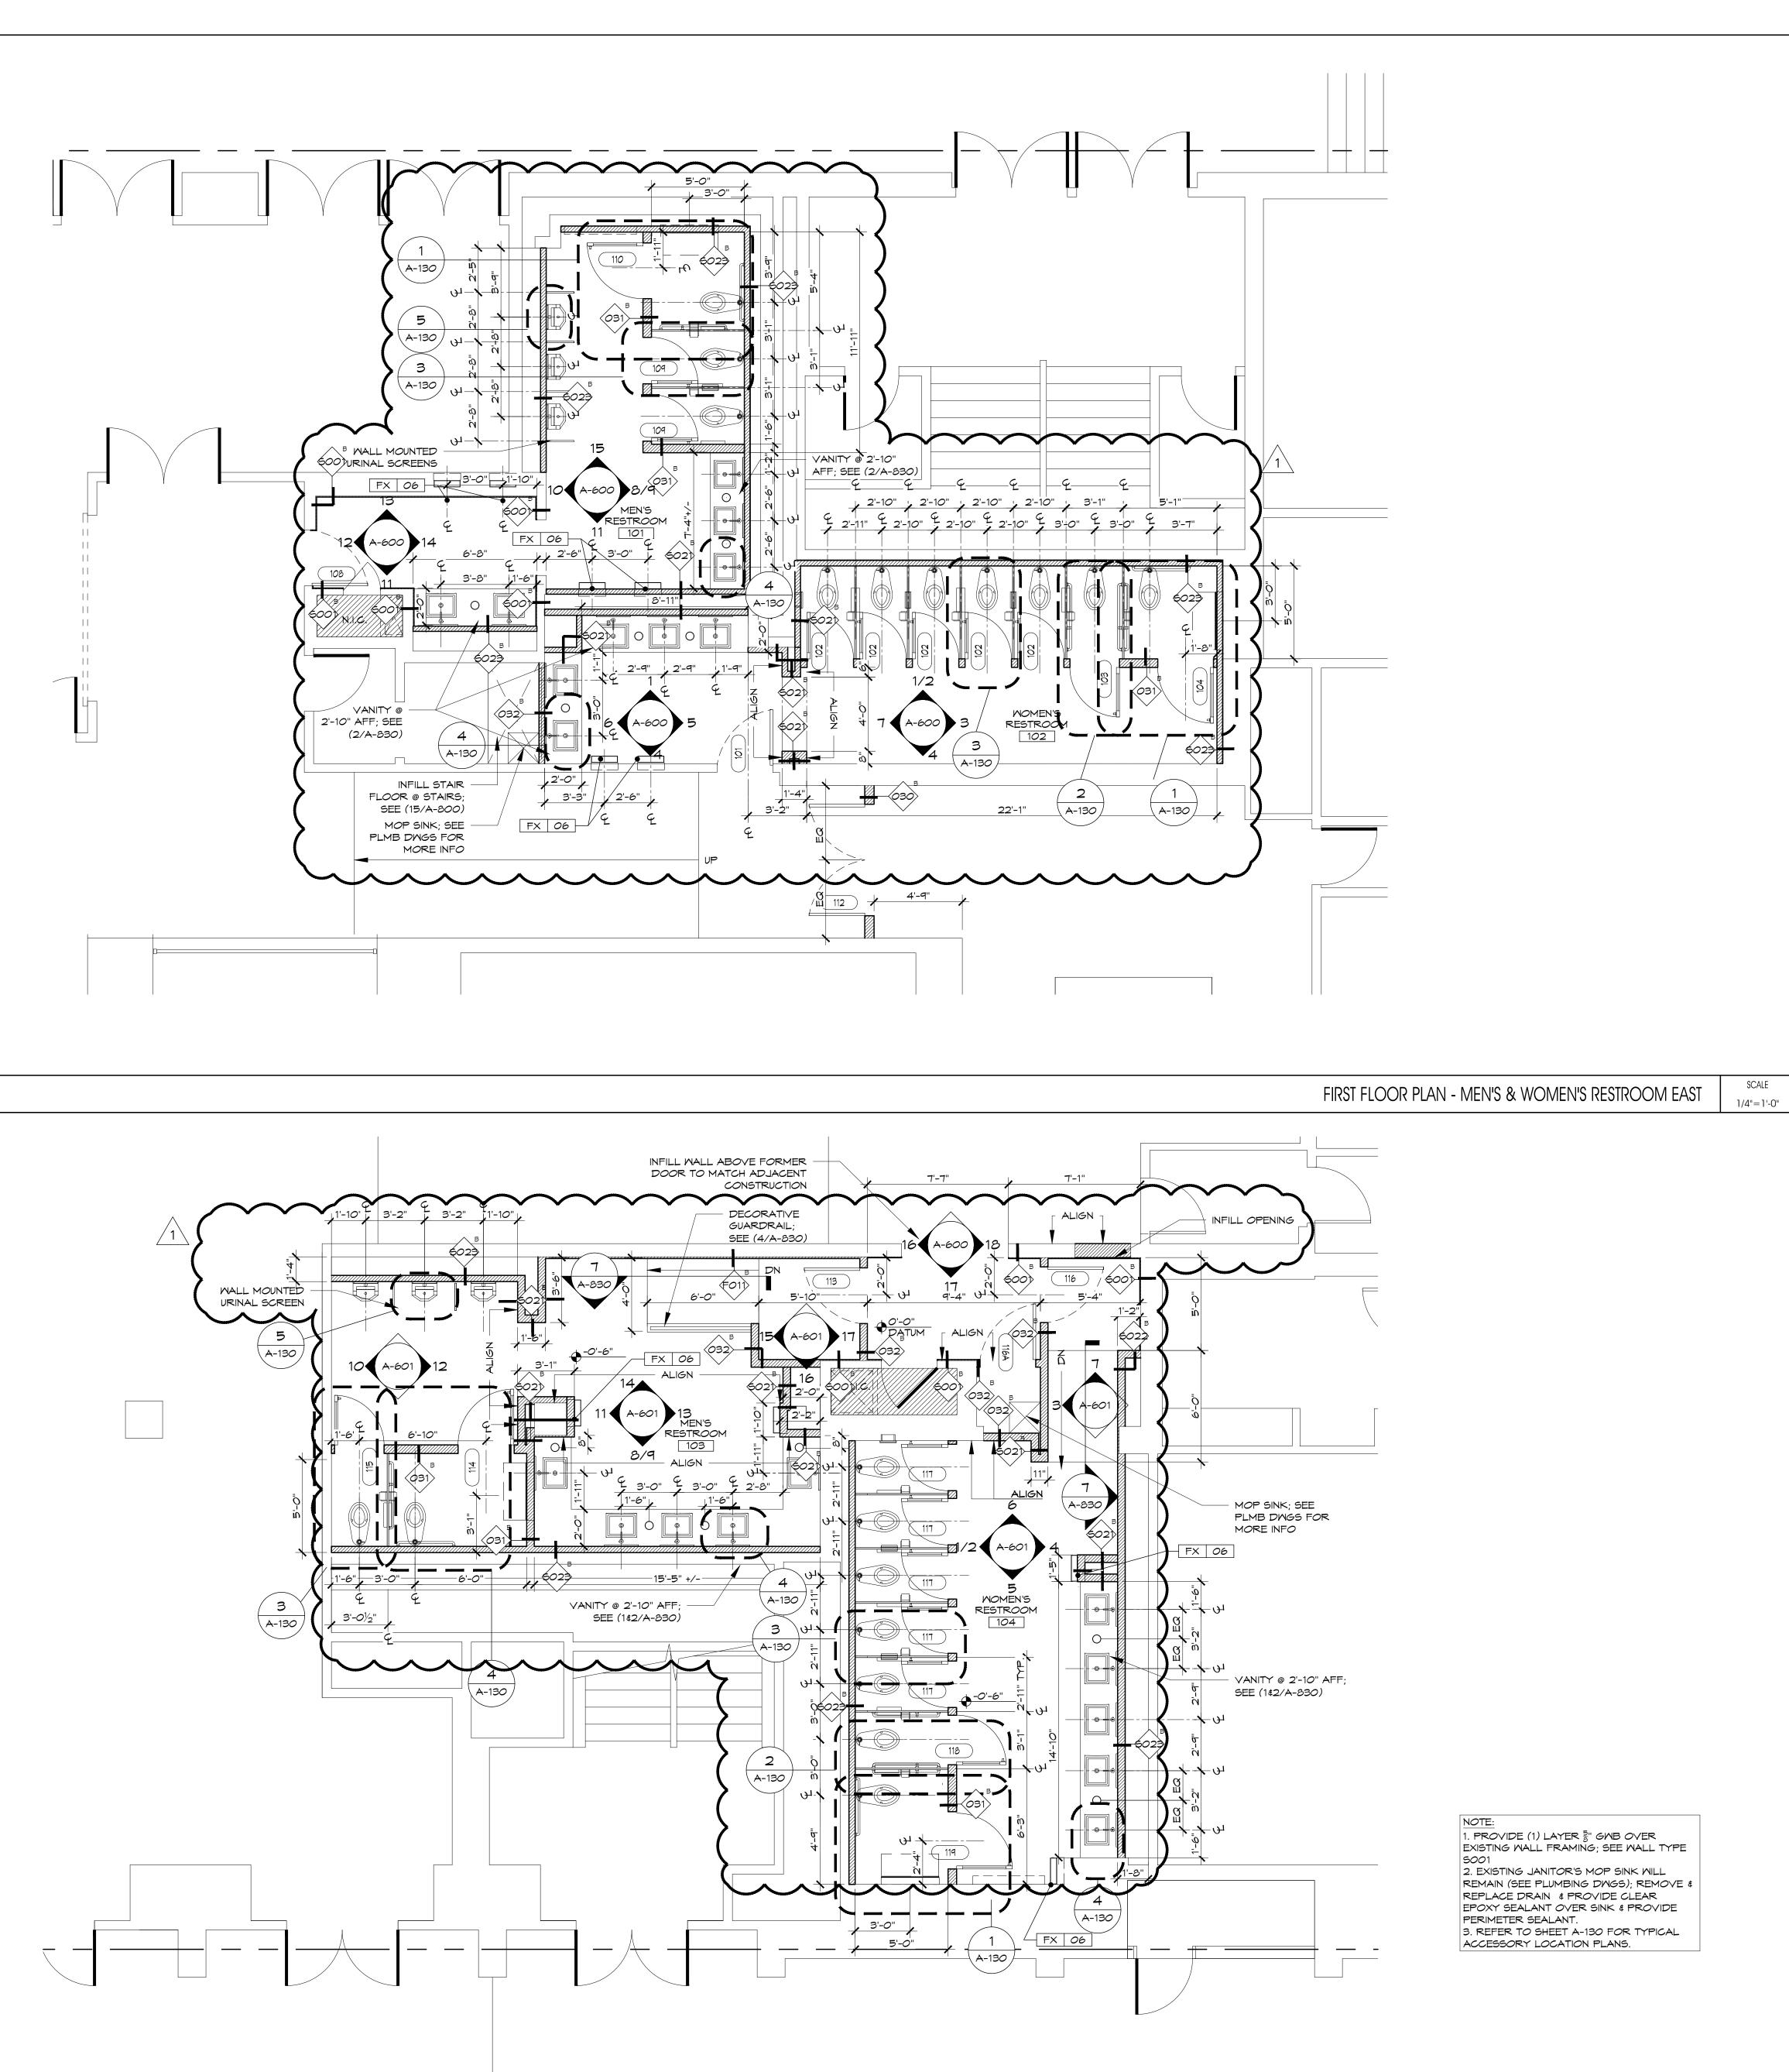




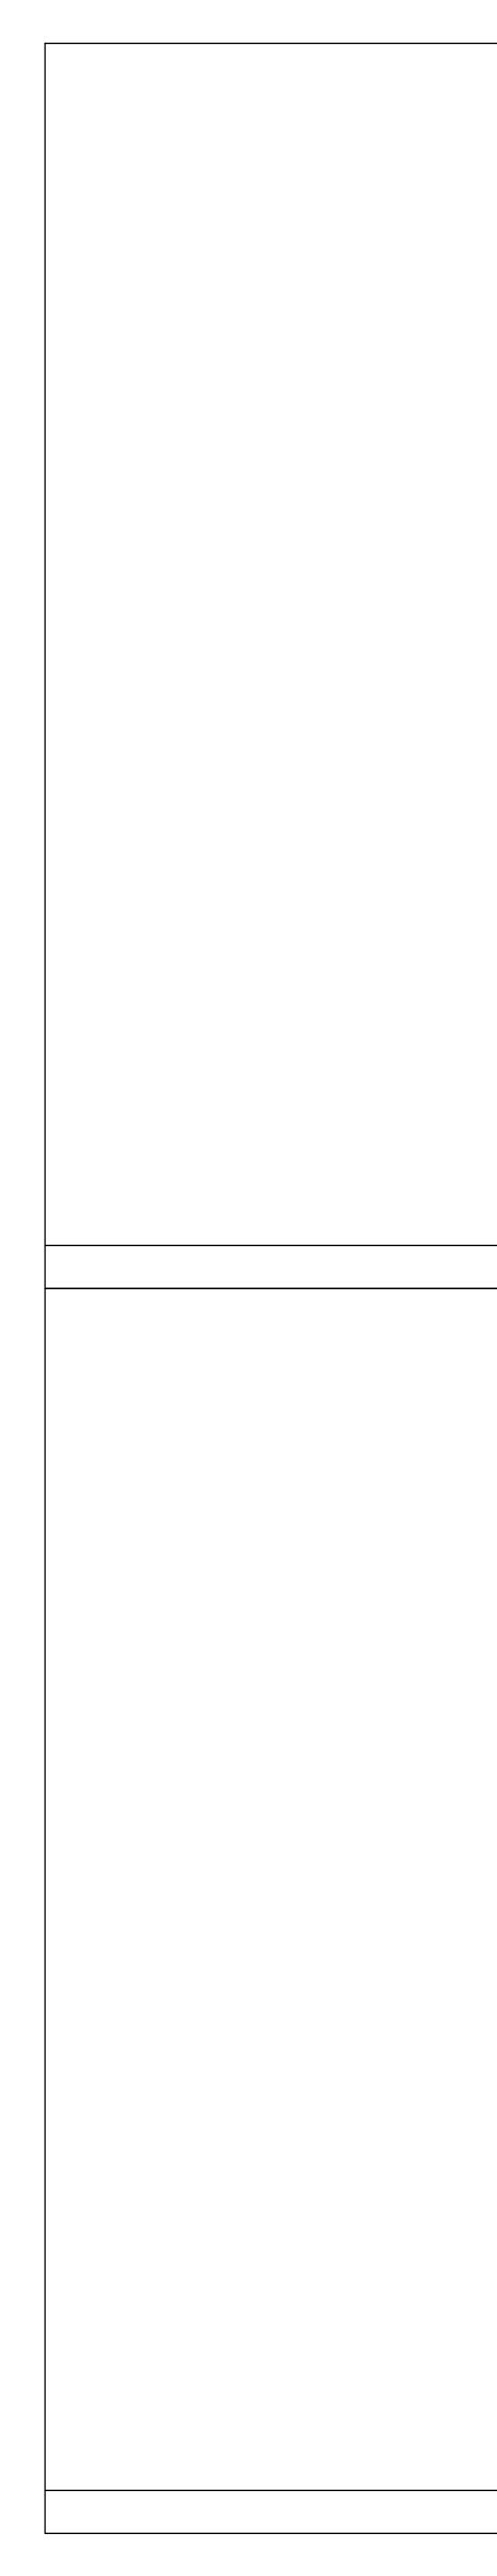

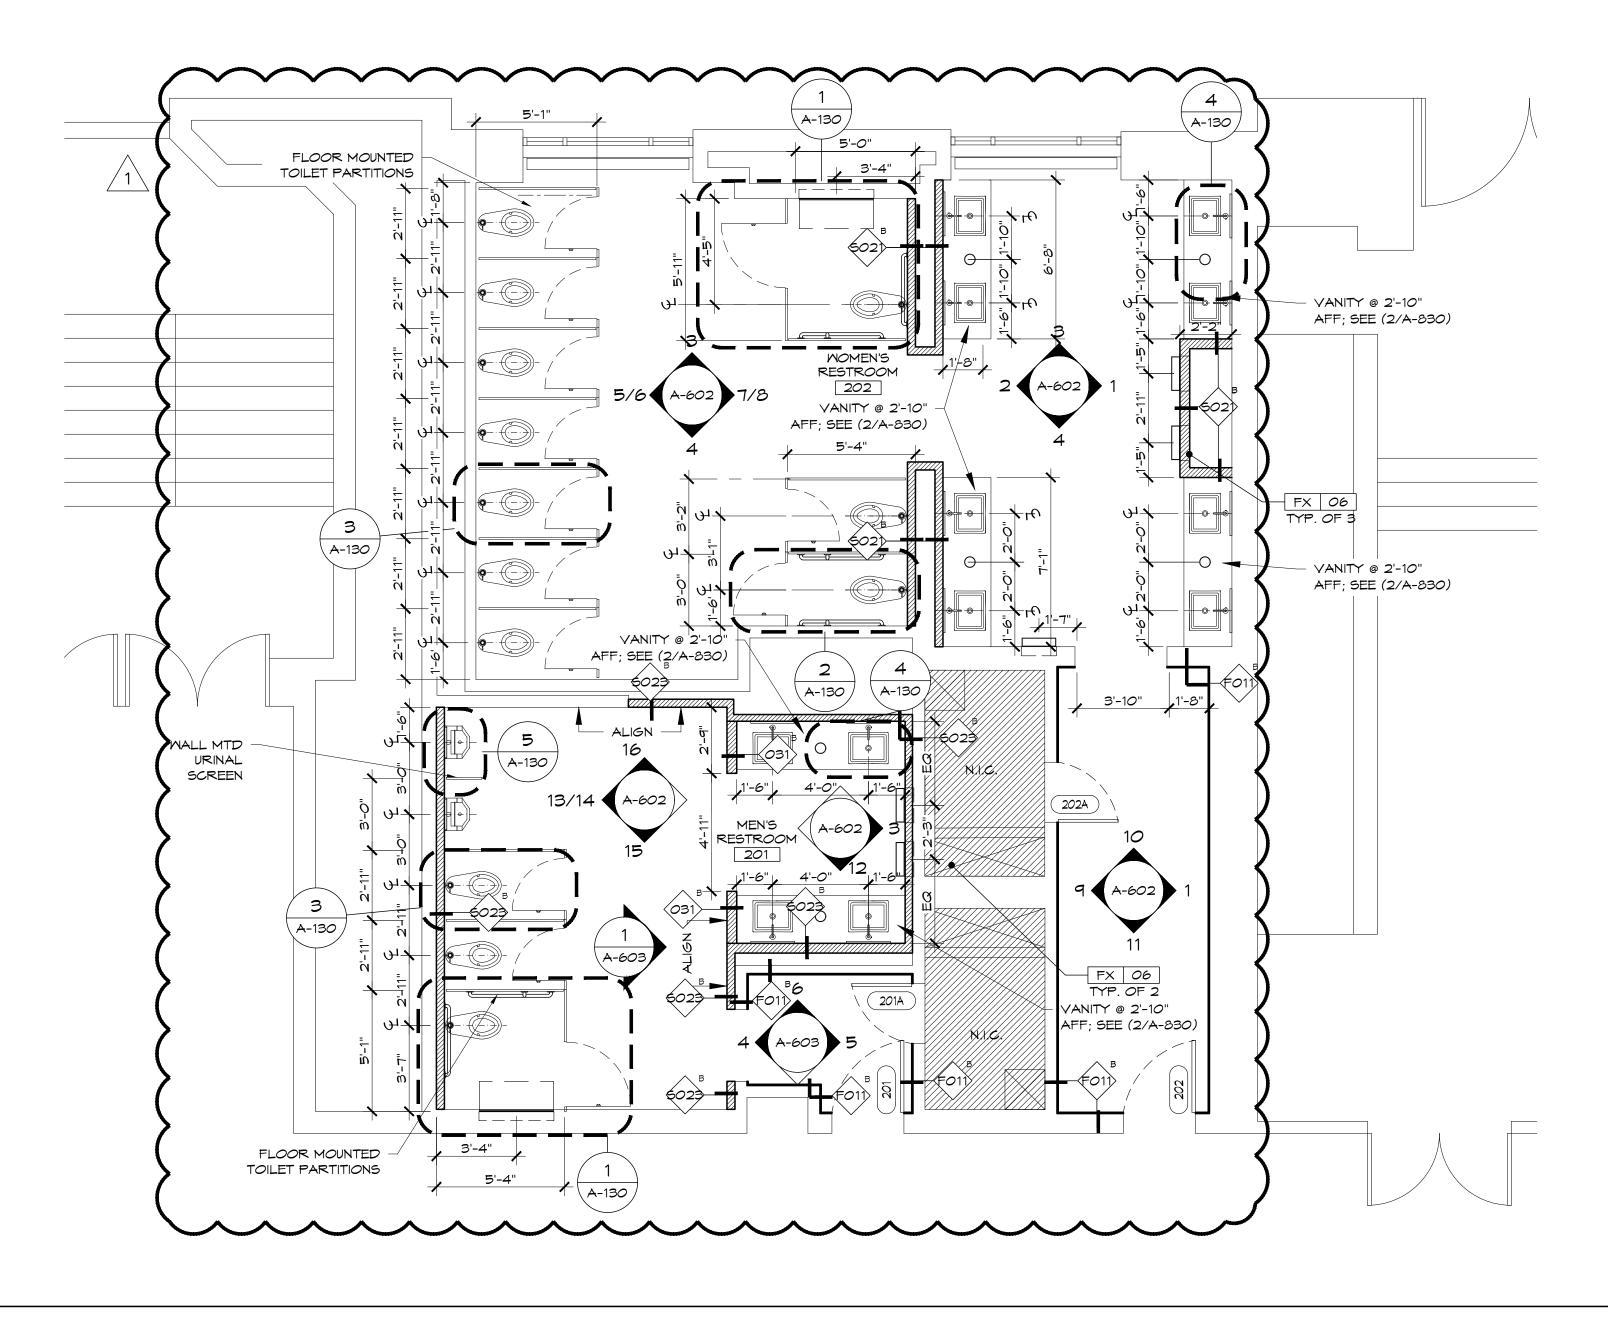

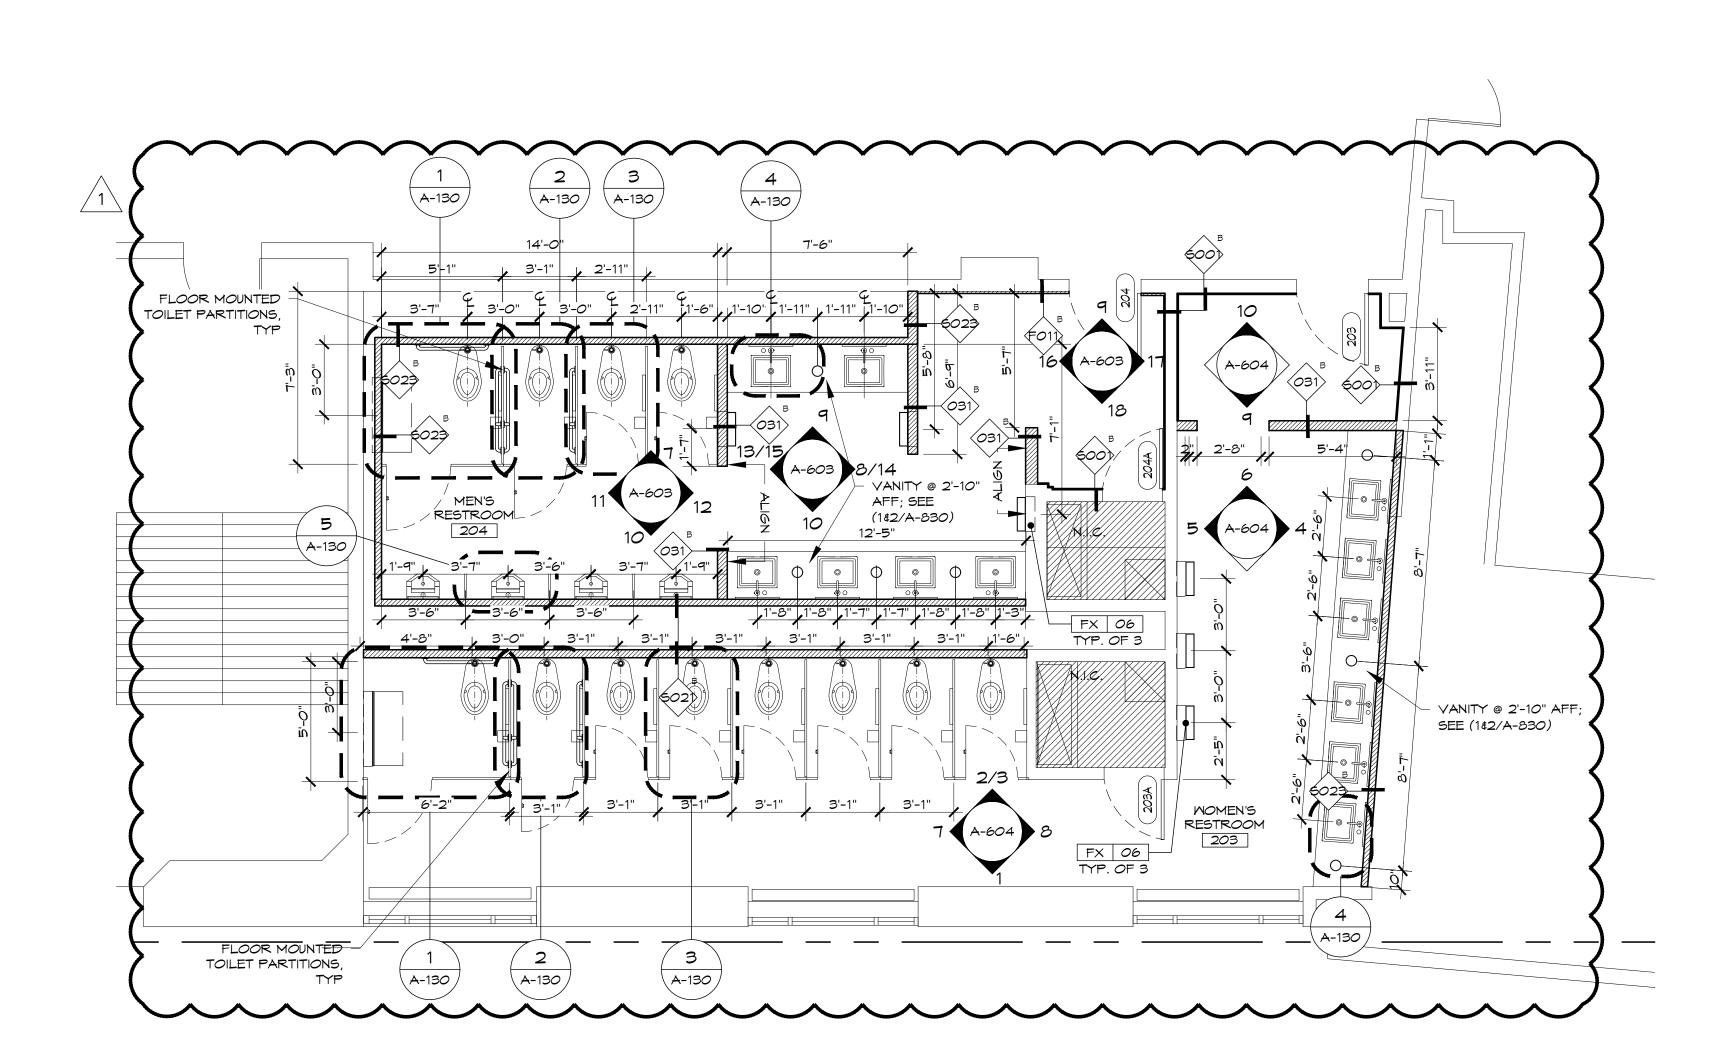


SECOND FLOOR PLAN - MEN'S & WOMEN'S RESTROOM EAST 1/4"=1'-0"

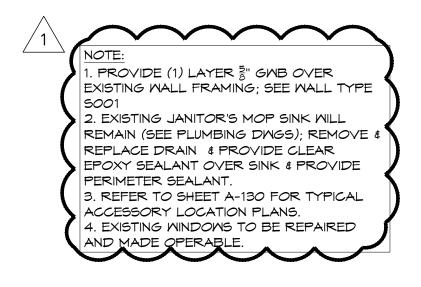





SCALE

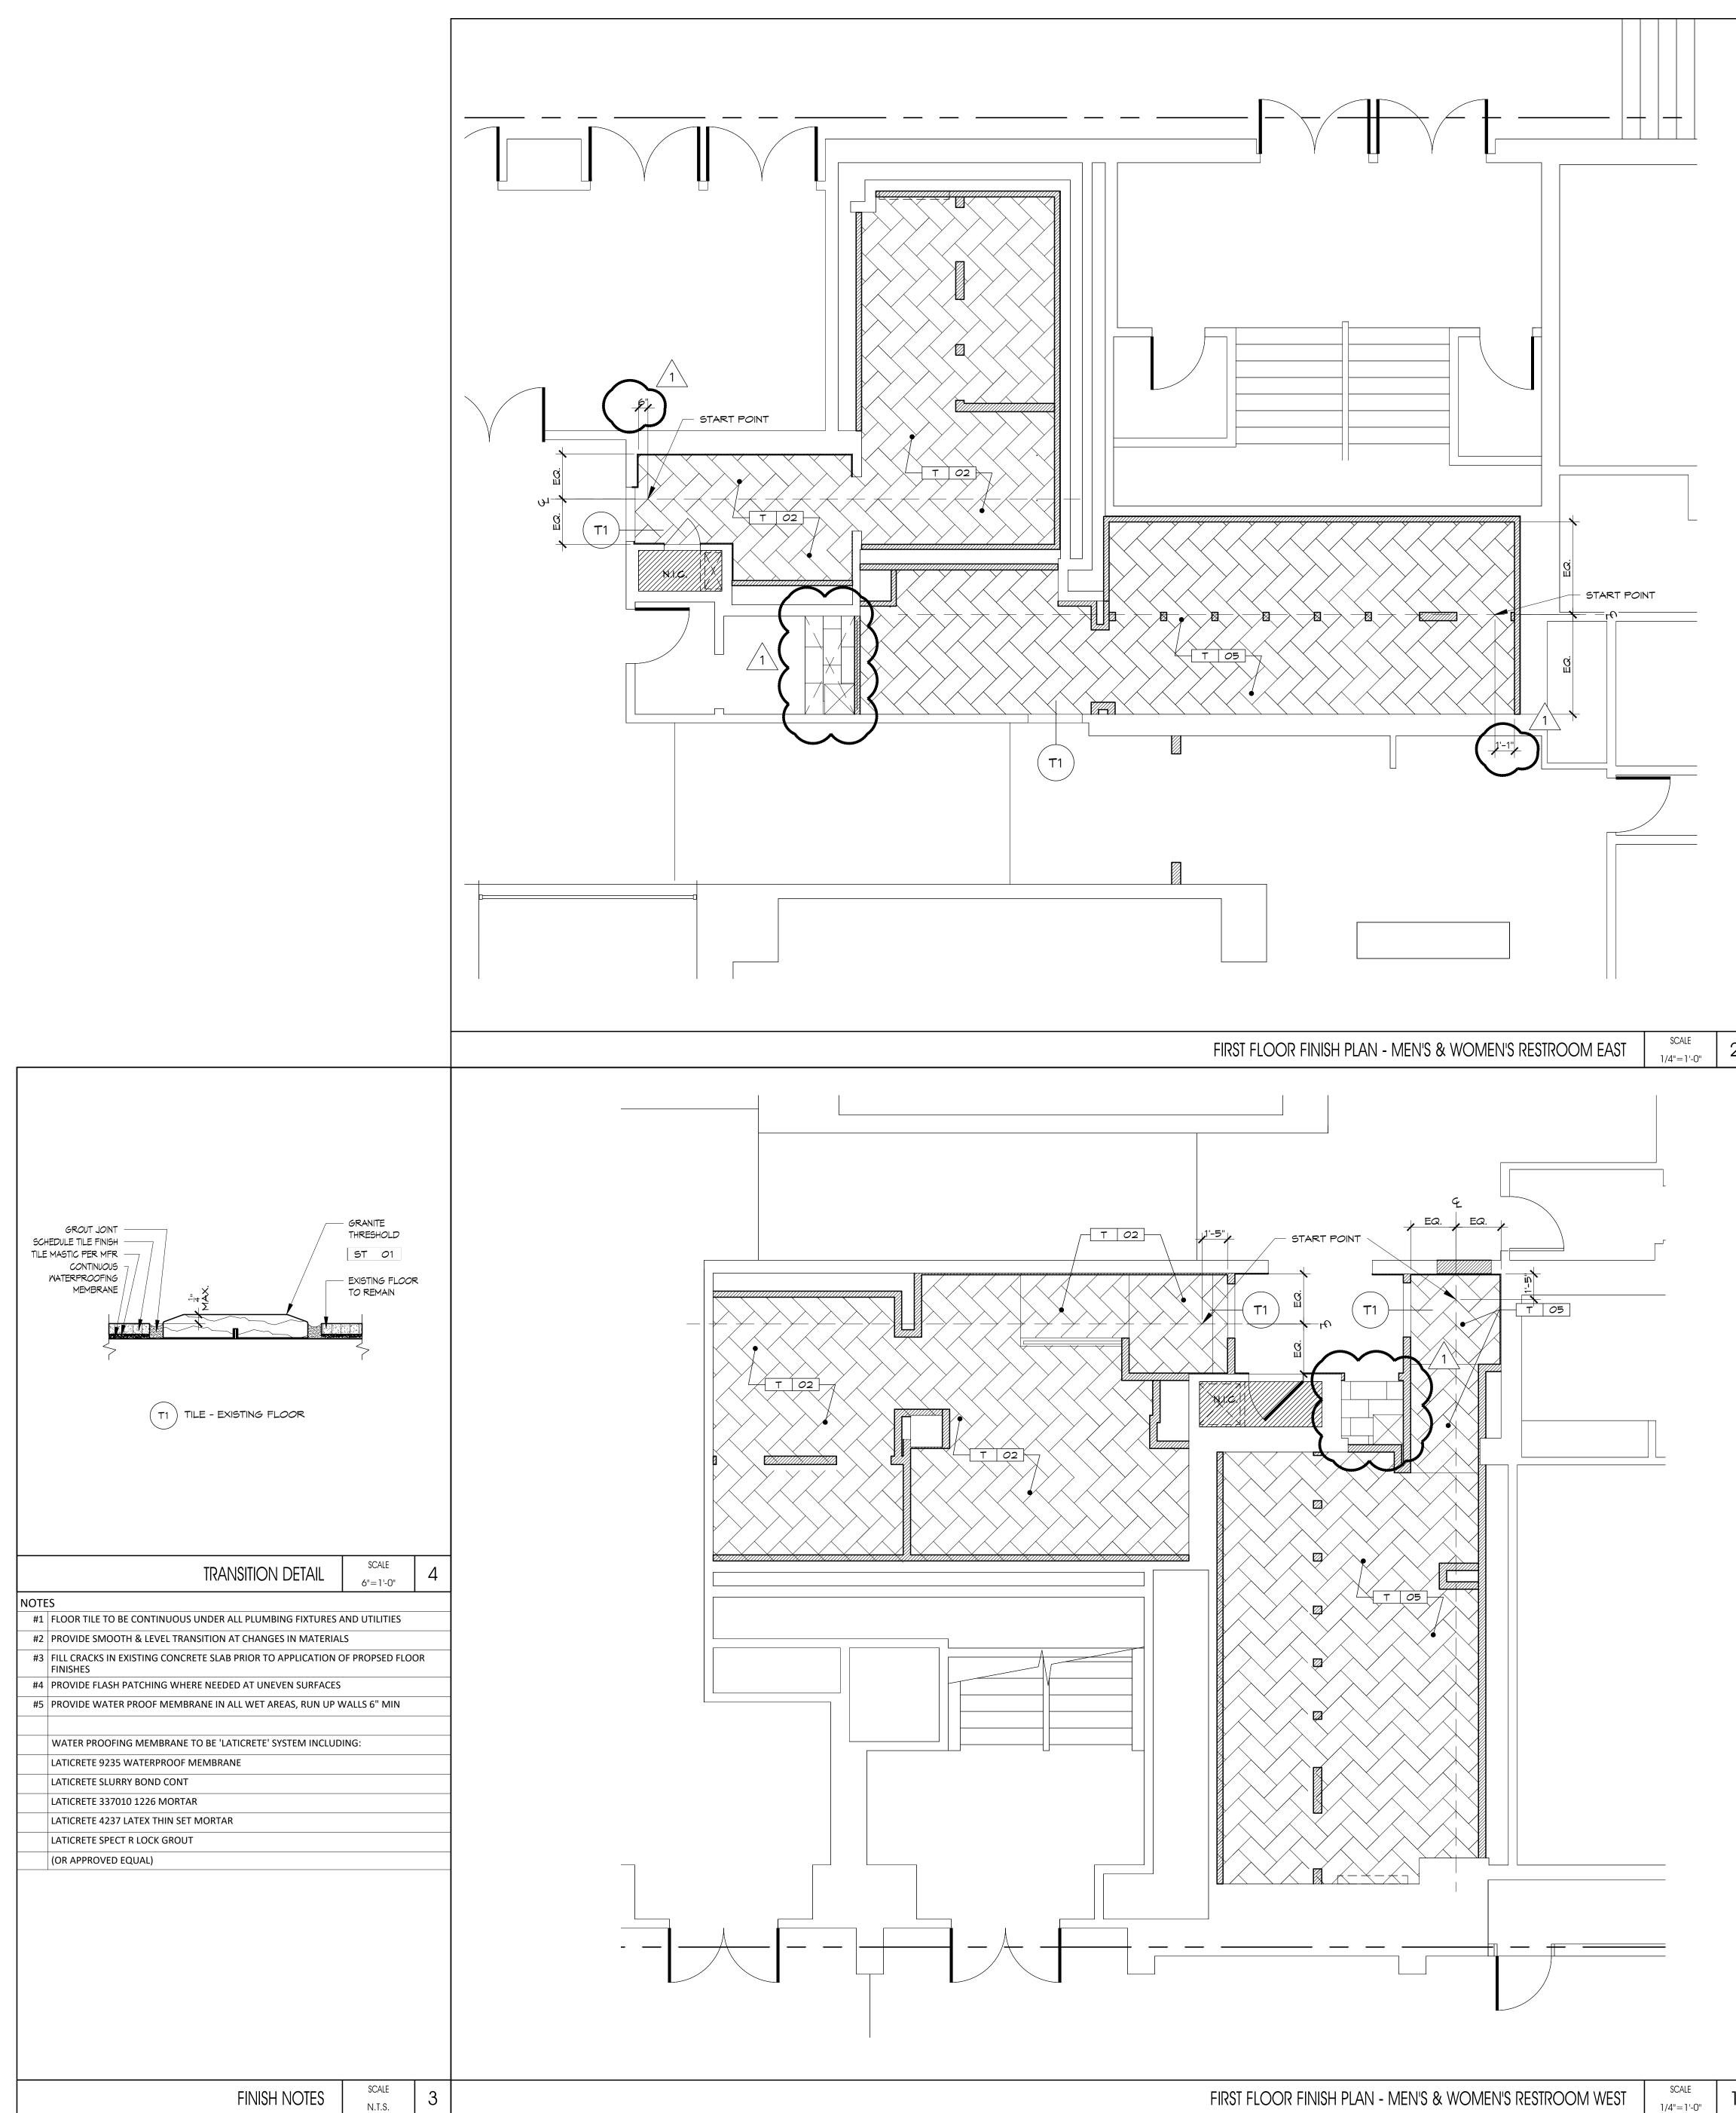

Solution Solution atlantic city new york 1020 Atlantic Avenue new york Atlantic City, NJ 08401 145 West 57th Street T: 609.345.5222 New York, NY 10019 F: 609.345.7486 F: 212.246.277
www.sosharch.com Thomas J. Sykes, A.I.A., P.P. Founding Principal William A. Salerno, A.I.A., P.P. Founding Principal Nory Hazaveh, A.I.A., P.P. Founding Principal Mark Petrella, A.I.A. Principal Christopher M. Menchin, NCARB Principal Kimberly McCarron, NCARB Principal
 w w w . s o s h a r c h . c o m
Boardwalk Hall Your BEST SEAT AT THE SHEME
AC BOARDWALK HALL RESTROOM RENOVATION 2301 BOARDWALK, ATLANTIC CITY, NJ 08401
SUBMISSIONS
1 2016.11.30 ADDENDUM #2
NO. DATE: DESCRIPTION:
DRAWING TITLE: FIRST FLOOR RESTROOM FLOOR FINISH PLANS
DRAWN BY: SB DRAWING NO. REVIEWED BY: CM PROJECT NO. 15243.00.001

#1		AND UTILITIES			
#2	PROVIDE SMOOTH & LEVEL TRANSITION AT CHANGES IN MATERIAI	LS			
#3	#3 FILL CRACKS IN EXISTING CONCRETE SLAB PRIOR TO APPLICATION OF PROPSED FLOOR FINISHES				
#4	#4 PROVIDE FLASH PATCHING WHERE NEEDED AT UNEVEN SURFACES				
#5	#5 PROVIDE WATER PROOF MEMBRANE IN ALL WET AREAS, RUN UP WALLS 6" MIN				
	WATER PROOFING MEMBRANE TO BE 'LATICRETE' SYSTEM INCLUD	ING:			
	LATICRETE 9235 WATERPROOF MEMBRANE				
	LATICRETE SLURRY BOND CONT				
	LATICRETE 337010 1226 MORTAR				
	LATICRETE 4237 LATEX THIN SET MORTAR				
	LATICRETE SPECT R LOCK GROUT				
	(OR APPROVED EQUAL)				
	FINISH NOTES	SCALE N.T.S.	3		

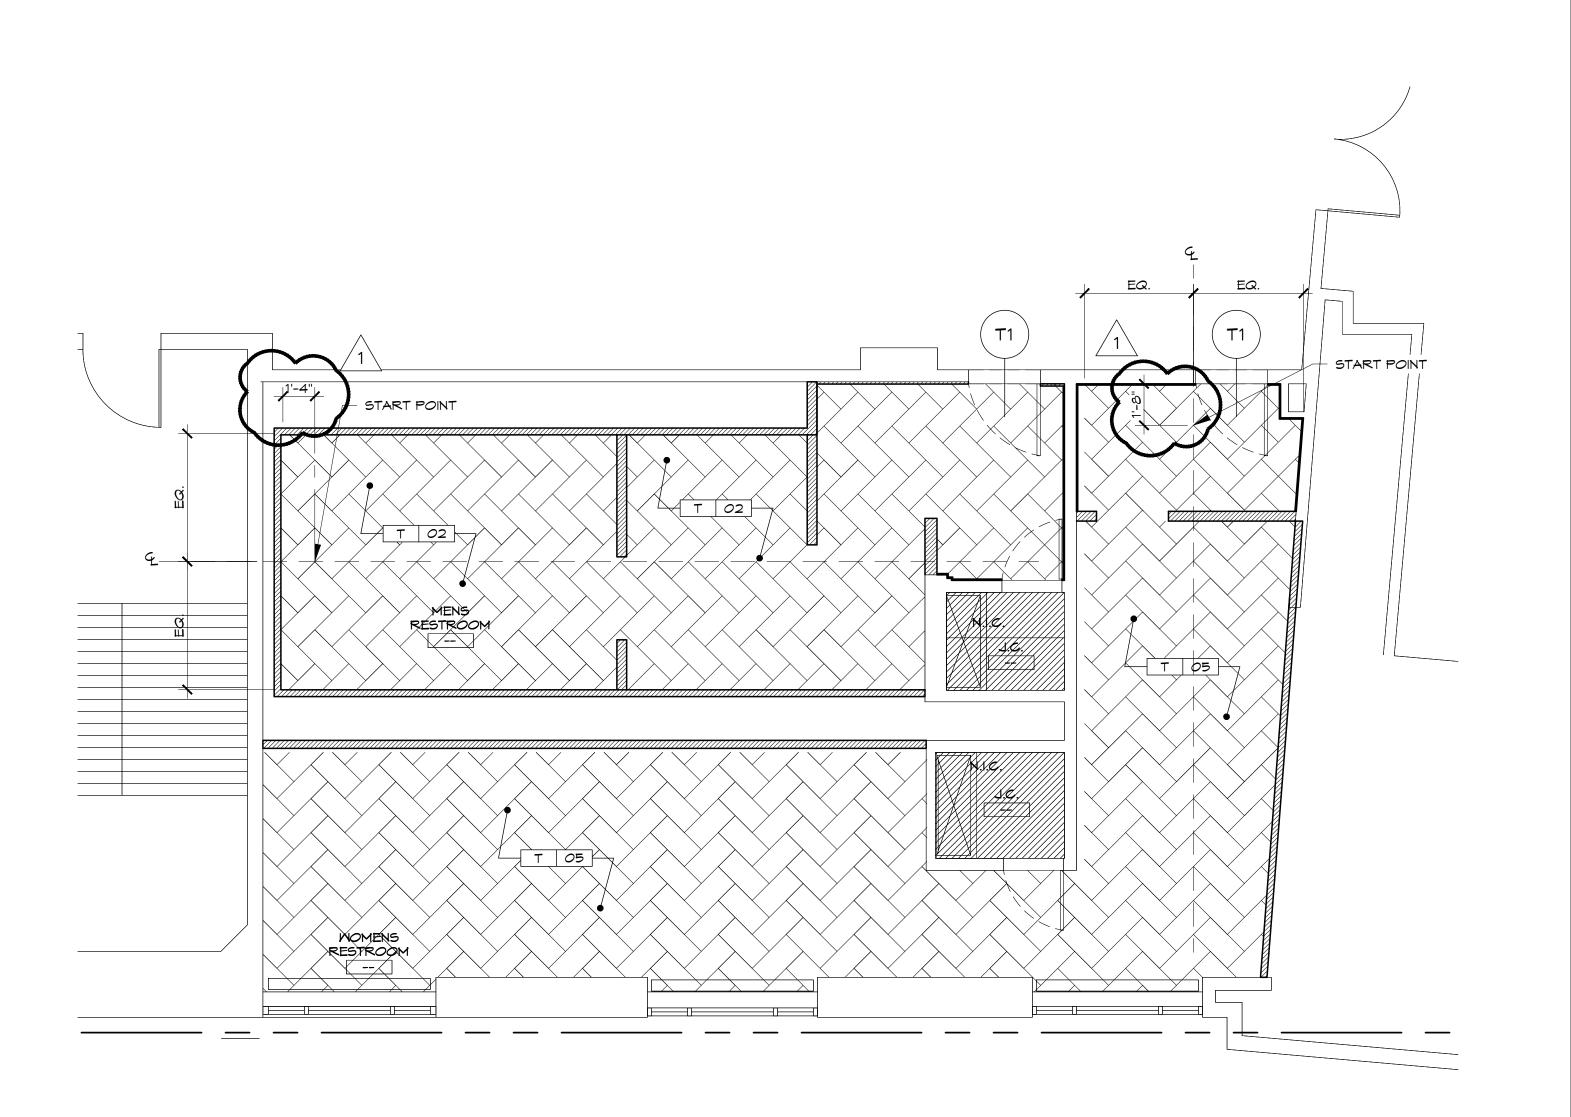


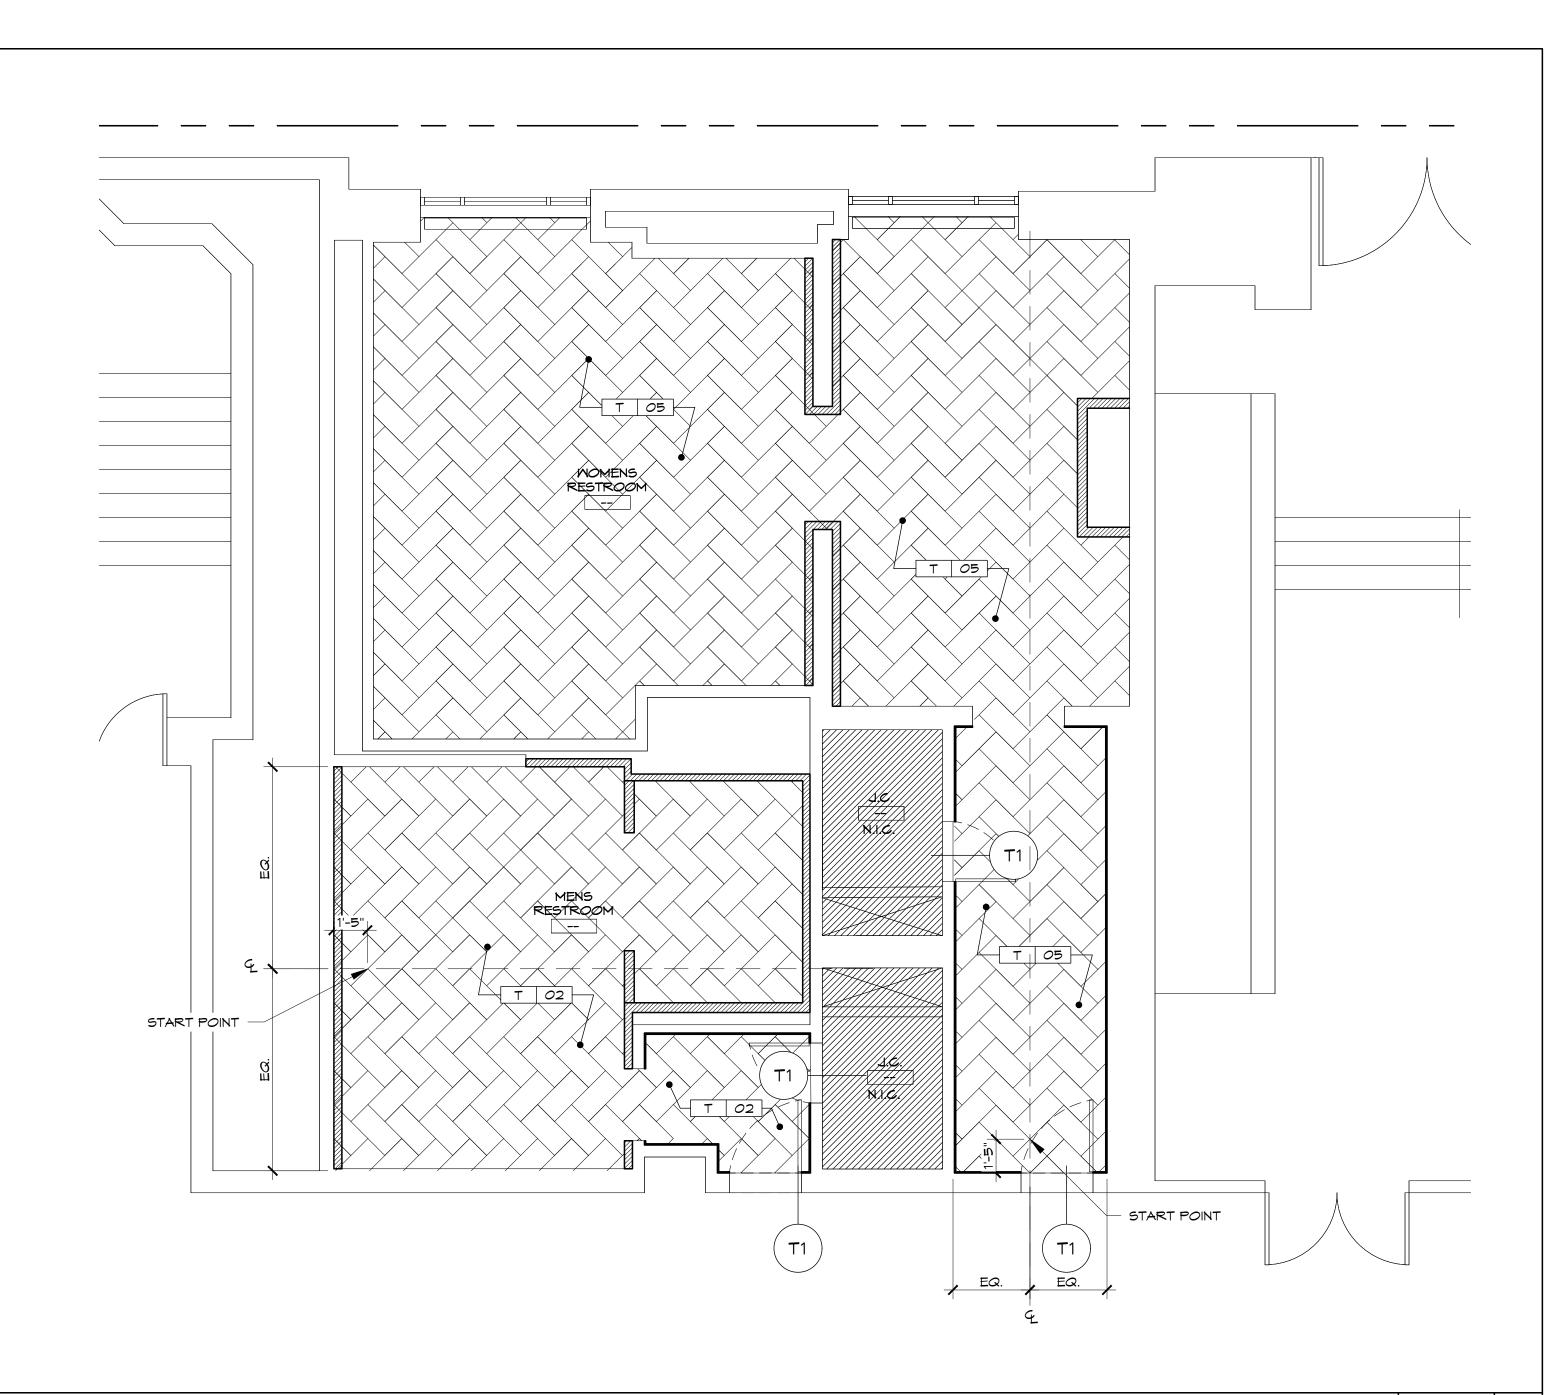



SCALE 1/4"=1'-0"




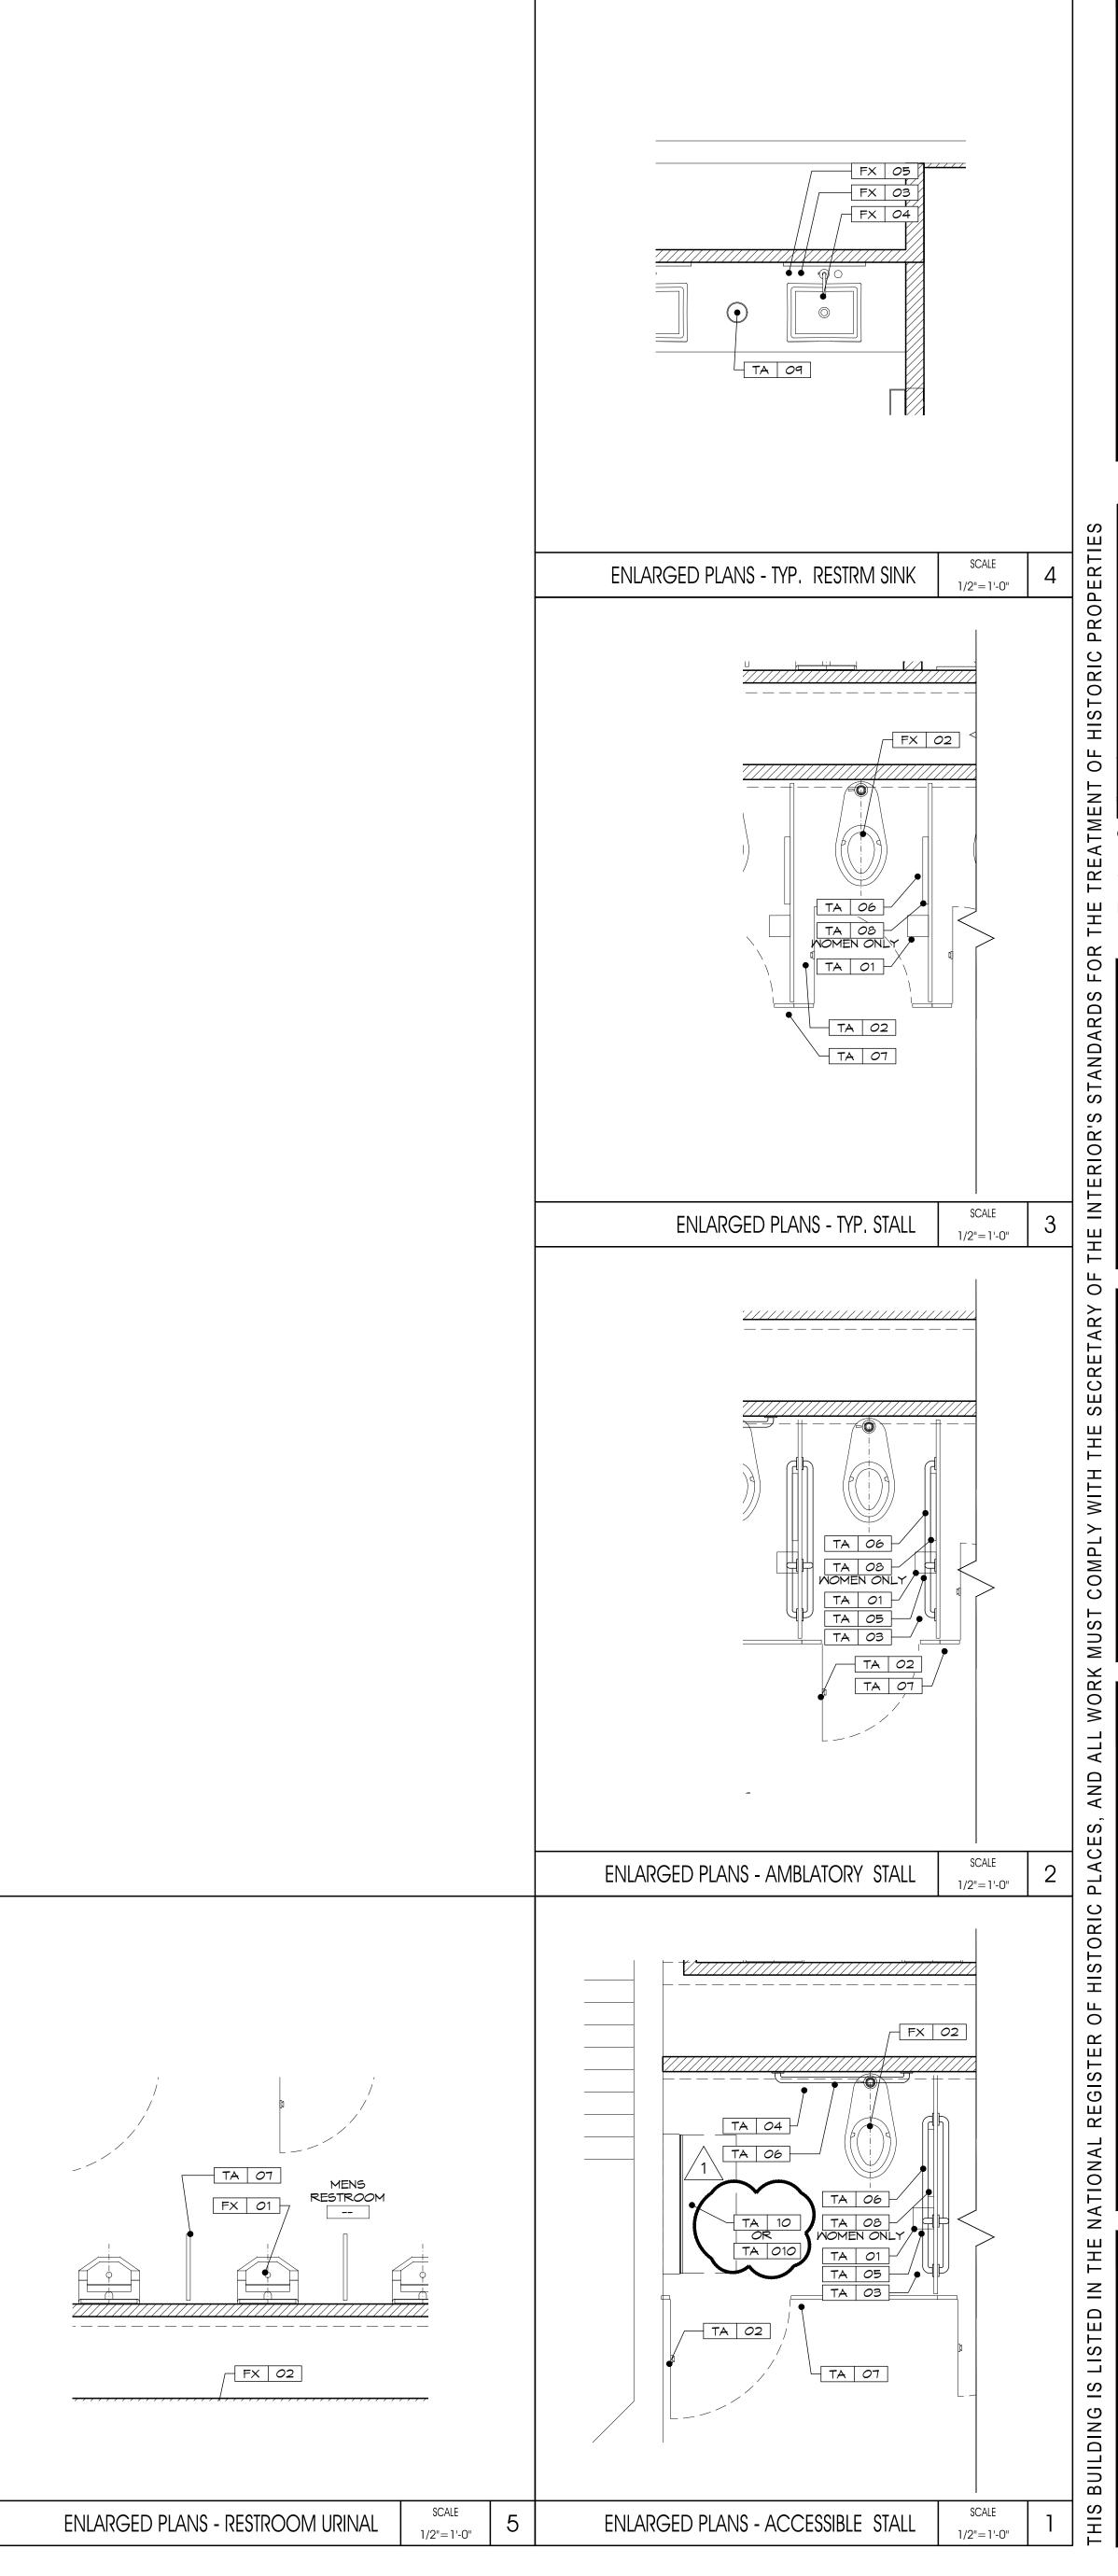




S ш Ш Ш ۲ 0 РR C R 0 S T ⊢ ⊢ С -⊢ Z 느느 0 SECRETARY **WITH THE** СОМРLY MUST WORK ALL AND Ś. ш PLA ОF TIONA ED LIST <u>S</u> 0 Δ UIL I


	CEILING LEGEND		
⊉	SCONCE		
0	DOWN LIGHT		
	EMERGENCY LIGHT	ING UNIT	
EXIT	EXIT SIGN		
	EXIT SYMBOL (DIRECTION APPLICABLE		Æ
-\$-D	FIRE ALARM	1	
	SUPPLY DIFFUS	6ER	
	RETURN DIFFUS	3ER	
	ACCESS PAN	EL	
	CEILING LEGEND	SCALE	3
		N.T.S.	

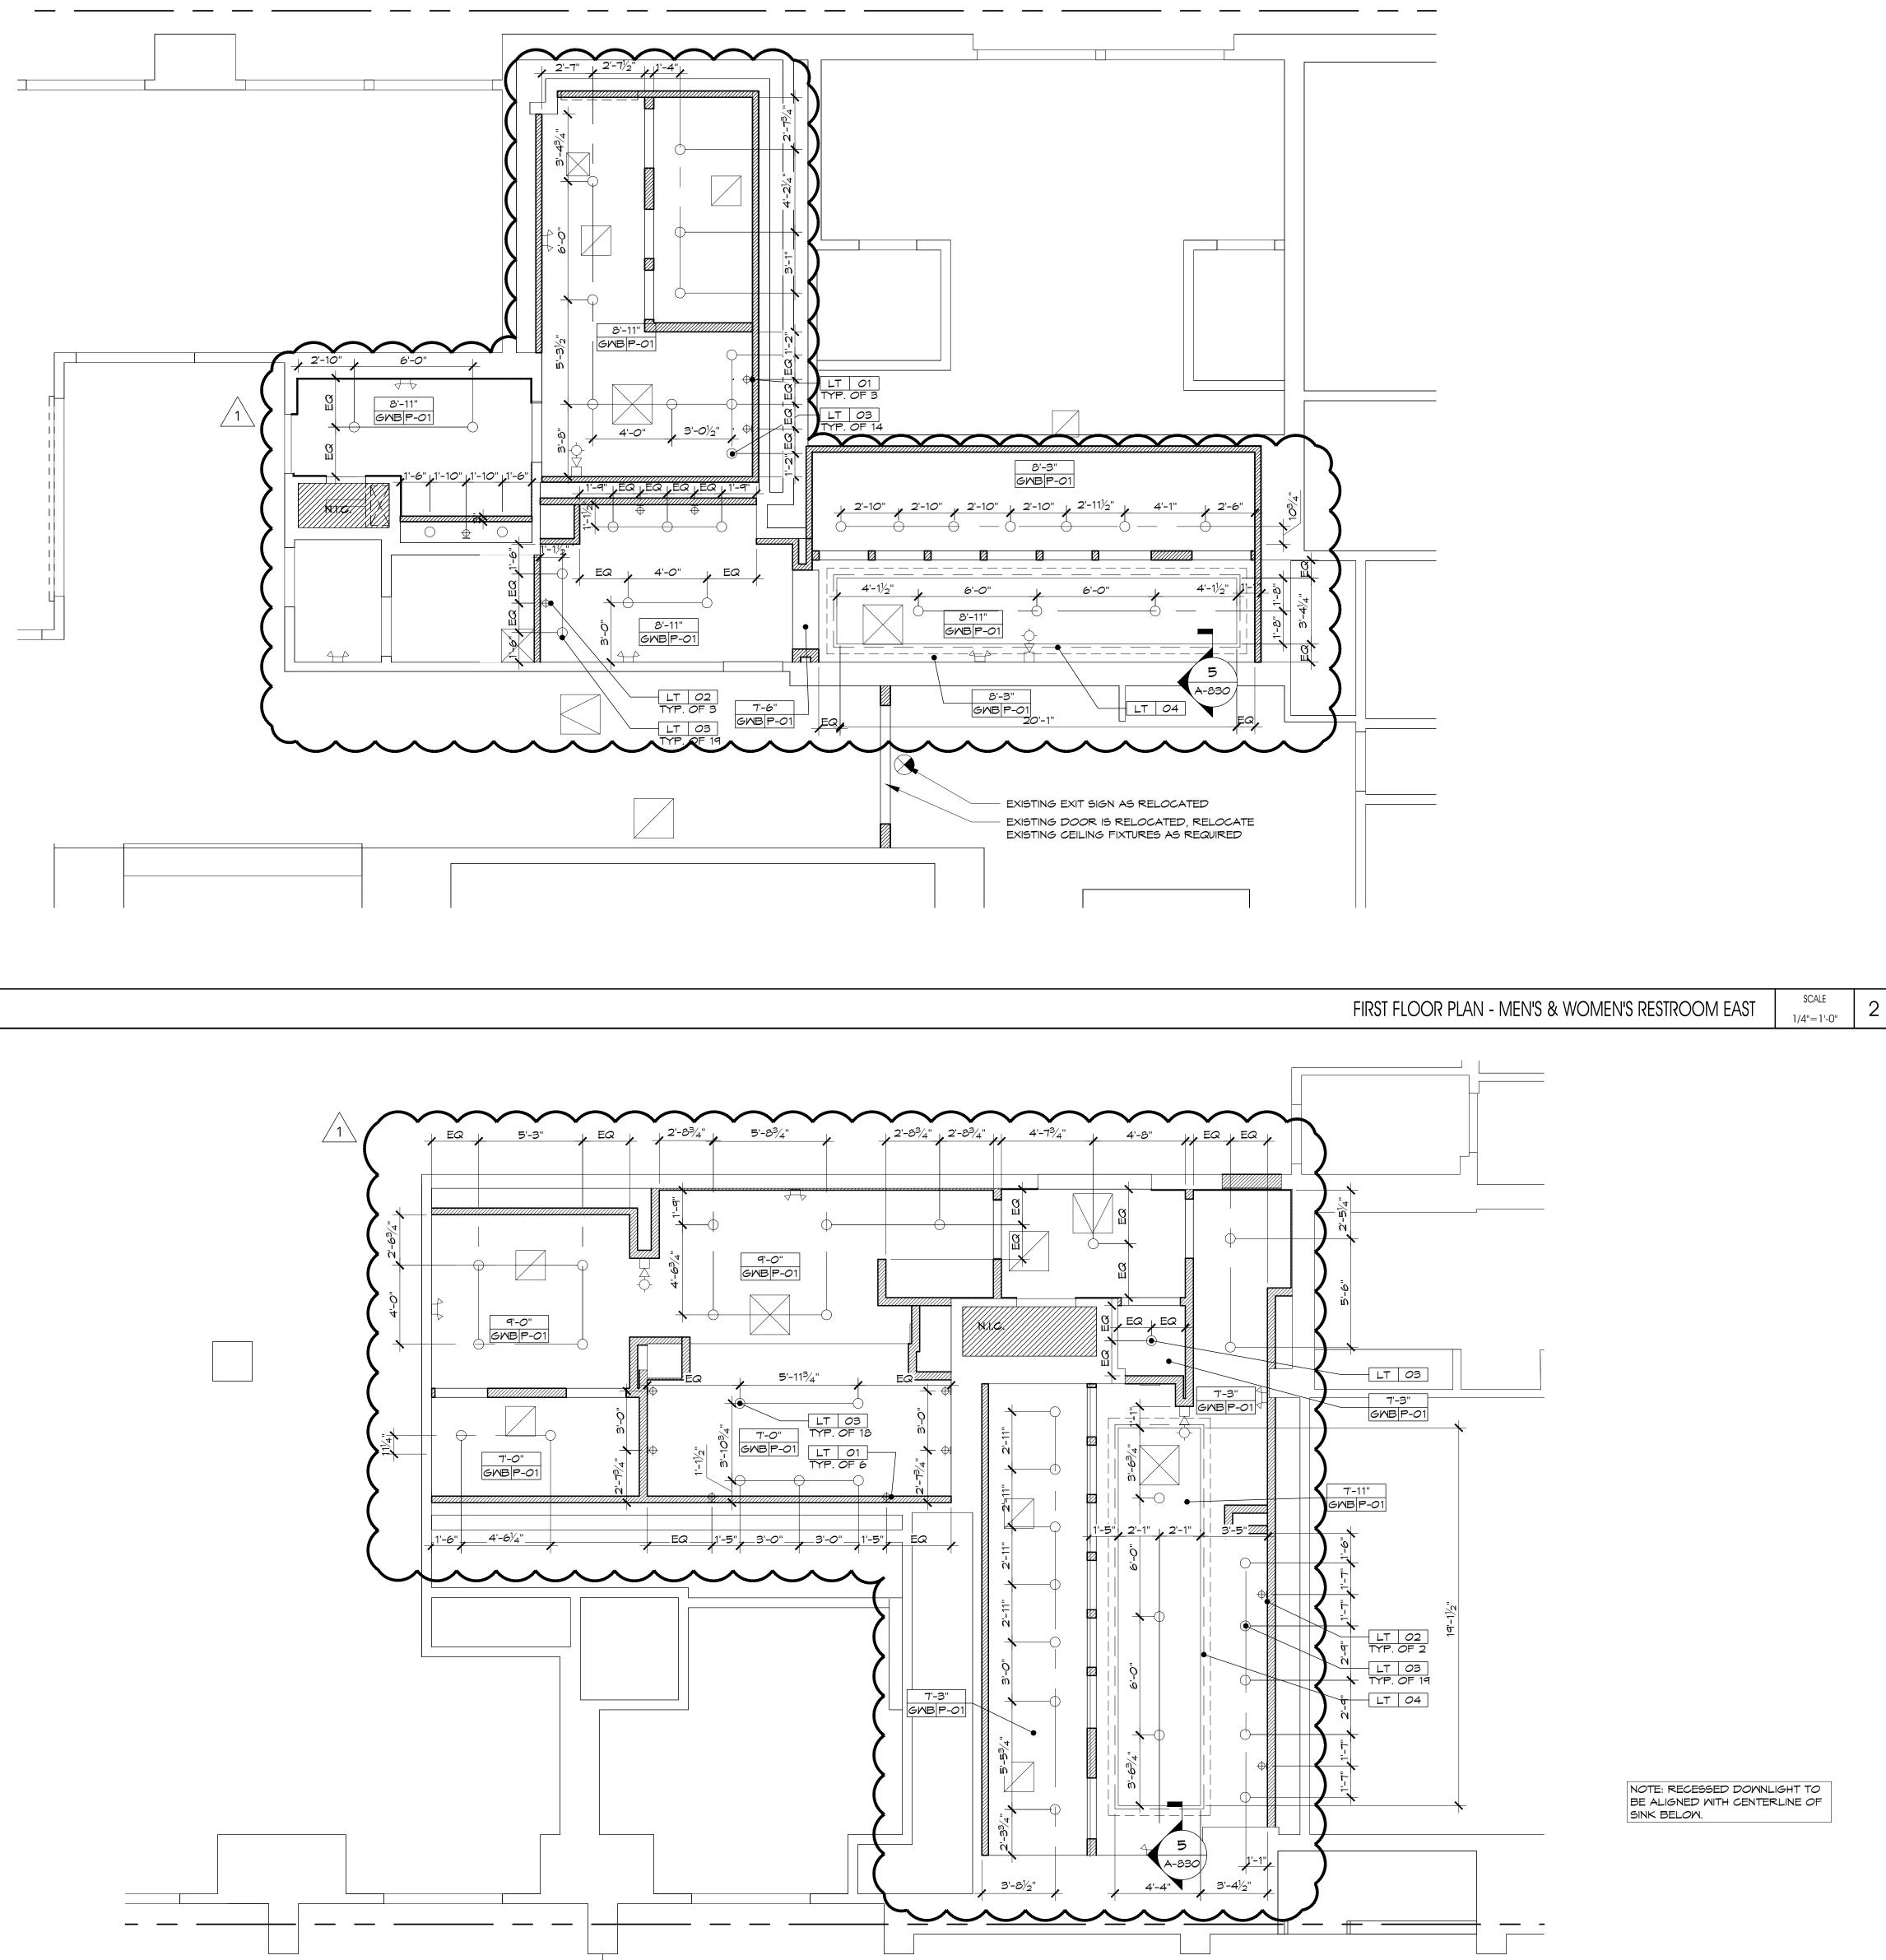


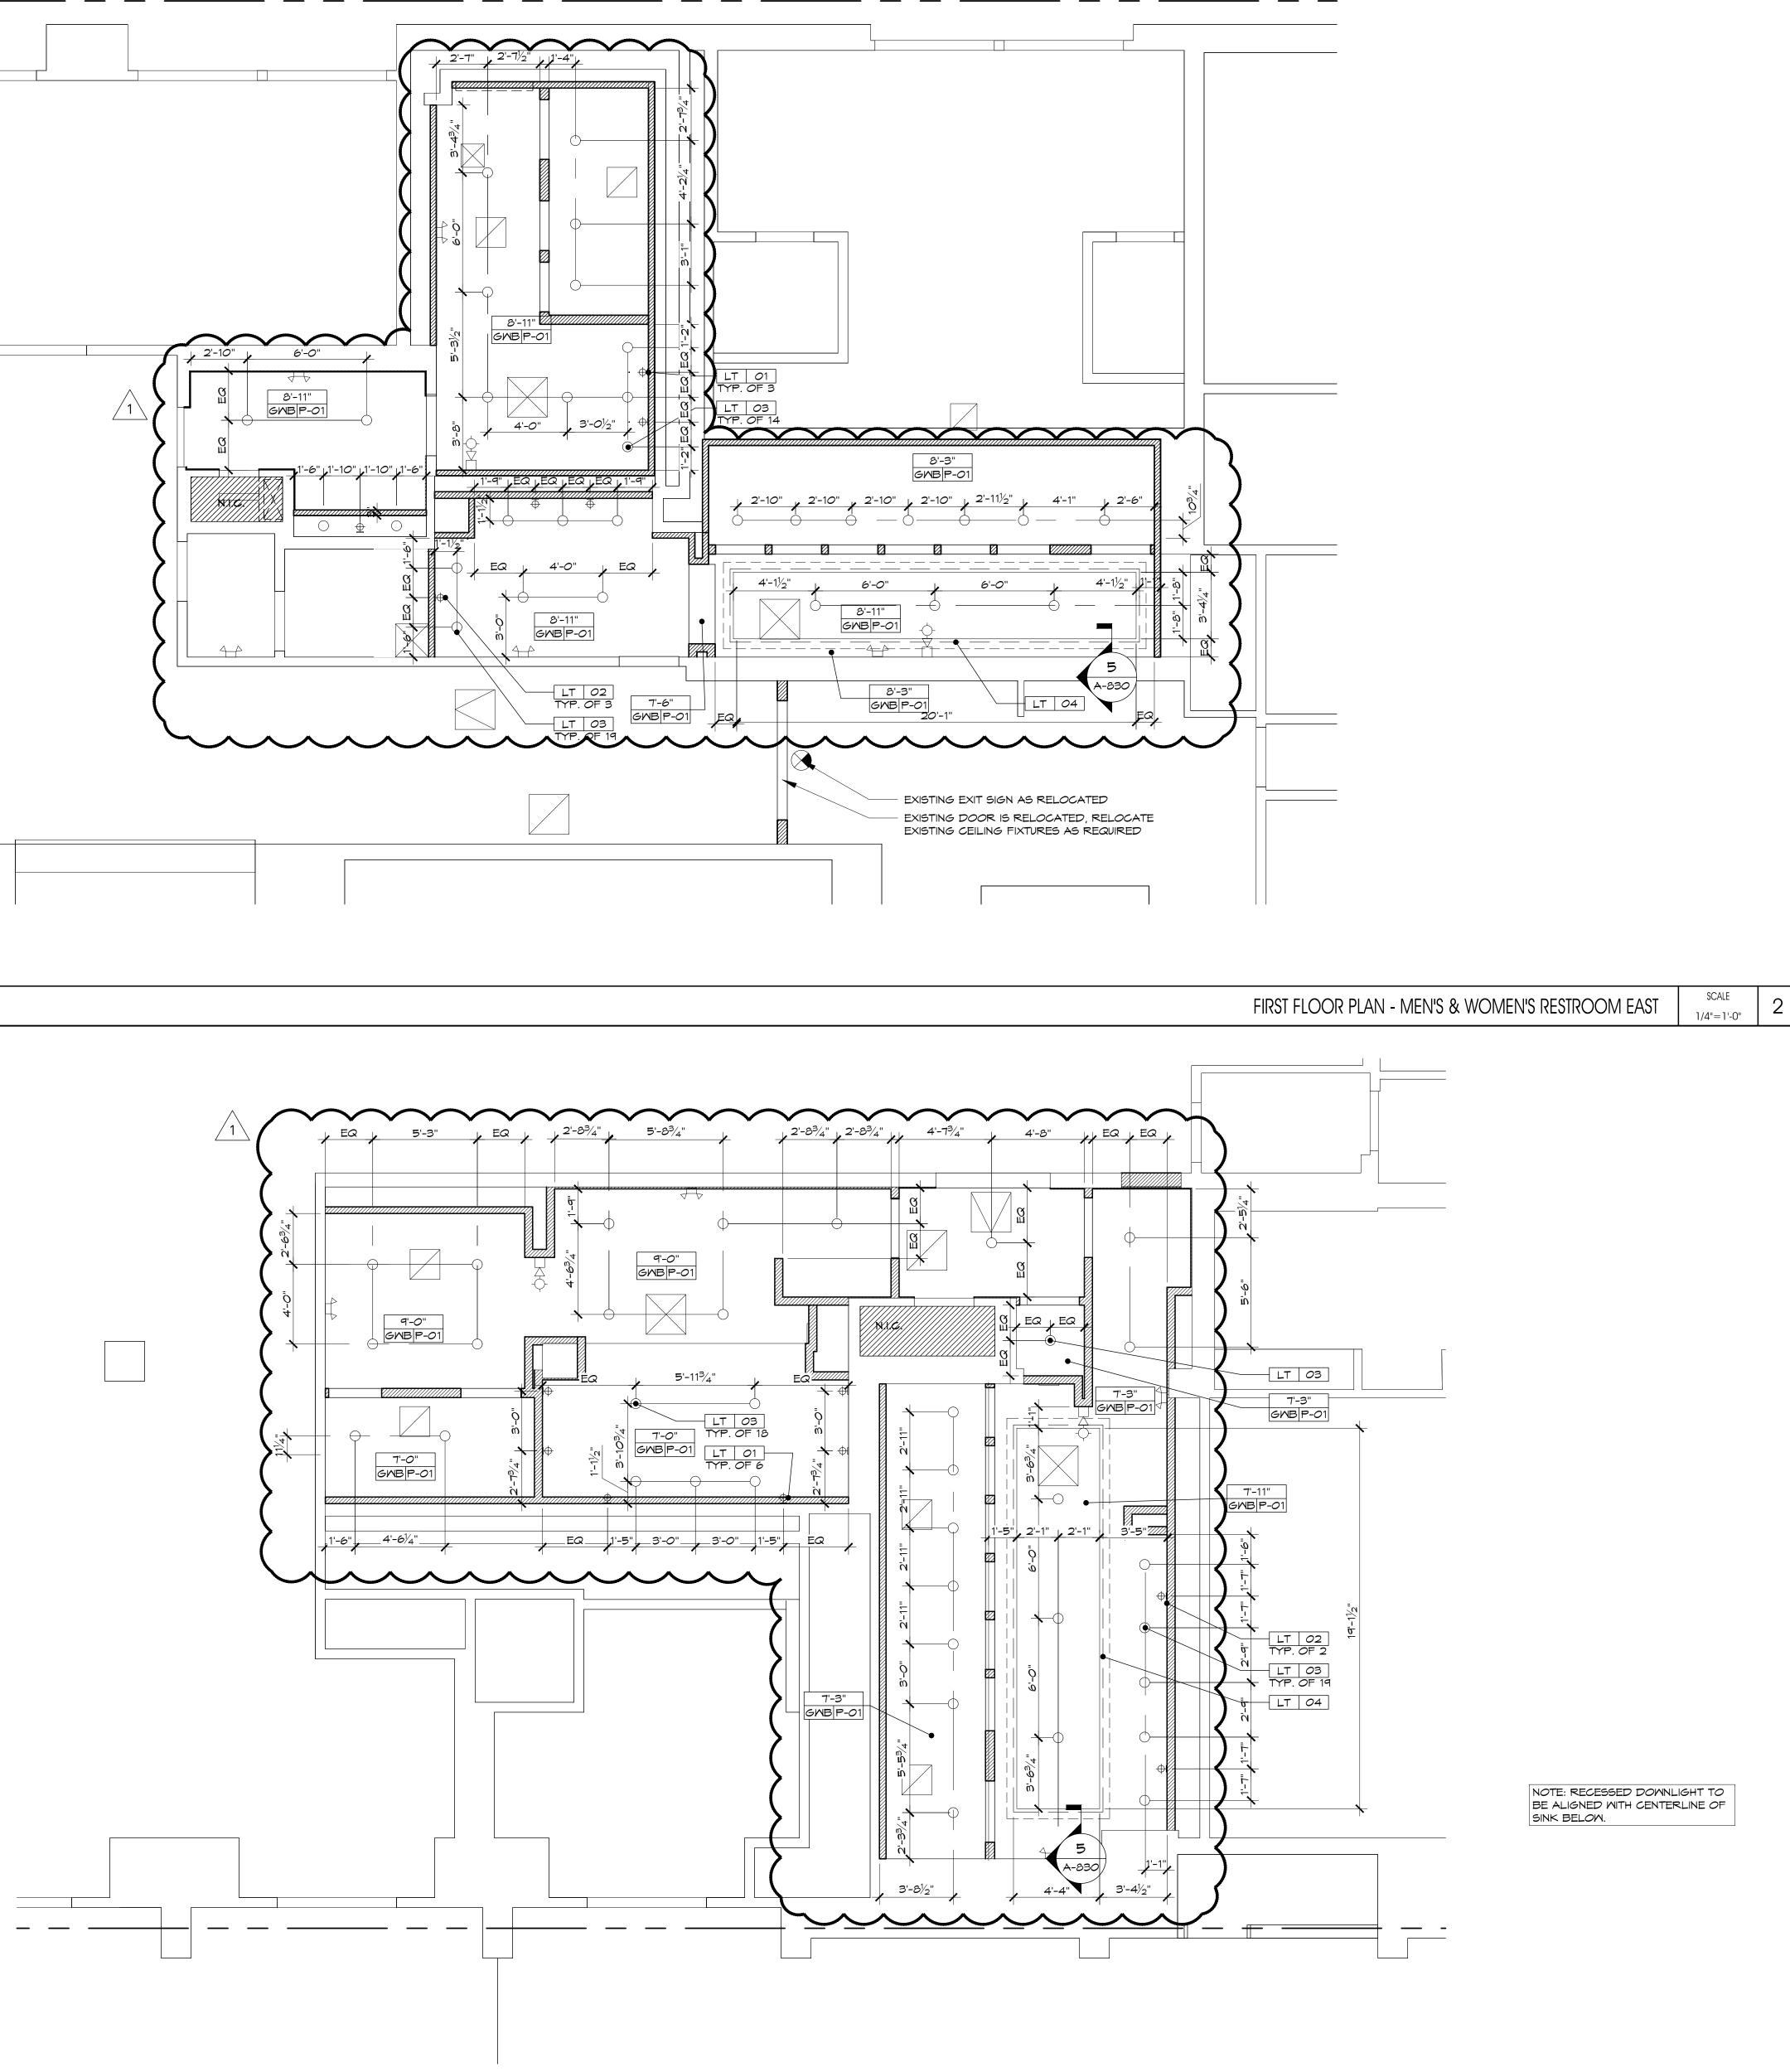


Sobolus atlantic city 1020 Atlantic Avenue Atlantic City, NJ 08401 1: 609.345.5222 F: 609.345.7486 New York, NY 10019 F: 212.246.2770 F: 212.246.2770
Thomas J. Sykes, A.I.A., P.P. Founding Principal William A. Salerno, A.I.A., P.P. Founding Principal Nory Hazaveh, A.I.A., P.P. Founding Principal Mark Petrella, A.I.A. Principal Christopher M. Menchin, NCARB Principal Kimberly McCarron, NCARB Principal
www.sosharch.com
Boardwalk Hall YOUR BEST SEAT AT THE SHORE
AC BOARDWALK HALL RESTROOM RENOVATION
2301 BOARDWALK, ATLANTIC CITY, NJ 08401
SUBMISSIONS
1 2016.11.30 ADDENDUM #2
I 10-14-2016 I CONSTRUCTION DOCUMENTS NO. I DATE: I DESCRIPTION:
DRAWING TITLE: FIRST FLOOR CEILING PLANS
DRAWN BY: SB DRAWING NO. REVIEWED BY: CM
PROJECT NO. 15243.00.001 A-201


	CEILING LEGEND SCONCE	
0	DOWN LIGHT	_
	EMERGENCY LIGHTING UNIT	-
	EXIT SIGN EXIT SYMBOL (DIRECTION ARROW WHERE	
	APPLICABLE)	-
	SUPPLY DIFFUSER	
	RETURN DIFFUSER ACCESS PANEL	
	CEILING LEGEND SCALE 3	
·	I	

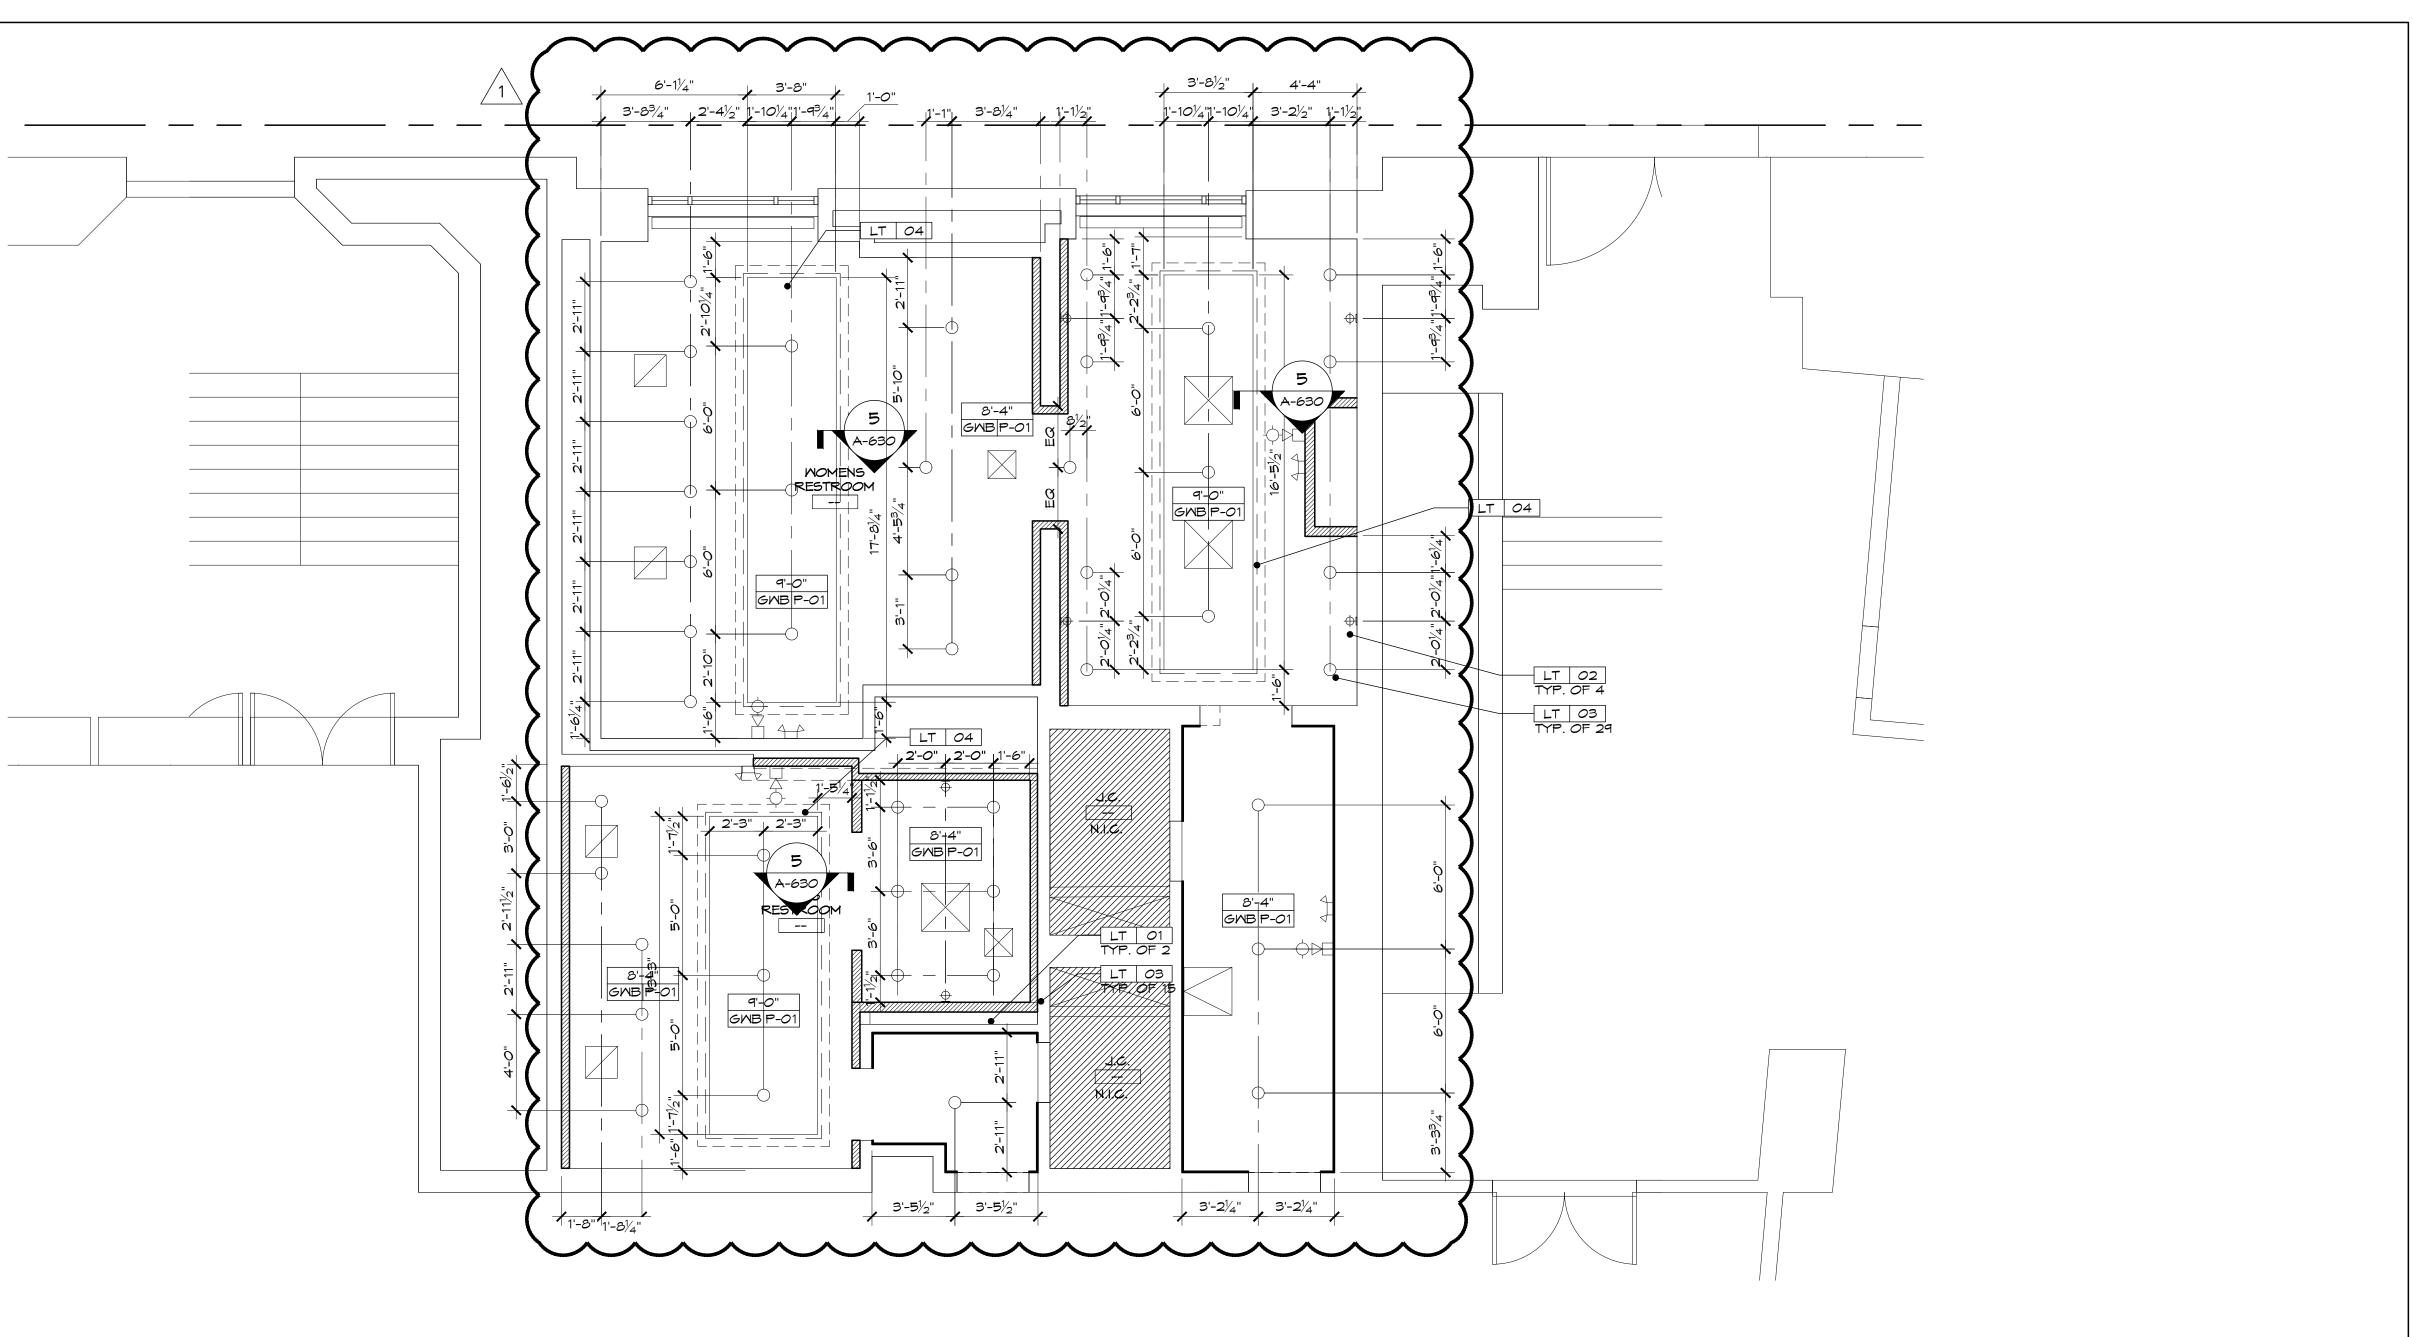

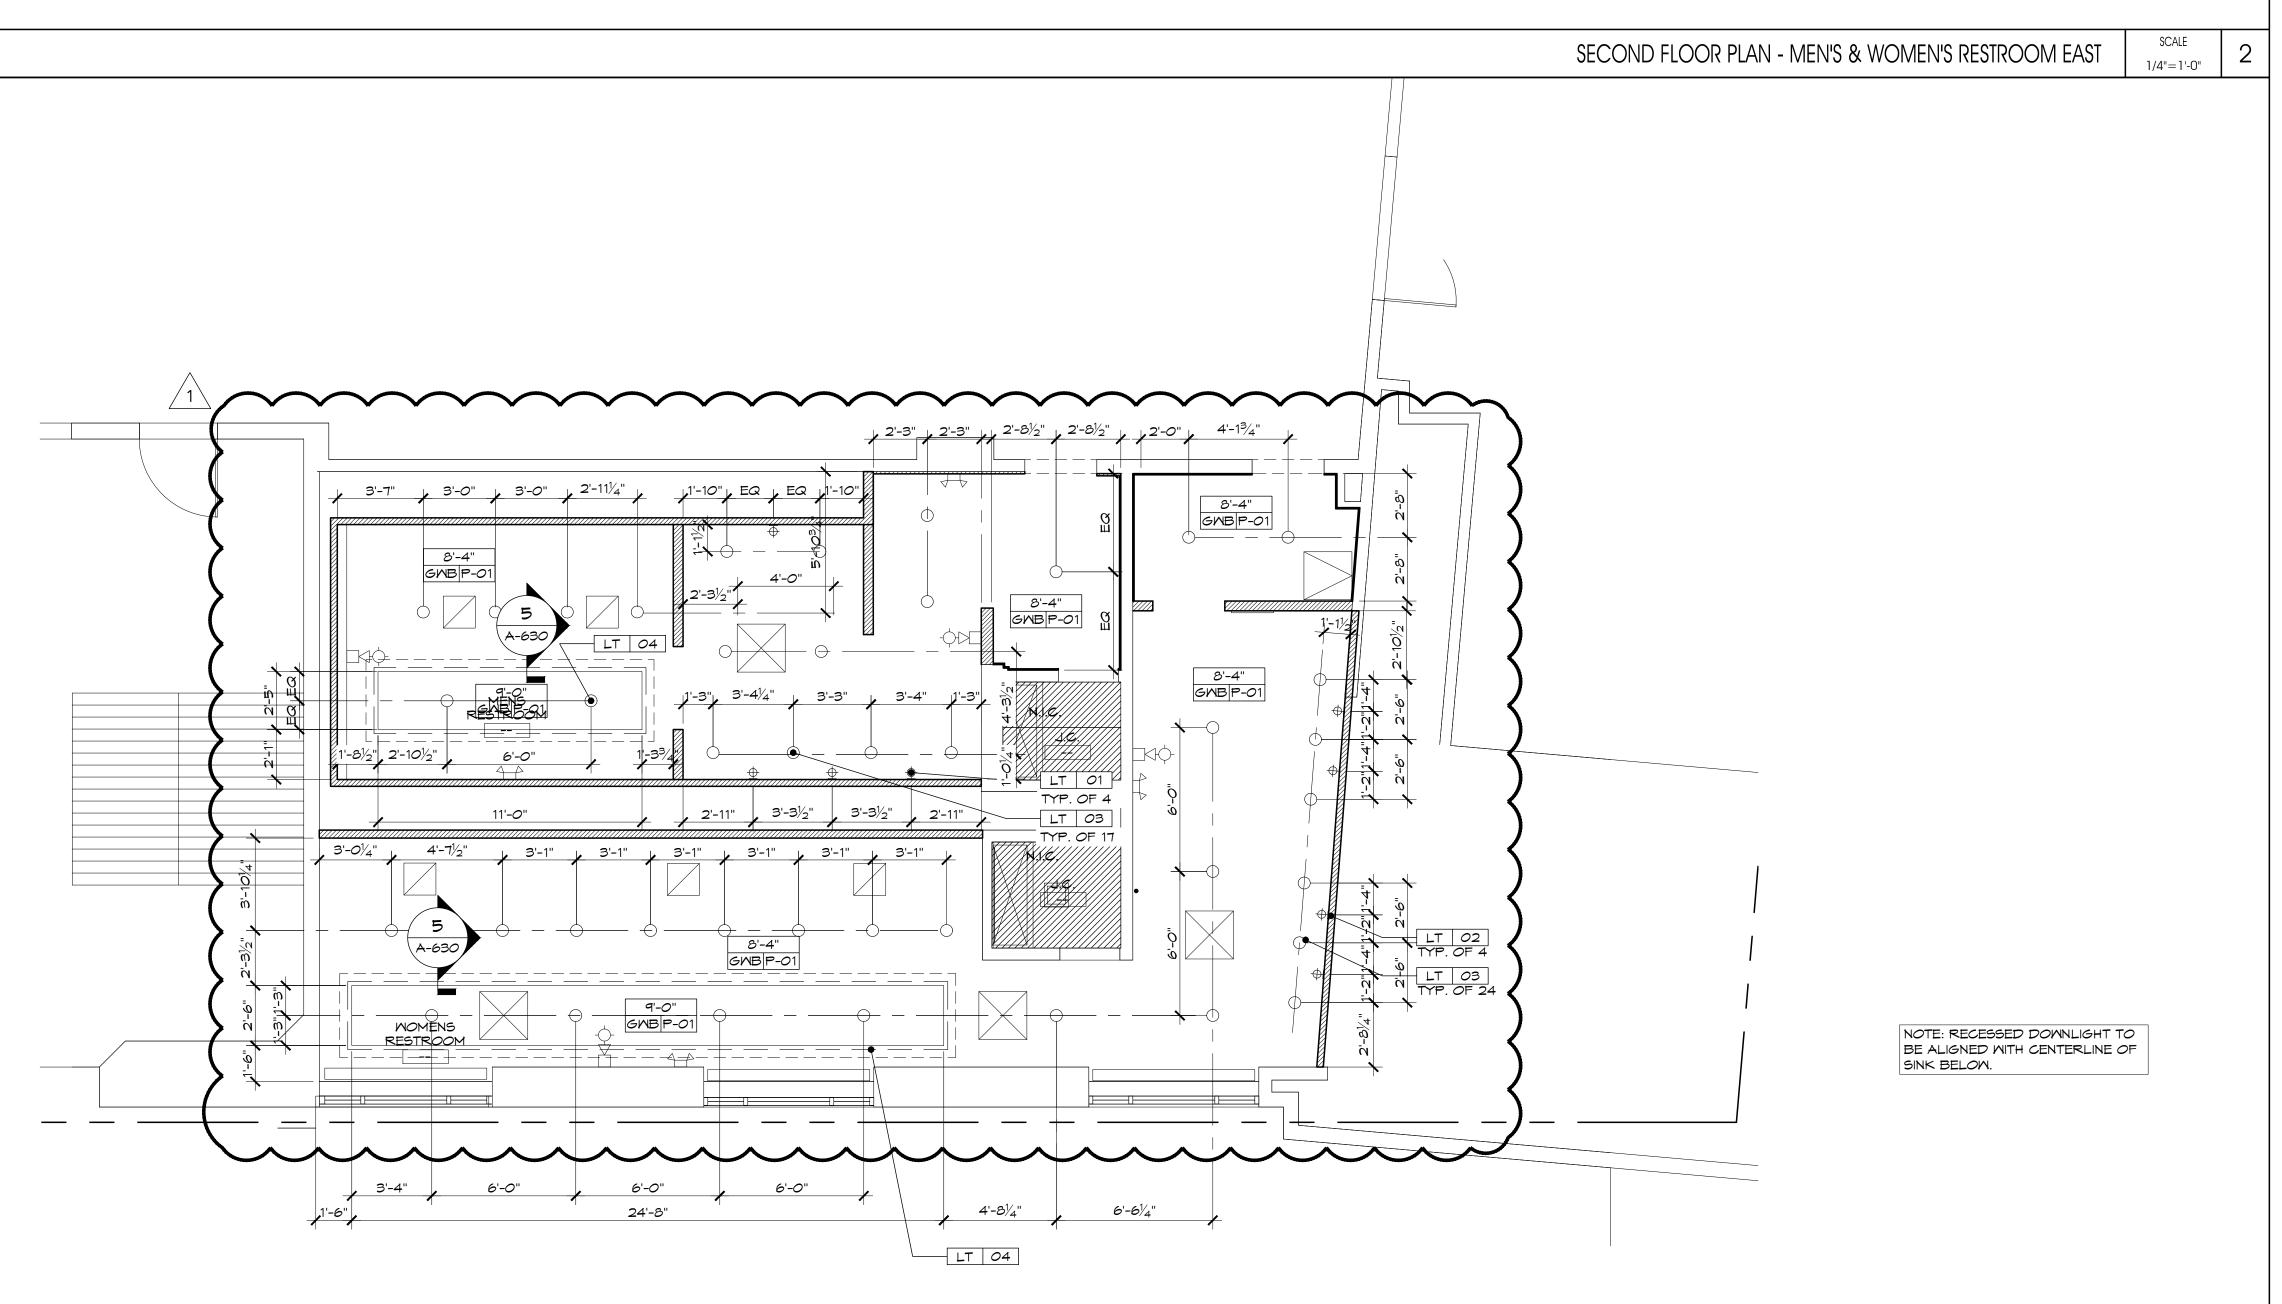


SCALE 1/4"=1'-0"

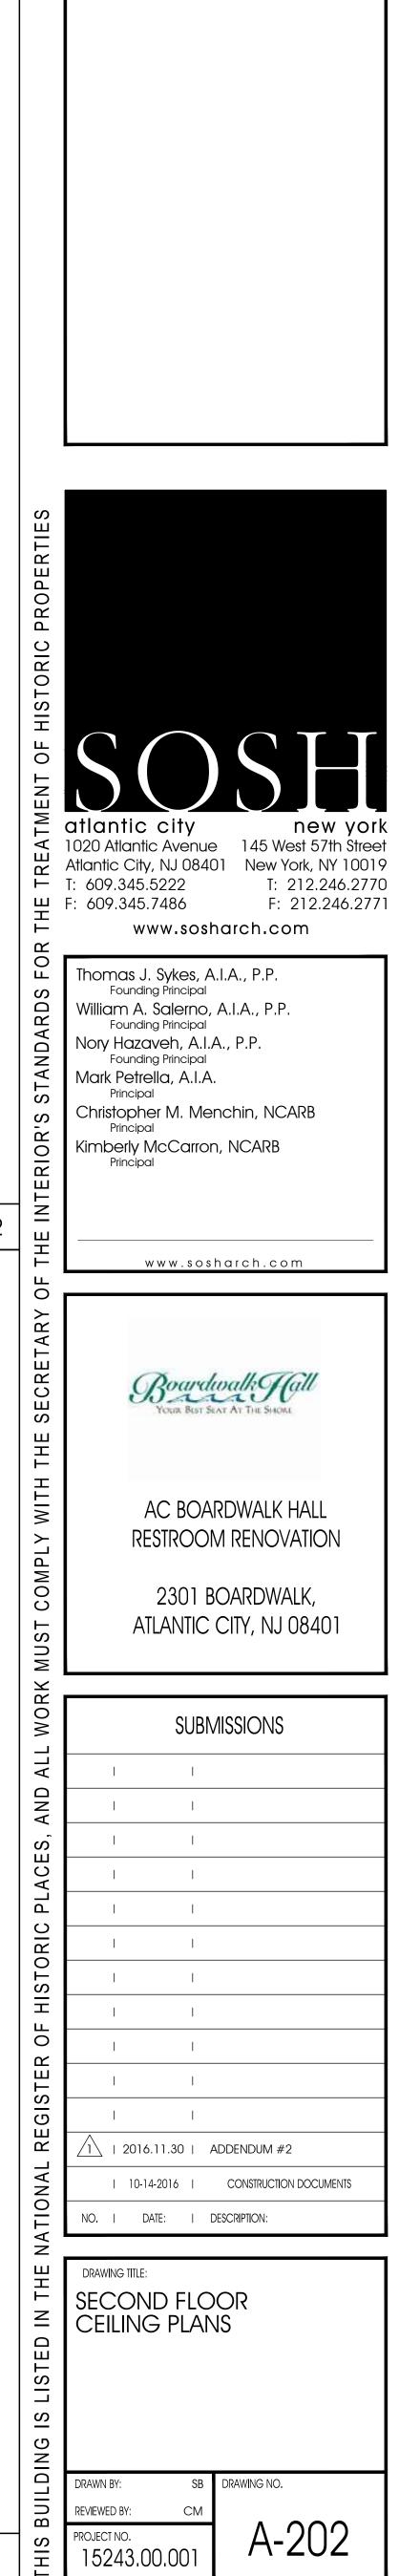


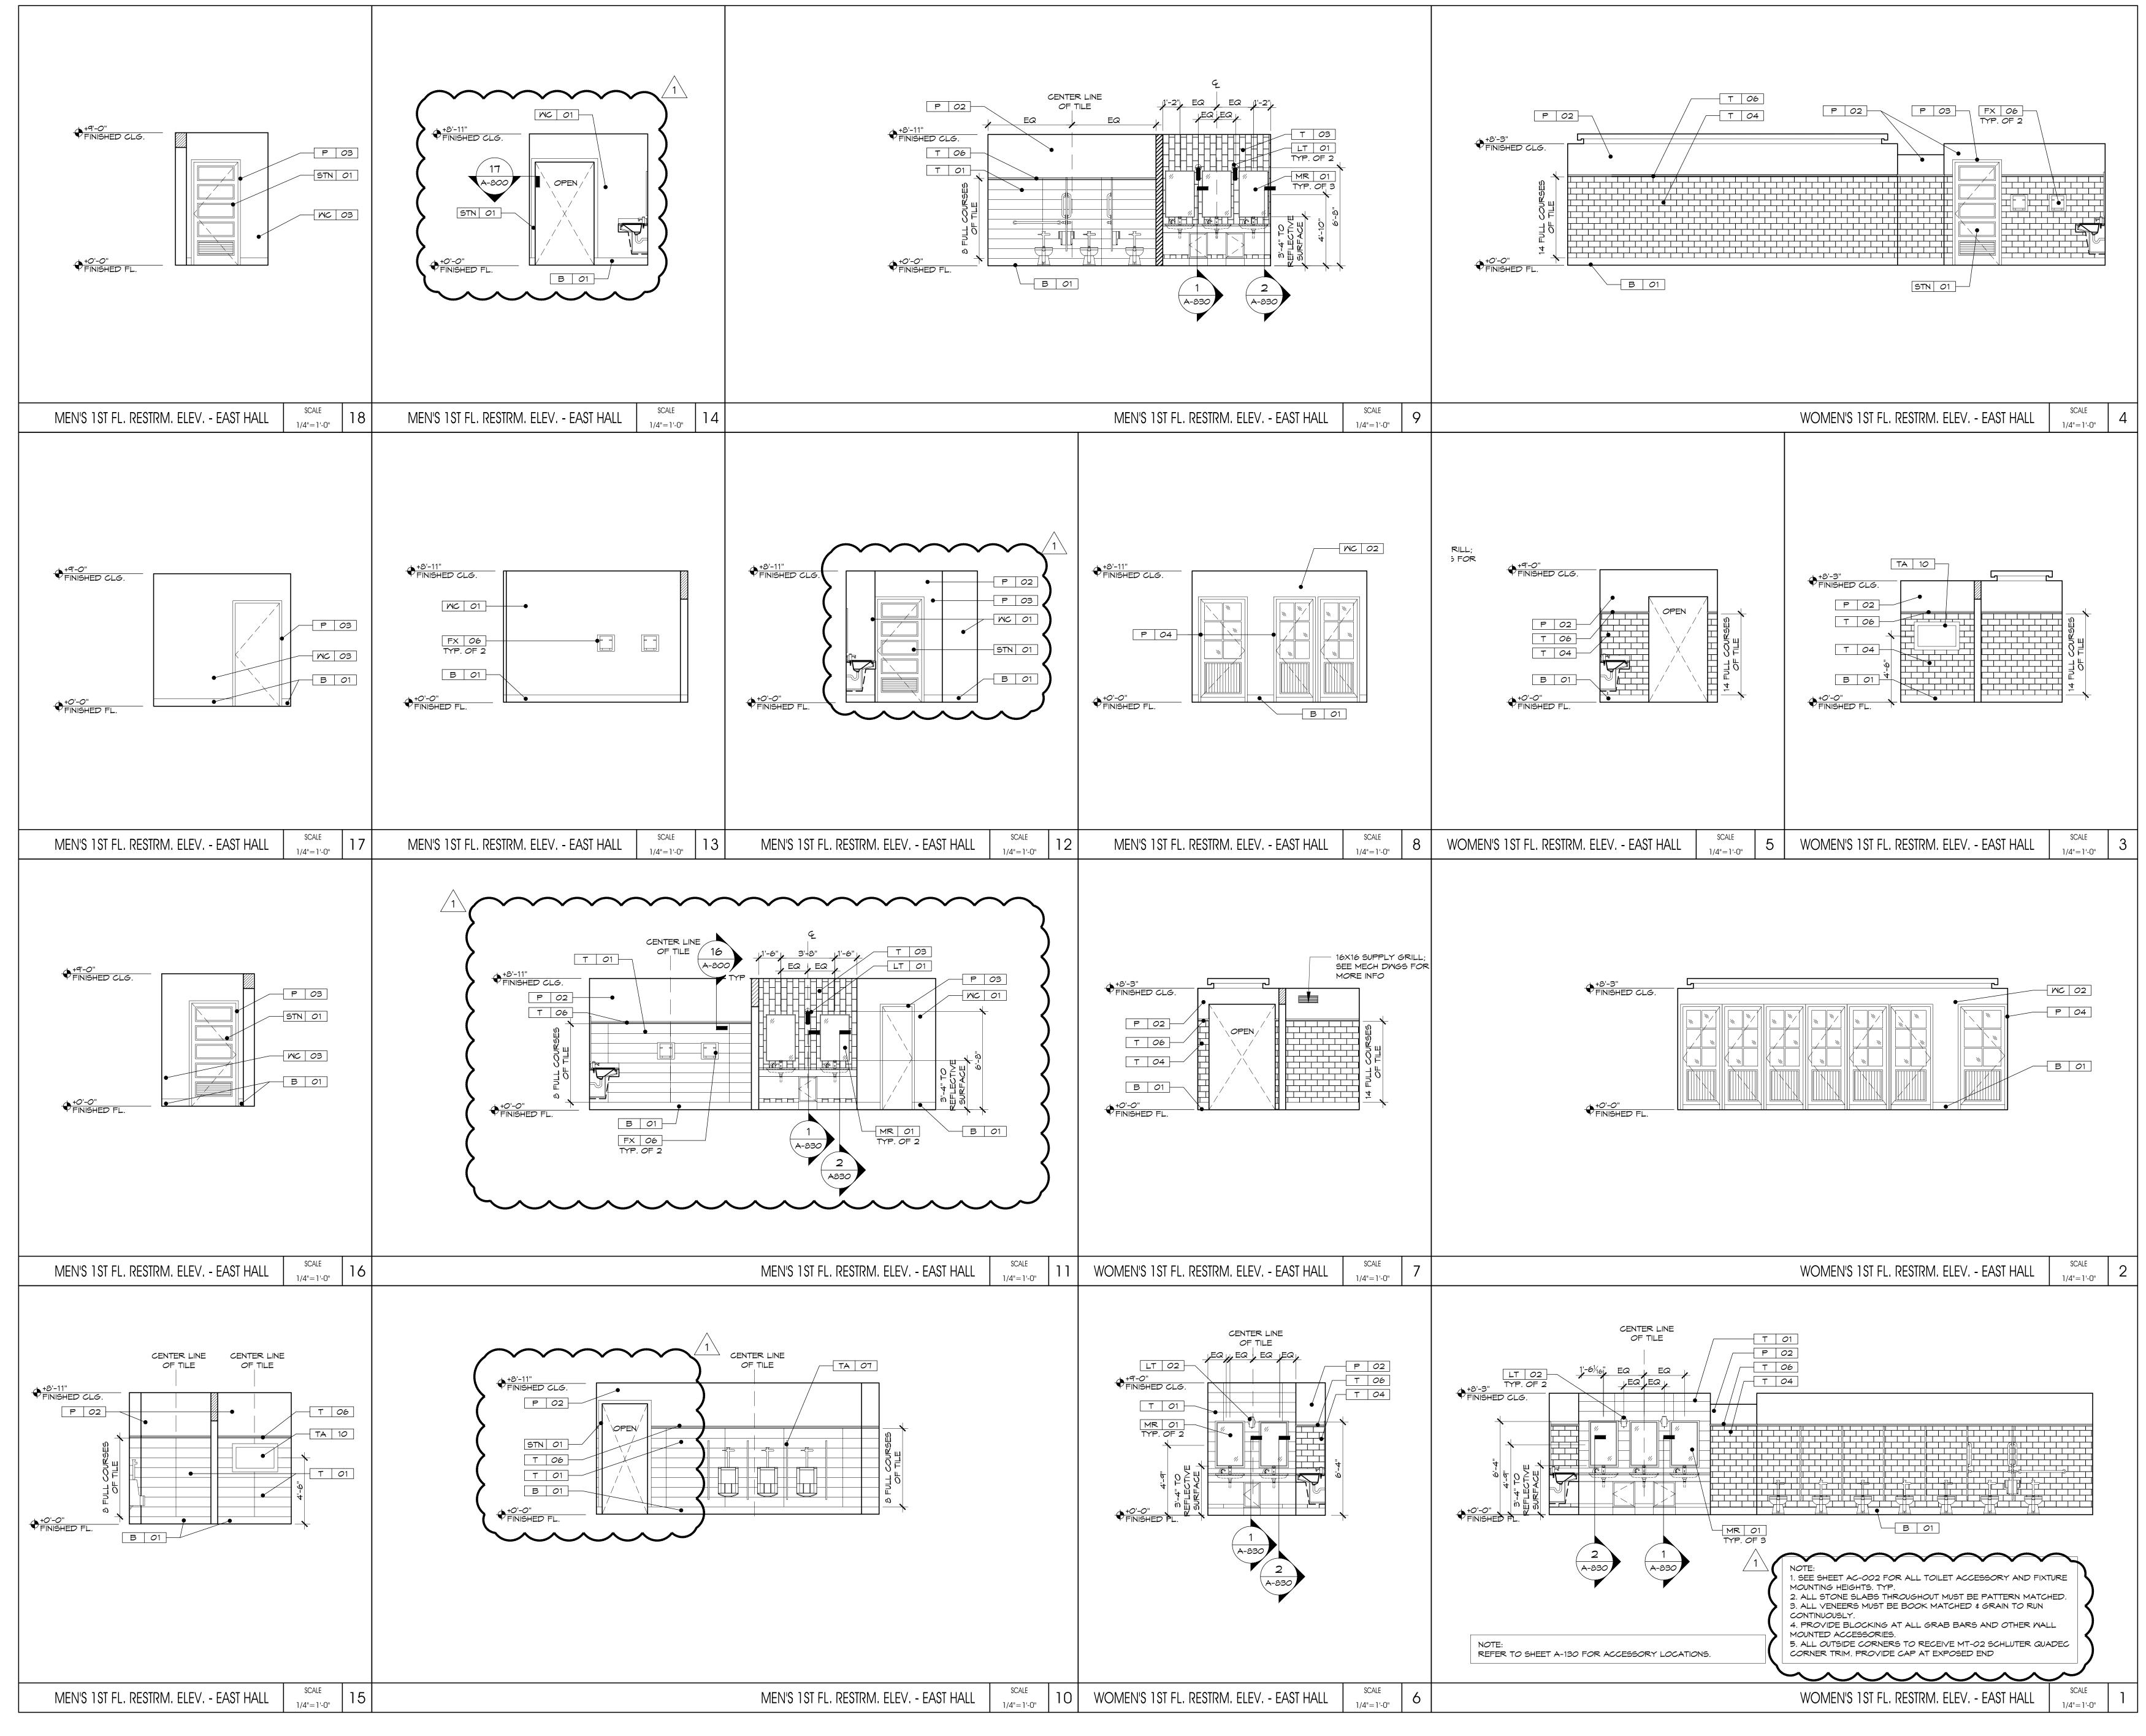

SOSE
atlantic city new york 1020 Atlantic Avenue 145 West 57th Street Atlantic City, NJ 08401 New York, NY 10019 T: 609.345.5222 T: 212.246.2770
F: 609.345.7486 F: 212.246.277 www.sosharch.com
Thomas J. Sykes, A.I.A., P.P. Founding Principal William A. Salerno, A.I.A., P.P. Founding Principal
Nory Hazaveh, A.I.A., P.P. Founding Principal Mark Petrella, A.I.A. Principal
Christopher M. Menchin, NCARB Principal Kimberly McCarron, NCARB Principal
www.sosharch.com
Boardwalk Hall YOUR BEST SEAT AT THE SHOWE
AC BOARDWALK HALL
RESTROOM RENOVATION 2301 BOARDWALK,
ATLANTIC CITY, NJ 08401
SUBMISSIONS
 <u>1</u> 2016.11.30 ADDENDUM #2
I 10-14-2016 I CONSTRUCTION DOCUMENTS NO. I DATE: I DESCRIPTION:
DRAWING TITLE:
WOMEN & MEN'S 1ST FLOOR RESTROOMS - EAST HALL
DRAWN BY: SB DRAWING NO. REVIEWED BY: CM
PROJECT NO. 15243.00.001 A-600

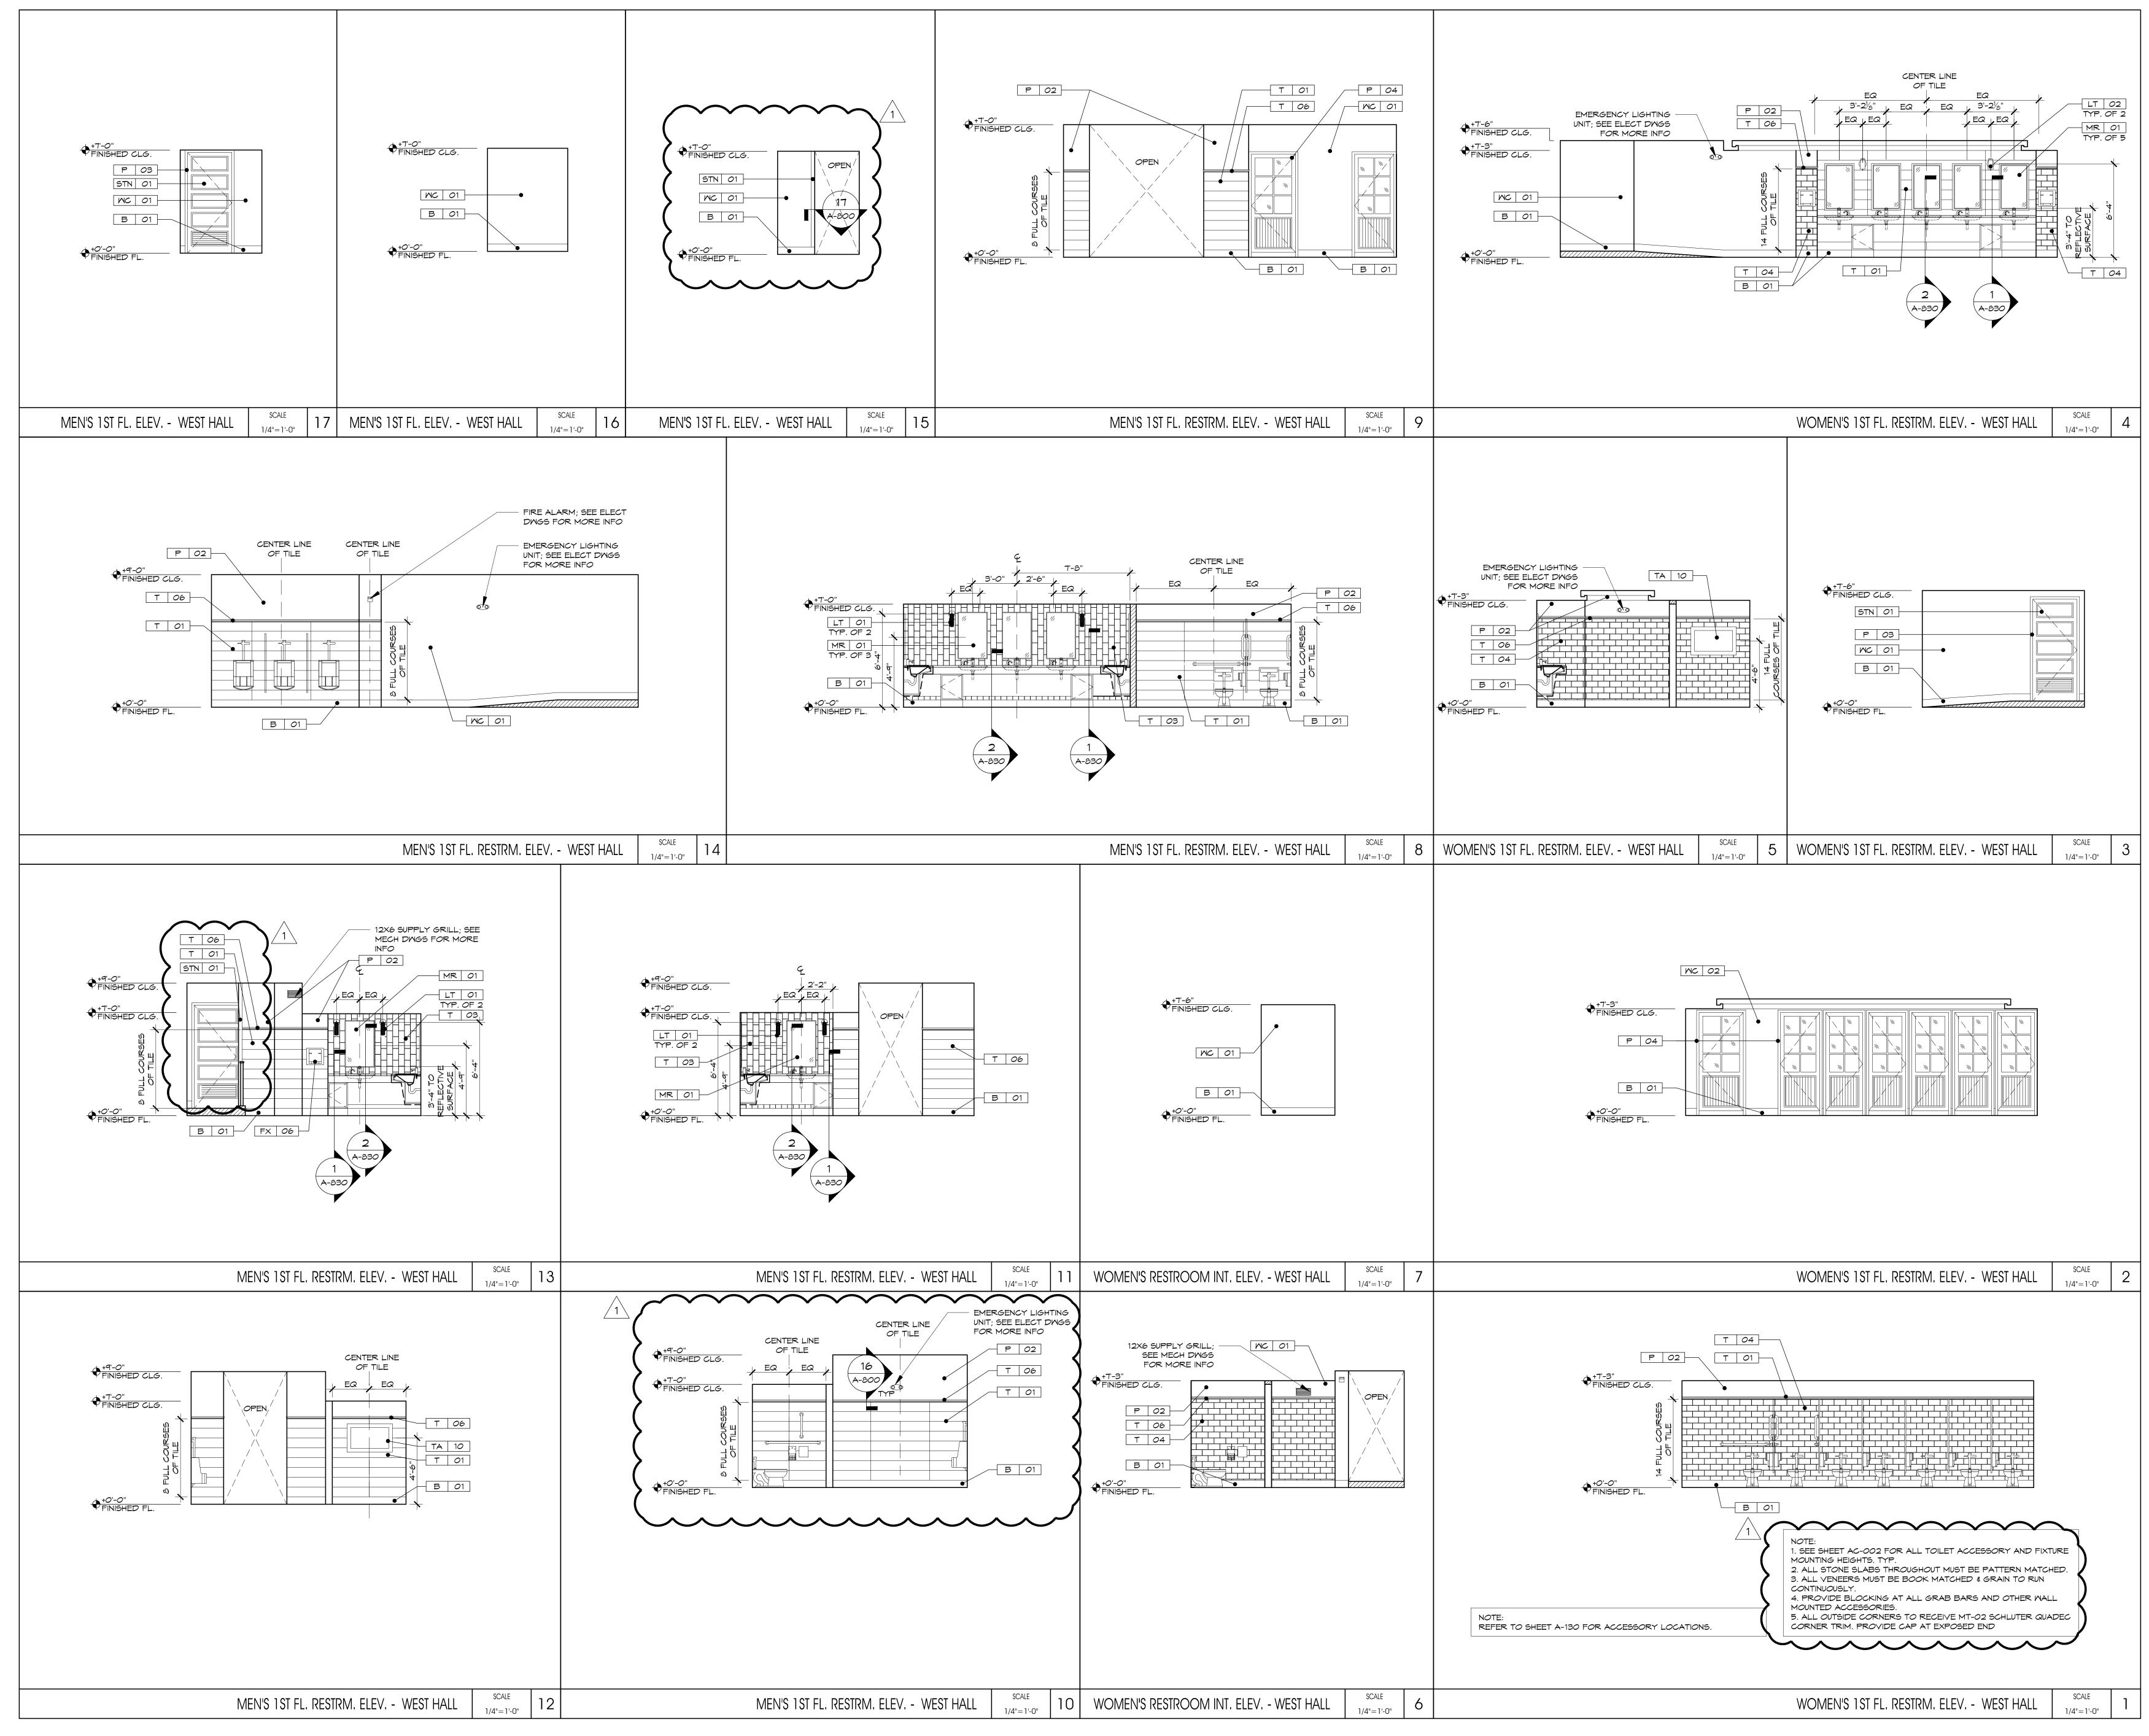



SOSH
atlantic city new york 1020 Atlantic Avenue 145 West 57th Street Atlantic City, NJ 08401 New York, NY 10019 T: 609.345.5222 T: 212.246.2770 F: 609.345.7486 F: 212.246.2777
www.sosharch.com Thomas J. Sykes, A.I.A., P.P. Founding Principal William A. Salerno, A.I.A., P.P. Founding Principal
Nory Hazaveh, A.I.A., P.P. Founding Principal Mark Petrella, A.I.A. Principal Christopher M. Menchin, NCARB Principal Kimberly McCarron, NCARB
Principal www.sosharch.com
Boardwalk Hall YOUR BEST SEAT AT THE SHOWE
AC BOARDWALK HALL RESTROOM RENOVATION
2301 BOARDWALK, ATLANTIC CITY, NJ 08401
SUBMISSIONS
1 + 2016.11.30 + ADDENDUM #2 + 10-14-2016 + CONSTRUCTION DOCUMENTS NO. + DATE: + DESCRIPTION: + -
DRAWING TITLE:
INTERIOR ELEVATIONS WOMEN & MEN'S 1ST FLOOR RESTROOMS - WEST HALL
DRAWN BY: SB DRAWING NO. REVIEWED BY: CM PROJECT NO. 150420001
15243.00.001 A-OUT

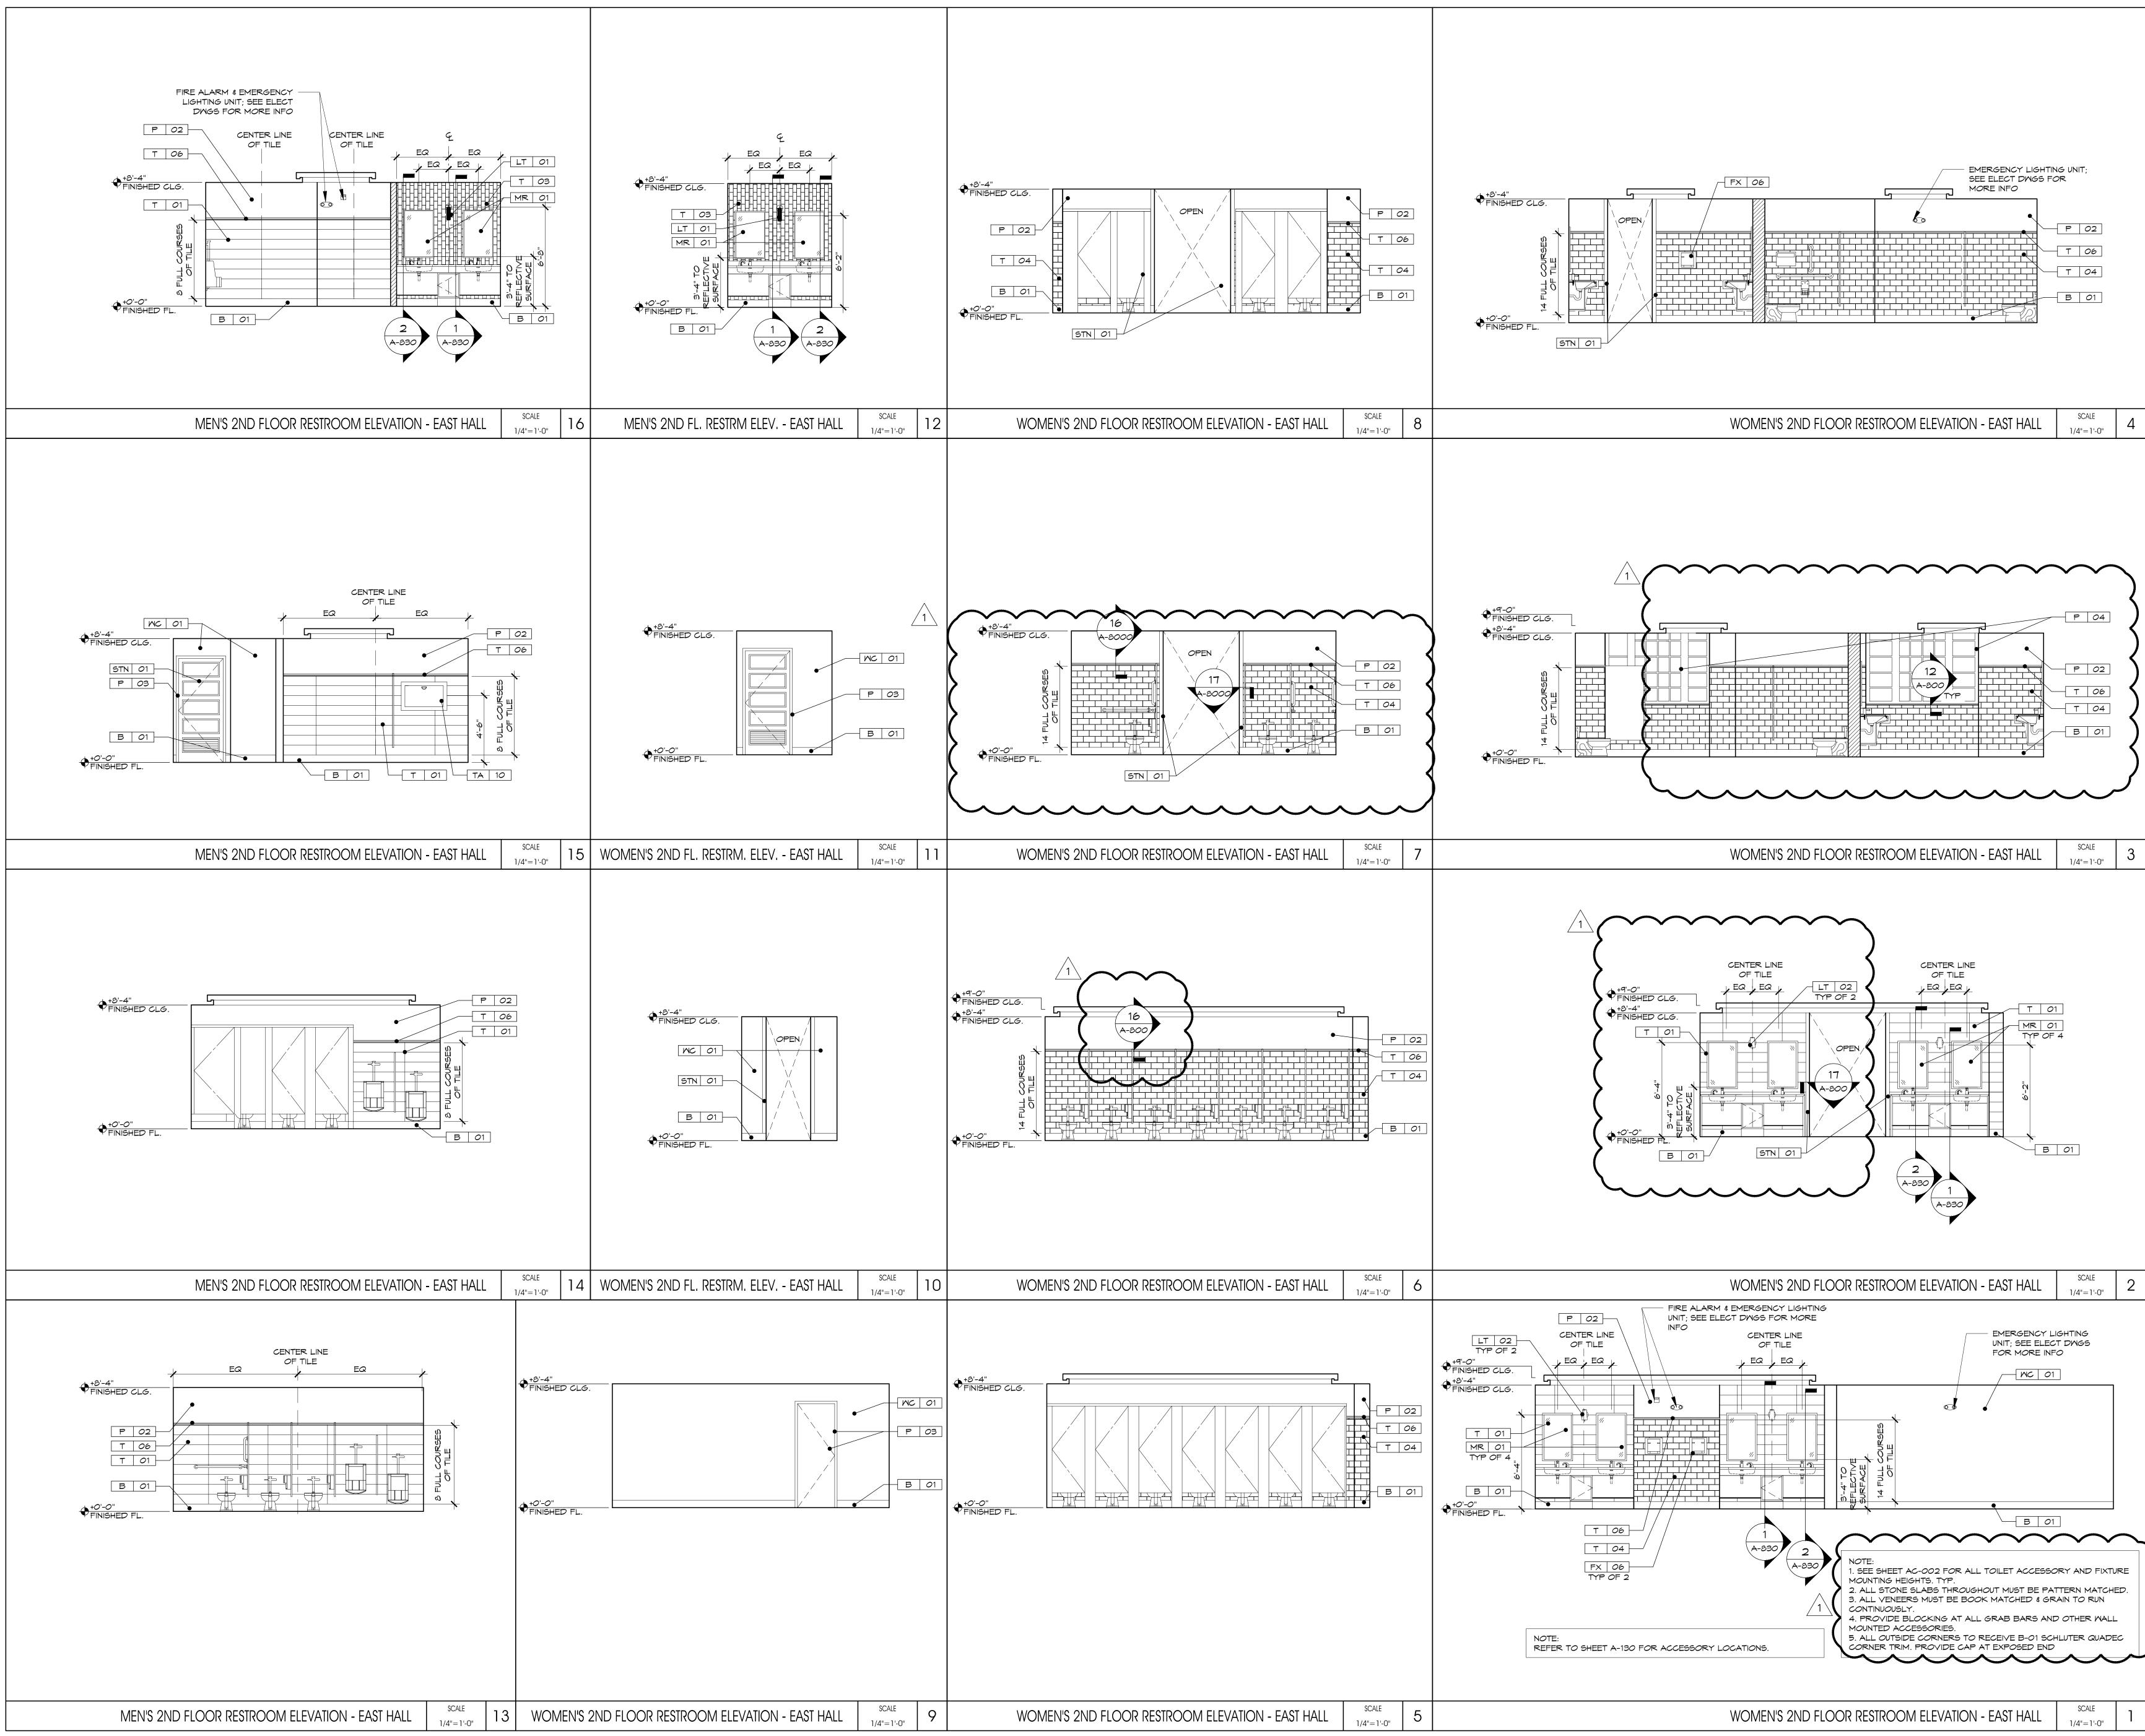



SolutionSolutionatlantic citynew york1020 Atlantic Avenuenew yorkAtlantic City, NJ 08401145 West 57th Street1: 609.345.5222145 West 57th StreetF: 609.345.74861: 212.246.2770F: 212.246.2770F: 212.246.2770www.sosharch.com
Thomas J. Sykes, A.I.A., P.P. Founding Principal William A. Salerno, A.I.A., P.P. Founding Principal Nory Hazaveh, A.I.A., P.P. Founding Principal Mark Petrella, A.I.A. Principal Christopher M. Menchin, NCARB Principal Kimberly McCarron, NCARB Principal
www.sosharch.com
Boardwalk Hall Your BIST SEAT AT THE SHORE
AC BOARDWALK HALL RESTROOM RENOVATION
2301 BOARDWALK, ATLANTIC CITY, NJ 08401
SUBMISSIONS
1 2016.11.30 ADDENDUM #2 10-14-2016 CONSTRUCTION DOCUMENTS
NO. DATE: DESCRIPTION:
DRAWING TITLE:
DRAWN BY: SB DRAWING NO. REVIEWED BY: CM PROJECT NO. 15243.00.001 A-602


ဟ

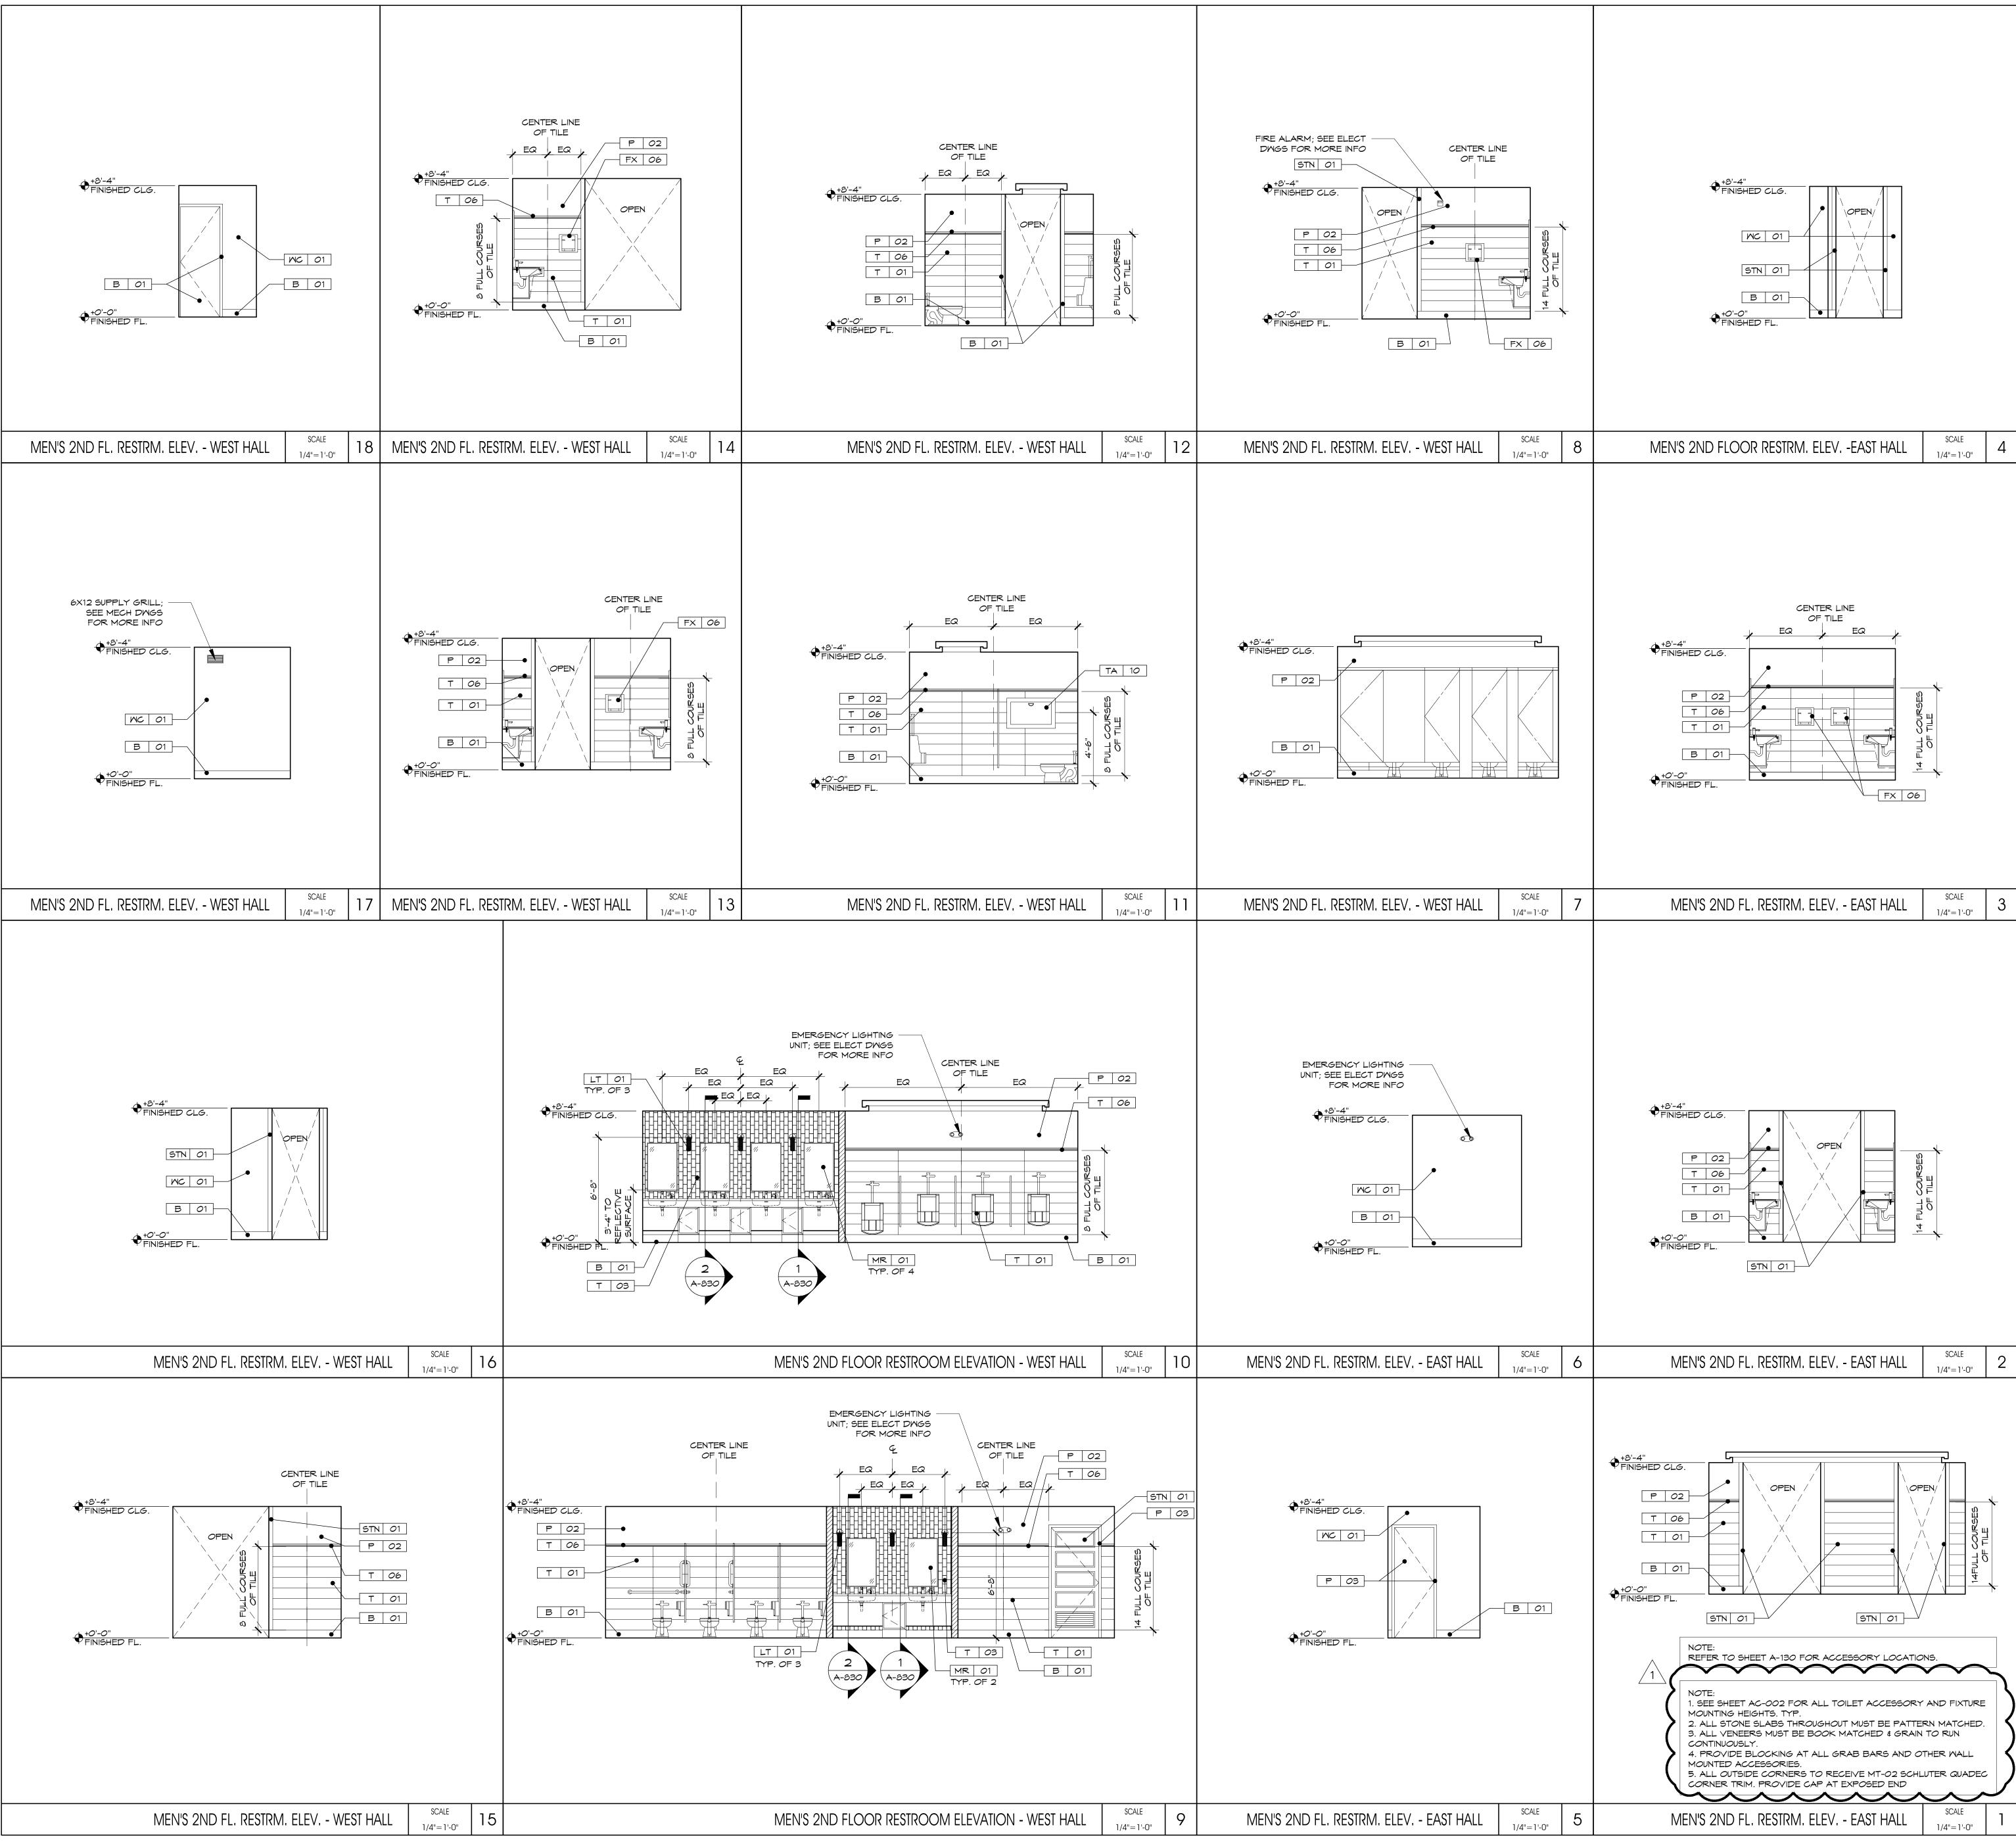


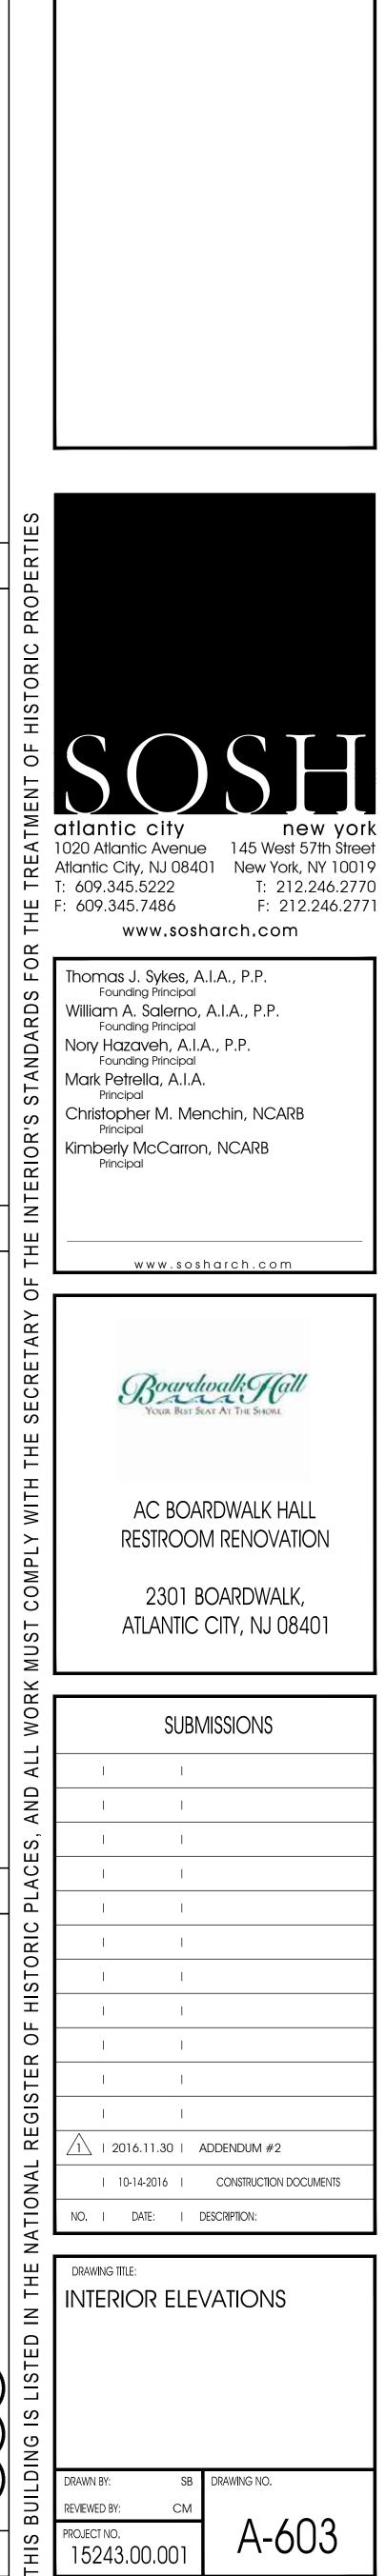


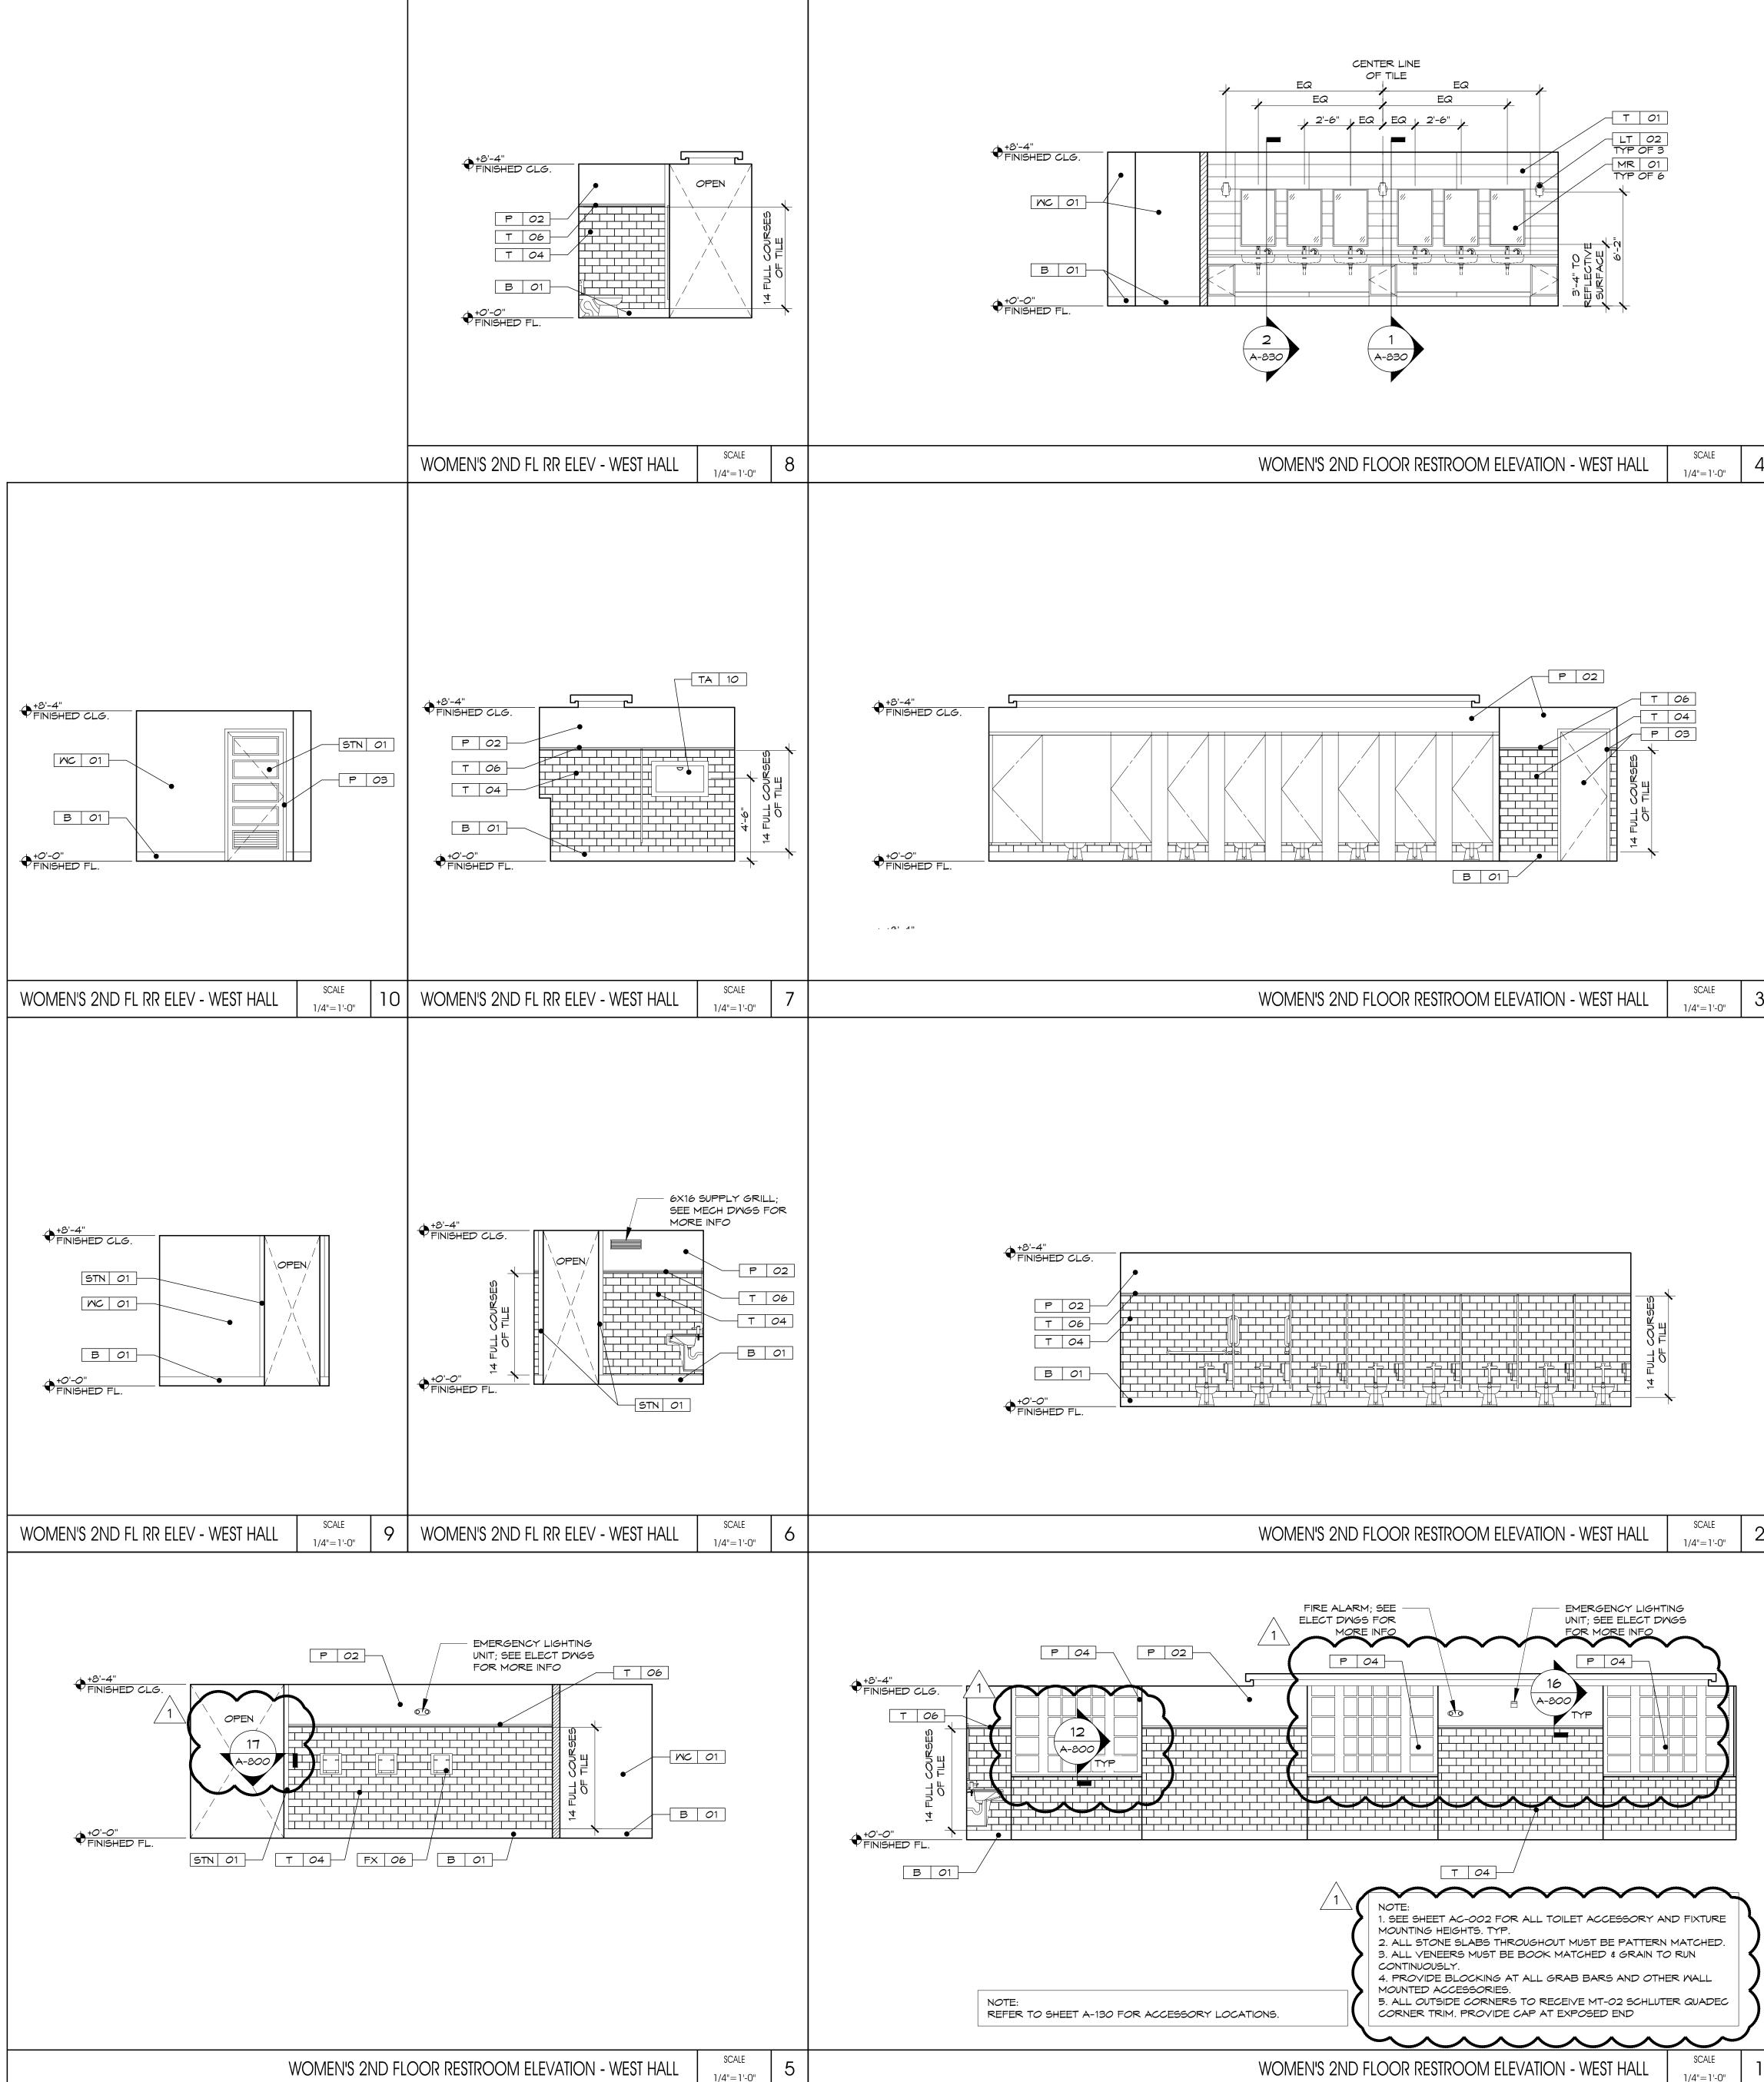

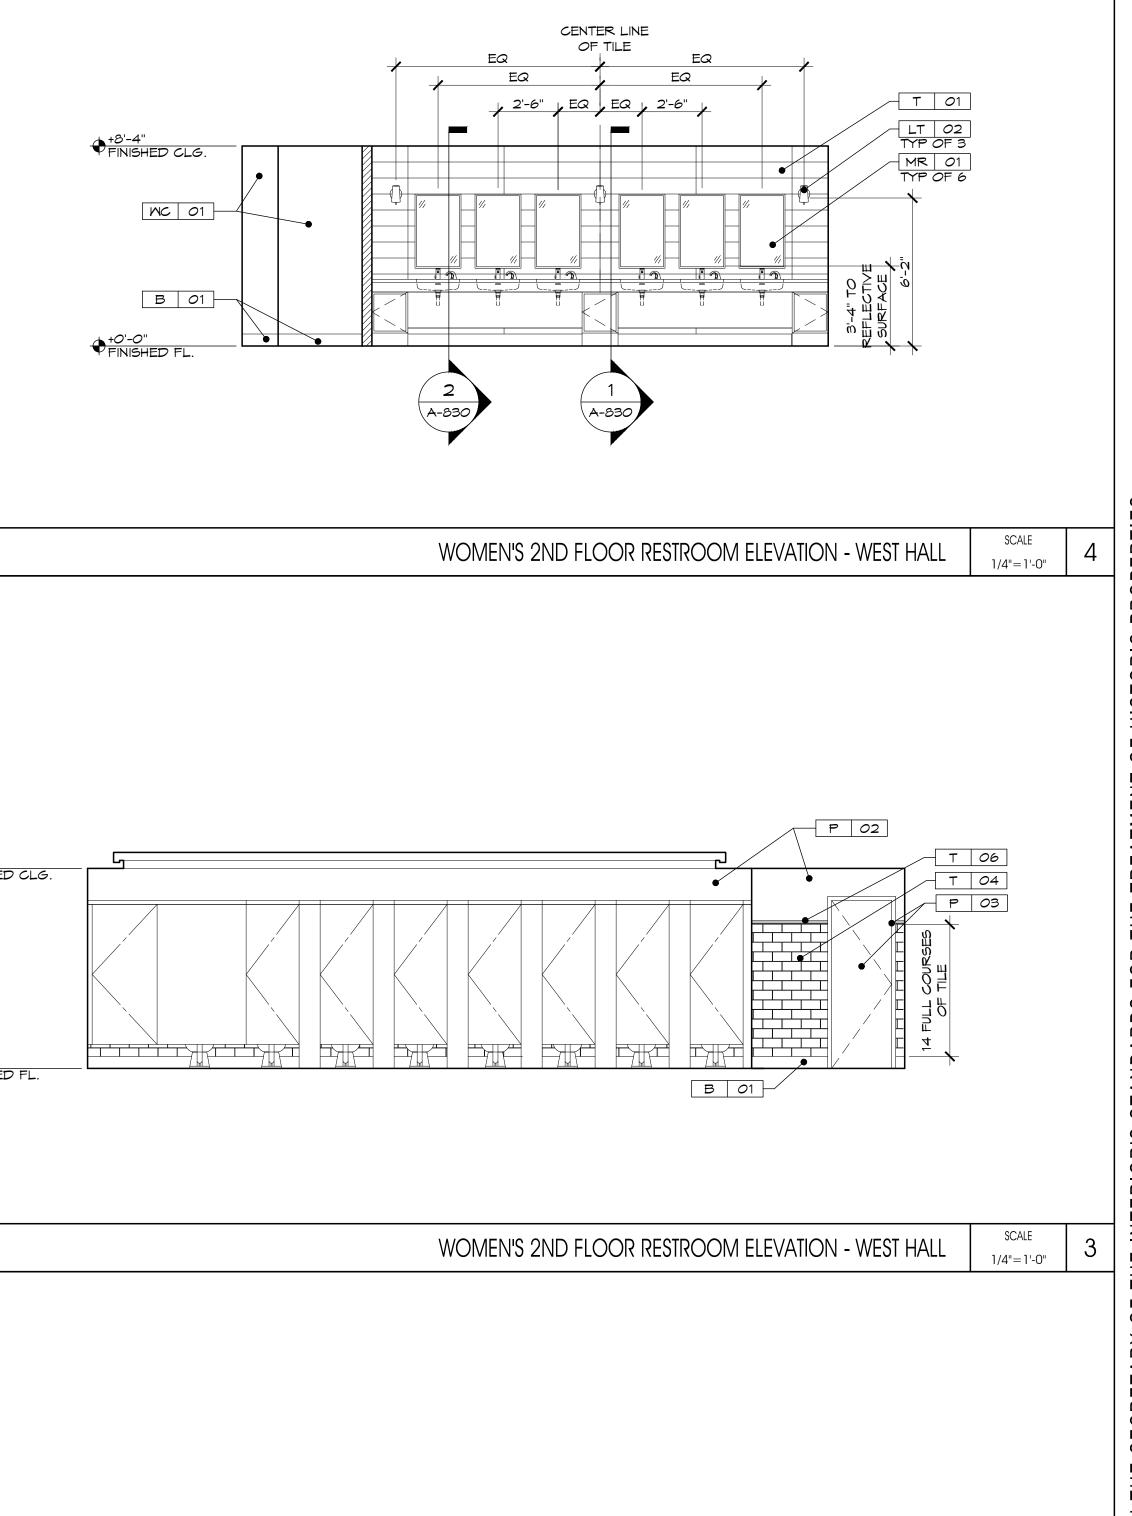

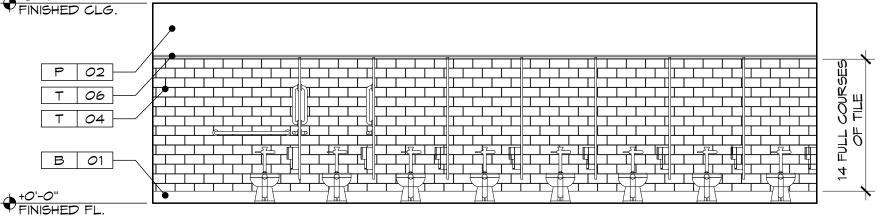

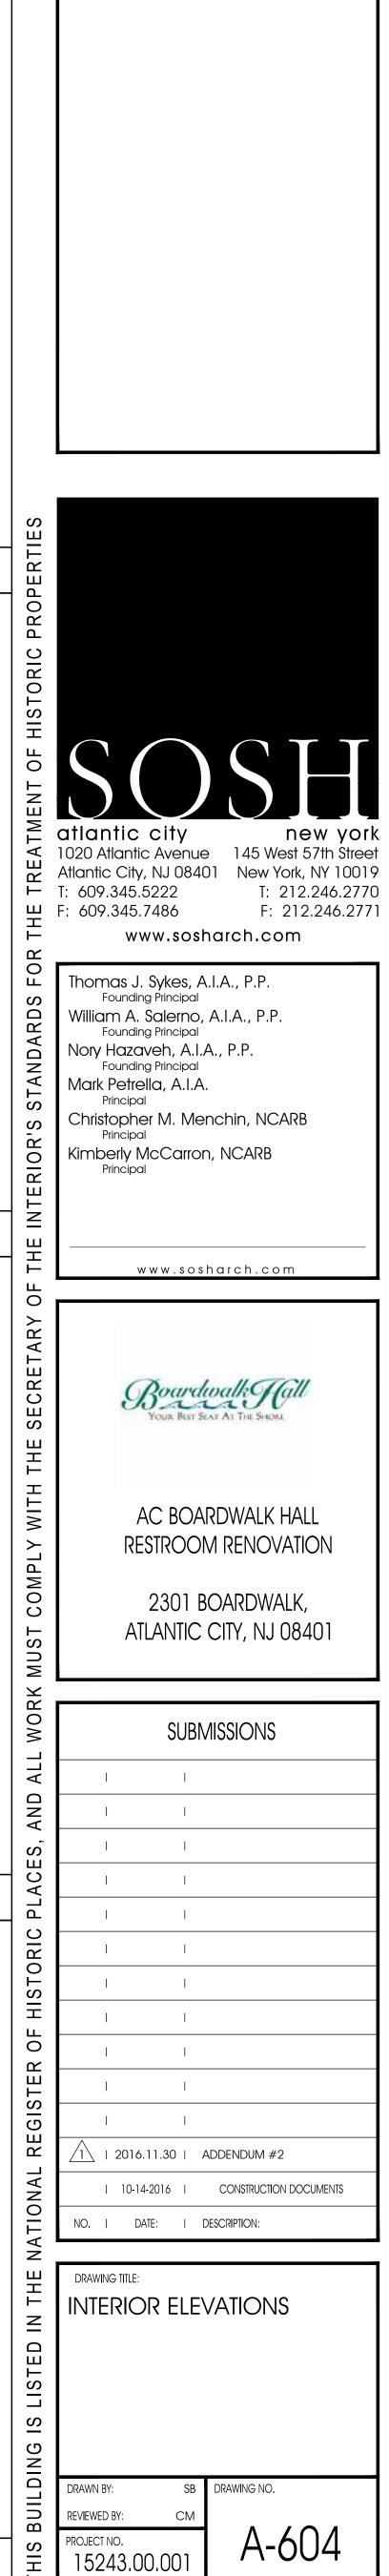

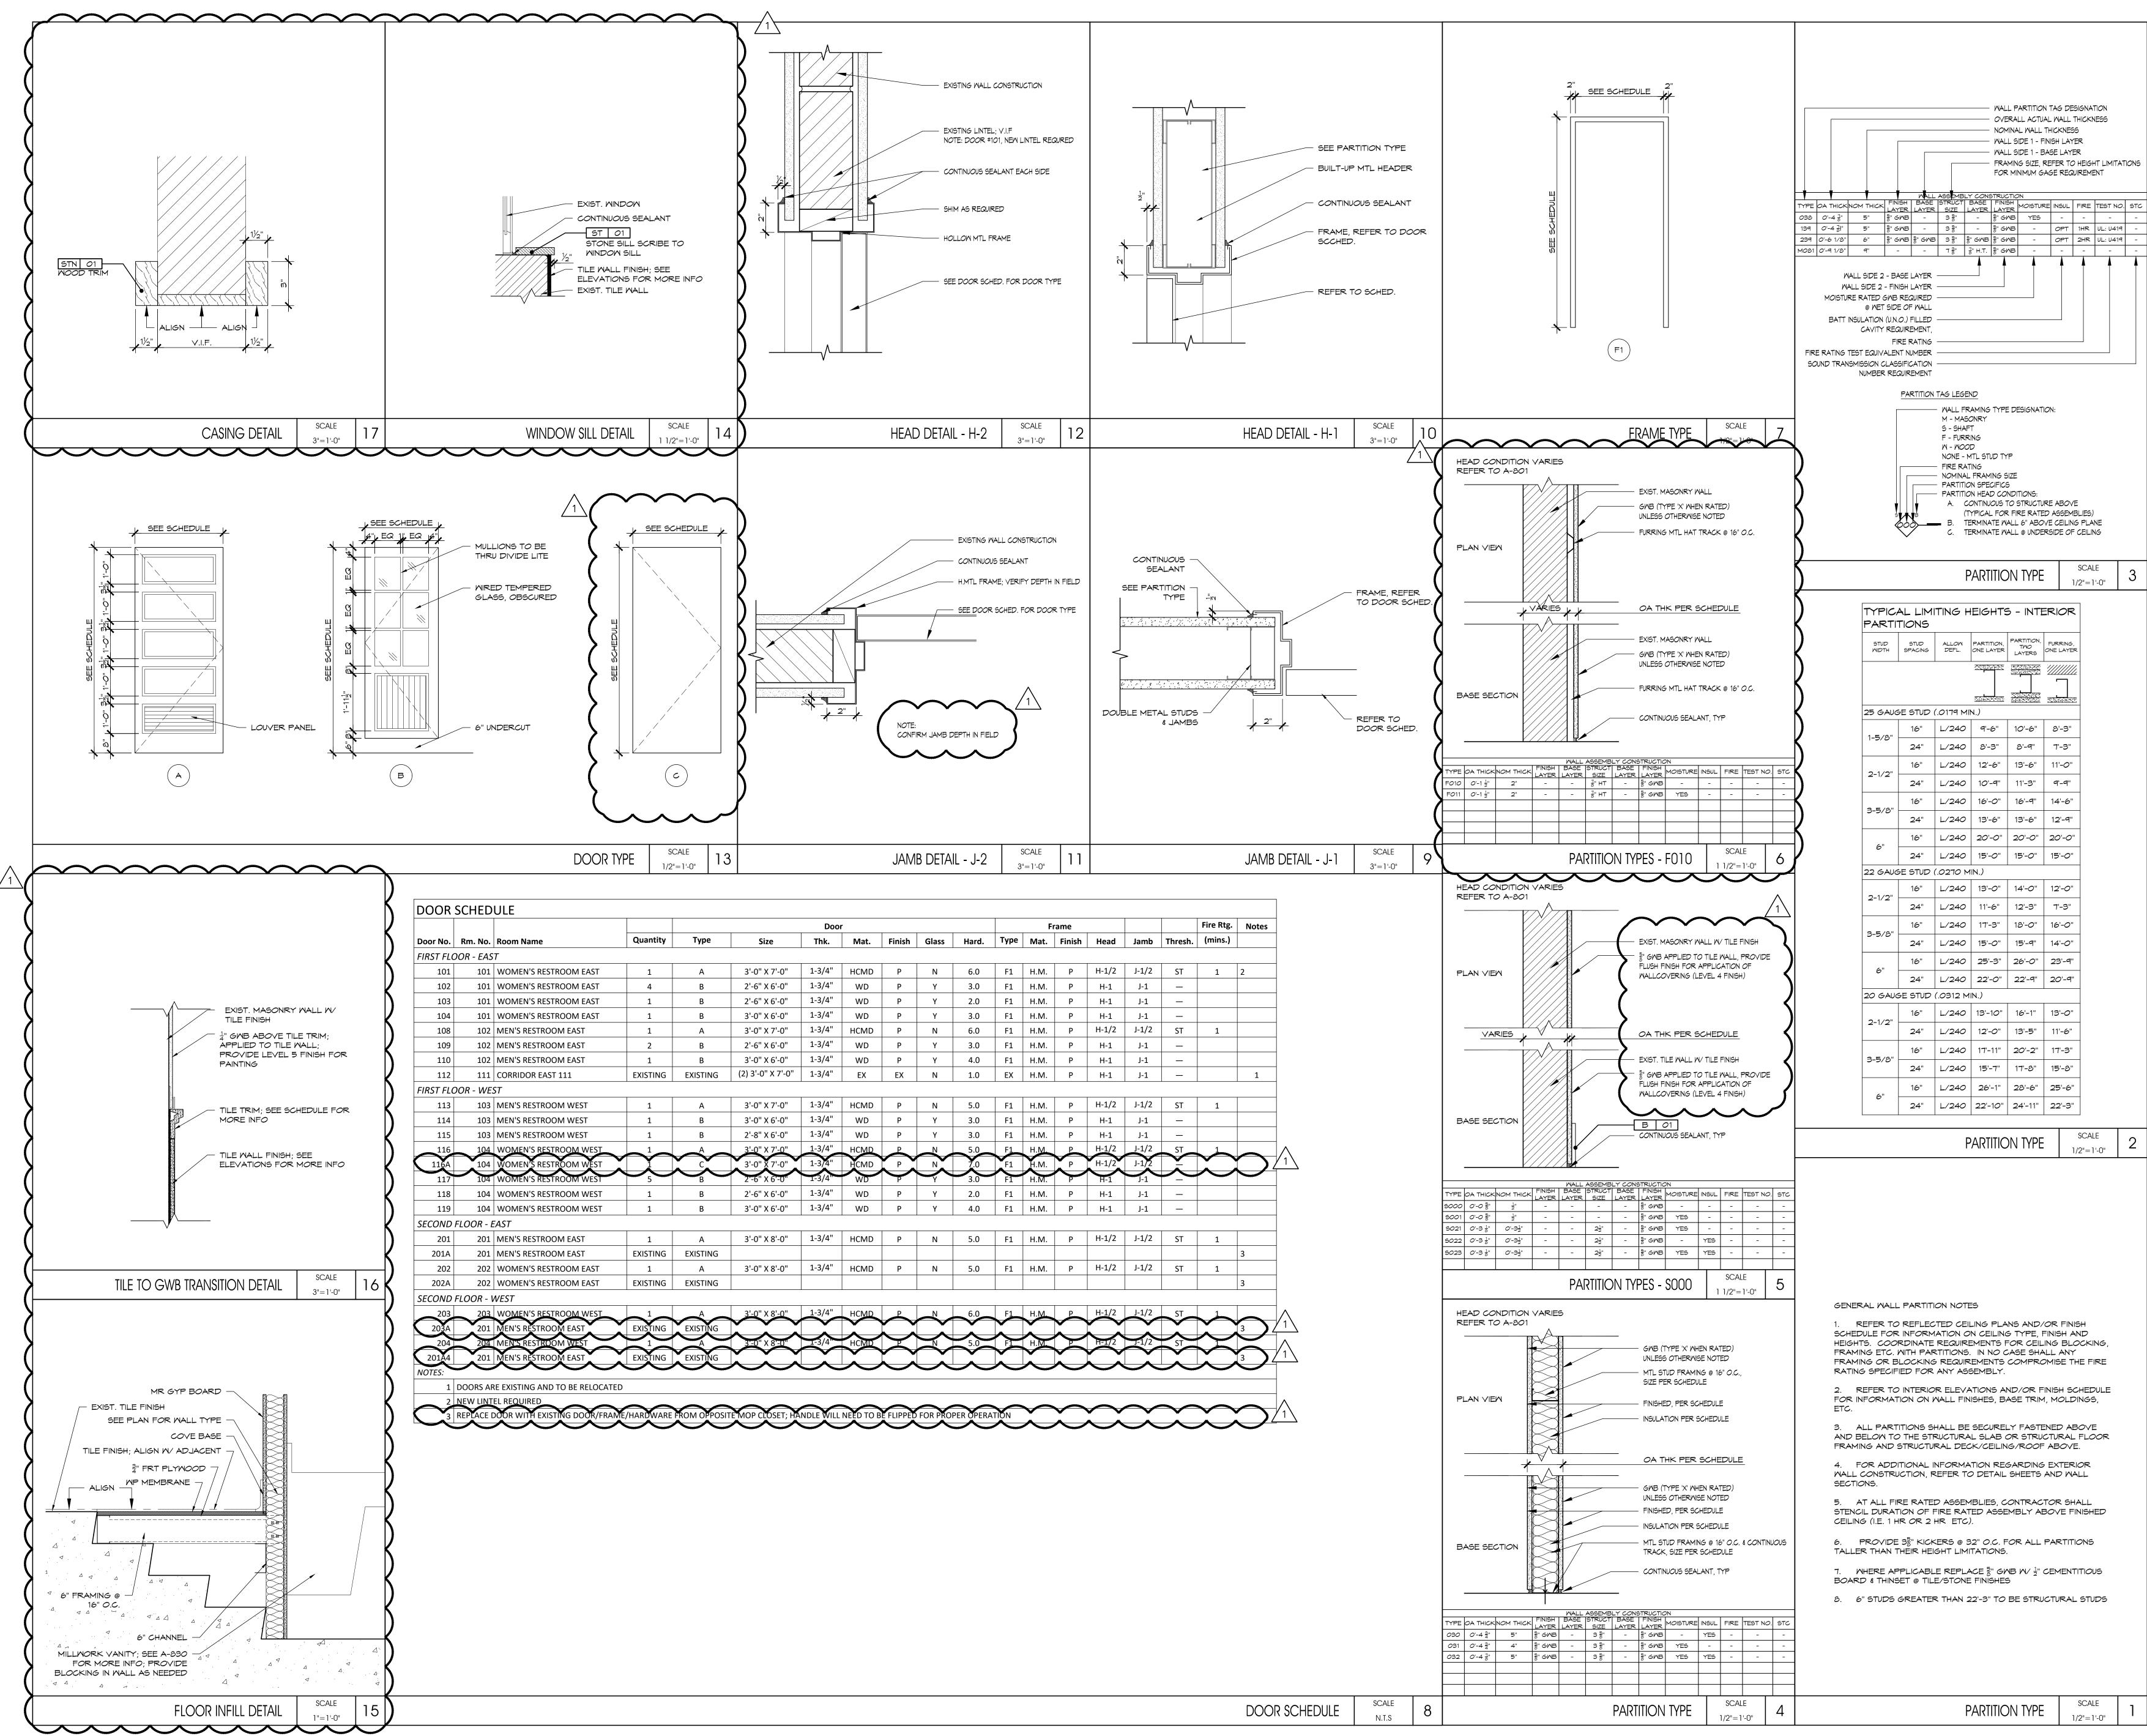

	Door						Frame						Fire Rtg.	Notes
Туре	Size	Thk.	Mat.	Finish	Glass	Hard.	Туре	Mat.	Finish	Head	Jamb	Thresh.	(mins.)	
А	3'-0" X 7'-0"	1-3/4"	HCMD	Р	N	6.0	F1	H.M.	Р	H-1/2	J-1/2	ST	1	2
В	2'-6" X 6'-0"	1-3/4"	WD	Р	Y	3.0	F1	H.M.	Р	H-1	J-1			
В	2'-6" X 6'-0"	1-3/4"	WD	Р	Y	2.0	F1	H.M.	Р	H-1	J-1			
В	3'-0" X 6'-0"	1-3/4"	WD	Р	Y	3.0	F1	H.M.	Р	H-1	J-1	_		
А	3'-0" X 7'-0"	1-3/4"	HCMD	Р	N	6.0	F1	H.M.	Р	H-1/2	J-1/2	ST	1	
В	2'-6" X 6'-0"	1-3/4"	WD	Р	Y	3.0	F1	H.M.	Р	H-1	J-1	_		
В	3'-0" X 6'-0"	1-3/4"	WD	Р	Y	4.0	F1	H.M.	Р	H-1	J-1	_		
XISTING	(2) 3'-0" X 7'-0"	1-3/4"	EX	EX	N	1.0	EX	H.M.	Р	H-1	J-1	_		1
					•						•			
А	3'-0" X 7'-0"	1-3/4"	HCMD	Р	N	5.0	F1	H.M.	Р	H-1/2	J-1/2	ST	1	
В	3'-0" X 6'-0"	1-3/4"	WD	Р	Y	3.0	F1	H.M.	Р	H-1	J-1	_		
В	2'-8" X 6'-0"	1-3/4"	WD	Р	Y	3.0	F1	H.M.	Р	H-1	J-1	_		
A	<u>3'-0" X 7'-0"</u>	1-3/4"	HCMD	Р	N	5.0	F <u>1</u>	H.M.	Р	H-1/2	J-1/2	ST	1	
C	3'-0" X 7'-0"	1-3/4"	HCMD	Р	N	7.0	F1	H.M.	Р	H-1/2	J-1/2	Y		\square
B	2'-6" X 6'-0"	1-3/4"	WD	P	Ý	3.0	F1	H.M.	P	H-1	J-1		\sim	\sim
В	2'-6" X 6'-0"	1-3/4"	WD	Р	Y	2.0	F1	H.M.	Р	H-1	J-1	_		
В	3'-0" X 6'-0"	1-3/4"	WD	Р	Y	4.0	F1	H.M.	Р	H-1	J-1	_		
·						•					•			•
А	3'-0" X 8'-0"	1-3/4"	HCMD	Р	N	5.0	F1	H.M.	Р	H-1/2	J-1/2	ST	1	
EXISTING														3
А	3'-0" X 8'-0"	1-3/4"	HCMD	Р	N	5.0	F1	H.M.	Р	H-1/2	J-1/2	ST	1	
EXISTING														3
									•					•
A	<u>3'-0" X 8'-0"</u>	<u>1</u> -3/4"	HCMD	Р	N	6.0	F <u>1</u>	Н. <u>М.</u>	P	H-1/2	J-1/2	ST	1	
EXISTING														3
	<u>3'=0" X 8'=0"</u>	1-3/4"	нсмр			5.0	FI	H.M.		H-1/2	J-1/2	ST		\leq
							\sim	\sim						

SOSH
atlantic citynew york1020 Atlantic Avenue145 West 57th StreetAtlantic City, NJ 08401New York, NY 10019
T: 609.345.5222 F: 609.345.7486 www.sosharch.com
Thomas J. Sykes, A.I.A., P.P. Founding Principal William A. Salerno, A.I.A., P.P. Founding Principal
Nory Hazaveh, A.I.A., P.P. Founding Principal Mark Petrella, A.I.A. Principal Christopher M. Menchin, NCARB
Principal Kimberly McCarron, NCARB Principal
www.sosharch.com
Boardwalk Hall YOUR BEST SEAT AT THE SHORE
AC BOARDWALK HALL RESTROOM RENOVATION
2301 BOARDWALK, ATLANTIC CITY, NJ 08401
SUBMISSIONS
I 2016.11.30 ADDENDUM #2 I 10-14-2016 I CONSTRUCTION DOCUMENTS NO. I DATE: I DESCRIPTION:
DRAWING TITLE: WALL PARTITION TYPES
HEIGHT LIMITATION CHART PARTITION LEGEND
DRAWN BY: SB DRAWING NO. REVIEWED BY: CM PROJECT NO. 15243.00.001 A-800