DWG NO.		Issue:	Issue:	Issue:	Issue:
		CONSTRUCTION DOCUMENTS 10-14-2016	11.30.2016	20.2016	
		ME	30.2	20.2	
		9. 19	11.3	12.2	
		DC		#2	
		14-1	ADDENDUM #2		
		10-11		ADDENDUM	
		IRU			
		NS	ADI	ADI	
		C			
ARCHITECTURE					
AC-000	COVER SHEET	•	•	•	
AC-001	MOUNTING HEIGHTS	•			
AC-100	FIRST FLOOR EGRESS PLAN	•			
AC-102	SECOND FLOOR EGRESS PLAN	•			
AD-101	FIRST FLOOR DEMOLITION PLAN	•	•	•	
		•	•		
AD-102	SECOND FLOOR DEMOLITION PLAN				
AD-201	FIRST FLOOR RESTROOM DEMOLITION REFLECTED CEILING PLANS	•	•		
AD-202	SECOND FLOOR RESTROOM DEMOLITION REFLECTED CEILING PLANS	•	•		
A-101	FIRST FLOOR PLAN	•	•	•	
A-102	SECOND FLOOR PLAN	•	•		
A-111	FIRST FLOOR FINISH PLAN	•	•		
		•	•		
A-112	SECOND FLOOR FINISH PLAN				
A-201	FIRST FLOOR REFLECTED CEILING PLAN	•	•		
4-202	SECOND FLOOR REFLECTED CEILING PLAN	•	•		
A-600	INTERIOR ELEVATIONS	•	•	•	
A-601	INTERIOR ELEVATIONS	•	•		
A-602	INTERIOR ELEVATIONS	•	•		
		•	•		
A-603		-	-		
4-604	INTERIOR ELEVATIONS	•	•		
4-800	PARTITION SCHEDULE	•	•		
A-910	FINISH SCHEDULE	•			
A-911	FINISH SCHEDULE	•			
MECHANICAL					
M-001	MECHANICAL SPECIFICATIONS, LEGEND, SYMBOLS & ABBREVIATIONS	•			
M-002	MECHANICAL SCHEDULES & DETAILS	•			
		•			
MD-100	MECHANICAL DEMOLITION PLANS				
M-100	MECHANICAL BOARDWALK LEVEL NEW WORK PLANS	•			
M-101	MECHANICAL CONCOURSE LEVEL NEW WORK PLANS	•			
M-102	MECHANICAL CONCOURSE LEVEL NEW WORK PLANS	•			
PLUMBING					
P-000	PLUMBING LEGEND, NOTES & SCHEDULES	•			
PD-100	FIRST & SECOND FLOOR OVERALL DEMOLITION LOCATION PLANS	•			
PD-101	FIRST FLOOR RESTROOM DEMOLITION PLANS	•			
PD-102	SECOND FLOOR RESTROOM DEMOLITION PLANS	•			
P-100	FIRST & SECOND FLOOR OVERALL NEW WORK LOCATION PLANS PLUMBING	•			
P-101	FIRST FLOOR RESTROOM NEW WORK PLANS PLUMBING	•	1	•	
			<u> </u>		
P-102	SECOND FLOOR RESTROOM NEW WORK PLANS PLUMBING	•		•	
	PLUMBING DETAILS & RISER DIAGRAMS	•			
P-200					
⁵ -200					-
FIRE PROTECTION	FIRE PROTECTION LEGEND, NOTES & DETAILS	•			
FIRE PROTECTION	FIRE PROTECTION LEGEND, NOTES & DETAILS FIRST & SECOND FLOOR OVERALL NEW WORK LOCATION PLANS FIRE PROTECTION	•			
FIRE PROTECTION FP-000 FP-100					
FIRE PROTECTION FP-000 FP-100	FIRST & SECOND FLOOR OVERALL NEW WORK LOCATION PLANS FIRE PROTECTION	•			
FIRE PROTECTION FP-000 FP-100 FP-101	FIRST & SECOND FLOOR OVERALL NEW WORK LOCATION PLANS FIRE PROTECTION	•			
FIRE PROTECTION FP-000 FP-100 FP-101 ELECTRICAL	FIRST & SECOND FLOOR OVERALL NEW WORK LOCATION PLANS FIRE PROTECTION	•	•		
FIRE PROTECTION FP-000 FP-100 FP-101 ELECTRICAL E-001	FIRST & SECOND FLOOR OVERALL NEW WORK LOCATION PLANS FIRE PROTECTION FIRST & SECOND FLOOR RESTROOM NEW WORK PLANS FIRE PROTECTION ELECTRICAL SHEET SPECIFICATIONS	•	•		
FIRE PROTECTION FP-000 FP-100 FP-101 ELECTRICAL E-001 E-002	FIRST & SECOND FLOOR OVERALL NEW WORK LOCATION PLANS FIRE PROTECTION FIRST & SECOND FLOOR RESTROOM NEW WORK PLANS FIRE PROTECTION ELECTRICAL SHEET SPECIFICATIONS ELECTRICAL LEGEND & GENERAL NOTES	•	-		
FIRE PROTECTION FP-000 FP-100 FP-101 ELECTRICAL E-001 E-002 E-100	FIRST & SECOND FLOOR OVERALL NEW WORK LOCATION PLANS FIRE PROTECTION FIRST & SECOND FLOOR RESTROOM NEW WORK PLANS FIRE PROTECTION ELECTRICAL SHEET SPECIFICATIONS ELECTRICAL LEGEND & GENERAL NOTES PARTIAL ELECTRICAL FIRST FLOOR PLANS	• • FIRE PROTECTION P-000 P-100 P-101 ELECTRICAL E-001 E-002	FIRST & SECOND FLOOR OVERALL NEW WORK LOCATION PLANS FIRE PROTECTION FIRST & SECOND FLOOR RESTROOM NEW WORK PLANS FIRE PROTECTION ELECTRICAL SHEET SPECIFICATIONS ELECTRICAL LEGEND & GENERAL NOTES	• • 
SCALE DRAWING LIST N.T.S.

THE SCOPE OF THIS PROJECT IS TO INCLUDE, BUT IS NOT LIMITED TO: THE DEMOLITION OF THE EXISTING RESTROOMS & REPLACEMENT OF FIXTURES, PARTITIONS, MILLWORK, FINISHES, INCLUDING PLUMBING, HEATING, & ELECTRICAL SYSTEMS. THIS PROJECT QUALIFIES AS A "RECONSTRUCTION," PER THE REHABILITATION SUBCODE. ALL WORK MUST COMPLY WITH THE AFOREMENTIONED GOVERNING CODES AS OUTLINED IN THE CODE REVIEW SECTION OF THESE CONSTRUCTION

DOCUMENTS. THESE DOCUMENTS ARE SUBJECT TO MODIFICATION AS NECESSARY TO MEET CODE REQUIREMENTS OR TO FACILITATE STRUCTURAL, MECHANICAL, PLUMBING AND ELECTRICAL INSTALLATIONS, OR INCORPORATE ARCHITECTURAL DESIGN IMPROVEMENTS.


ATLANTIC CITY BOARDWALK HALL


ALL WORK SHALL BE PERFORMED IN STRICT ACCORDANCE WITH THE CODES OUTLINED IN THE CODE REVIEW PORTION OF THE CONSTRUCTION DOCUME AND ALL APPLICABLE LOCAL CODES, ORDINANCES AND REGULATIONS HAVING JURISDICTION, AS STATED IN THE CODE ANALYSIS.	IENTS	APPLICABLE CODES	
DO NOT SCALE THE DRAWINGS, USE CALCULATED DIMENSIONS ONLY. SCALES INDICATED REFER TO SHEETS PRINTED AT 30"x42" (INCHES) SIZE AND ARE I	NOT	NEW JERSEY ADMINISTRATIVE CODE - REHAB SUBCODE	NJA
APPLICABLE TO REDUCED DRAWINGS.		INTERNATIONAL BUILDING CODE - NEW JERSEY EDITION NATIONAL STANDARD PLUMBING CODE	
ALL DIMENSIONS INDICATED ON THESE DRAWINGS OF EXISTING CONDITIONS ARE APPROXIMATE AND SHALL BE FIELD VERIFIED TO THE SATISFACTION O CONTRACTOR PRIOR TO THE WORK COMMENCING.		NATIONAL ELECTRICAL CODE	
IT IS THE CONTRACTOR'S RESPONSIBILITY TO FIELD CHECK ALL DIMENSIONS AND FIXTURES AND NOT TO DEVIATE FROM THESE DESIGNS AND TO DETERM		ASHRAE	90
ACTUAL CONSTRUCTION DETAILS AND FABRICATE IN ACCORDANCE WITH ACCEPTABLE STANDARDS OF PRACTICE AND PROCEDURES. ANY DEVIATION FRO THESE DESIGNS SHALL BE REPORTED TO THE ARCHITECT.		INTERNATIONAL MECHANICAL CODE	
THE CONTRACTOR SHALL PROVIDE PROTECTION FOR THE GENERAL PUBLIC AND CONSTRUCTION WORKERS IN AND AROUND THE CONSTRUCTION AREA,	<i>'</i>	INTERNATIONAL FUEL GAS CODE	
FOR THE ADJACENT PROPERTY AND PERSONS. THE CONTRACTOR SHALL PROVIDE ADEQUATE BARRIERS TO EXERCISE CONTROL OF SAFE INGRESS AND EG THE PREMISES. FIRE EXITS SHALL BE MAINTAINED AT ALL TIMES, AND AT NO TIME BE BLOCKED. THE CONTRACTOR SHALL BARRICADE ALL UNSAFE OR	GRESS OF	INTERNATIONAL ENERGY CONSERVATION CODE BARRIER-FREE SUBCODE	NJA
NJURIOUS CONDITIONS.		ICC/ANSI	A117
THE CONTRACTOR SHALL CHECK AND VERIFY THE EXISTING CONDITIONS AT THE SITE AGAINST THE DRAWINGS AND SPECIFICATIONS, AND INFORM THE ARCHITECT IMMEDIATELY OF ANY DISCREPANCIES PRIOR TO COMMENCEMENT OF WORK.		NATIONAL FIRE PROTECTION ASSOCIATION	
CONTRACTOR SHALL LAY OUT ALL WALLS, FLOOR PENETRATIONS, ETC. FOR OWNER AND ARCHITECT TO REVIEW AND APPROVE PRIOR TO COMMENCEM	/IENT OF		
CONSTRUCTION. WORK, AT TIMES, MAY BE CONDUCTED IN A BUILDING OPERATED AND OCCUPIED BY THE OWNER AND THEIR AGENTS CONCURRENTLY. ALL DEMOLITION CONSTRUCTION OPERATIONS WILL BE COORDINATED WITH THE OWNER PRIOR TO COMMENCEMENT. CONTRACTOR SHALL NOTIFY THE OWNER WITH A MINIMUM FIVE (5) BUSINESS DAYS' NOTICE OF ANY DEMOLITION ACTIVITIES, UTILITY SHUT DOWNS OR DELIVERIES.		THE WORK IN THIS PROJECT, AS DEFINED BY CHAPTER 5.23-6 "REHABILITATION SUBCODE" C CONSTRUCTION CODE OF THE STATE OF NEW JERSEY, QUALIFIES AS A RECONSTRUCTION. T PHASE INCLUDES THE SELECTIVE DEMOLITION OF EXTERIOR WALLS, INTERIOR WALLS, FLOO FINISHES, EQUIPMENT, FIXTURES, DUCTWORK & PLUMBING. BUILDING SUMMARY	THE WORK I
ALL EXISTING FACILITIES, UTILITIES, AND EQUIPMENT SHALL BE PROTECTED BY THE CONTRACTOR DURING THE ENTIRE PERFORMANCE OF THE WORK. AF		USE GROUP	
DISTURBED OR DAMAGED BY THE CONTRACTOR SHALL BE REPAIRED AND/OR REPLACED BY THE CONTRACTOR AT NO ADDITIONAL COST TO THE OWNER.		CONSTRUCTION TYPE	
ALL EXISTING FACILITIES, UTILITIES, AND EQUIPMENT SHALL BE PROTECTED BY THE CONTRACTOR DURING THE ENTIRE DURATION OF THE PROJECT. ARE A DISTURBED OR DAMAGED BY THE CONTRACTOR SHALL BE REPAIRED AND/OR REPLACED BY THE CONTRACTOR AT NO ADDITIONAL COST TO THE OWNER.		SPRINKLERS	
THE CONTRACTOR SHALL BE RESPONSIBLE FOR RECORD KEEPING ALL EXPOSED CONDITIONS DISCOVERED DURING THE WORK AND ALL AS-BUILT CONDIT		FIRST FLOOR AREA OF WORK SECOND FLOOR AREA OF WORK	
THE CONTRACTOR SHALL BE RESPONSIBLE FOR THE INTEGRITY OF THE EXISTING STRUCTURE DURING THE CONSTRUCTION PERIOD AND SHALL TAKE ALL		TOTAL GROSS AREA OF WORK	
NECESSARY MEASURES TO PREVENT ANY DAMAGE TO THE STRUCTURE, ITS OCCUPANTS AND ITS CONTENTS.		OCCUPANT LOAD	
THE CONTRACTOR SHALL PROVIDE ALL NECESSARY SHORING AND BRACING TO SUPPORT CONSTRUCTION UNTIL PERMANENT SUPPORT IS ERECTED FOR T NORK, THE CONTRACTOR SHALL TAKE ALL NECESSARY MEASURE TO PREVENT COLLAPSE OF WALLS, SLABS, ETC.		REF - INTERNATIONAL BUILDING CODE - NEW JERSEY EDITION	2015
THE CONTRACTOR SHALL BE RESPONSIBLE FOR DAILY CLEAN UP OF CONSTRUCTION DEBRIS. ALL UNUSED MATERIAL AND DEBRIS SHALL BE LEGALLY DISP OF, AWAY FROM THE PREMISES. NO ON-SITE STORAGE OR BURIAL OF DEBRIS SHALL BE ALLOWED.		AREA OF WORK	0CCl 3,460
CONTRACTORS AND THEIR SUBSEQUENT CONTRACTORS MUST PRESERVE THE INTEGRITY OF THE DESIGN WITHIN PHYSICAL CONDITIONS AND LIMITATION		AREA OF WORK NOTE: REFER TO EGRESS PLANS FOR MORE INFORMATION	J ^{3,400}
ALL DECORATIVE MATERIALS MEETING THE REQUIREMENTS AS STATED IN THE JURISDICTIONAL CODES ARE TO BE NON-COMBUSTIBLE FOR FIRE RESISTAI AND SHALL COMPLY WITH ALL OTHER GOVERNING CODES AND FIRE SPECIFICATIONS AT THE LOCAL AUTHORITARIAN LEVEL AND BEYOND AS OUTLINED I		FIRE RESISTANCE RATING REQUIREMENTS	
CODE REVIEW SECTION OF THE CONSTRUCTION DOCUMENTS.		REF - INTERNATIONAL BUILDING CODE - NEW JERSEY EDITION	2015
ALL ELECTRICAL OUTLETS, PLUMBING FIXTURES, MECHANICAL GRILLES, ETC. SHOWN ON THE ARCHITECTURAL DRAWINGS ARE INDICATED TO SET THE GE OCATION FOR EACH COMPONENT. THE CONTRACTOR SHALL REFER TO ALL DOCUMENTS, INCLUDING, BUT LIMITED TO, THE MECHANICAL, PLUMBING A			601
LECTRICAL DRAWINGS FOR THE COMPLETE LAYOUT OF EACH RESPECTIVE ITEM.		PRIMARY STRUCTURAL FRAME BEARING WALLS	2 HR
LL NEW PIPING AND ELECTRICAL CONDUITS SHALL BE CONCEALED WITHIN NEW CONSTRUCTION UNLESS OTHERWISE NOTED.		EXTERIOR	2
ILL EXPOSED WELDS TO BE GROUND AND MADE SMOOTH.		INTERIOR	
HROUGHOUT THE DURATION OF THE WORK, THE PLUMBING CONTRACTOR SHALL CAP EXISTING SANITARY LINES TO BE RE-UTILIZED.		NON BEARING WALLS & PARTITIONS	
HE INDICATION OF SUBSTRATE AND THE CONFIGURATION OF CONCEALED ITEMS AND MATERIALS IS FOR GENERAL REFERENCE ONLY. THE CONTRACTOR OT BE ENTITLED TO ADDITIONAL COMPENSATION FOR ANY VARIANCE BETWEEN ACTUAL EXISTING CONDITIONS AND THAT REPRESENTED ON THE DRAY		EXTERIOR	R X>3
VORK NOT INDICATED ON A PART OF THE DRAWINGS, BUT REASONABLY IMPLIED TO BE SIMILAR TO THAT SHOWN AT CORRESPONDING PLACES, SHALL I			
ROVIDED BY THE CONTRACTOR AT NO ADDITIONAL COST TO THE OWNER.		FLOOR CONSTRUCTION & SECONDARY MEMBERS	2 HR
/INOR DETAILS OR INCIDENTAL ITEMS NOT USUALLY SHOWN OR SPECIFIED, BUT NECESSARY FOR A PROPER AND COMPLETE INSTALLATION OF ANY PAR THE WORK SHALL BE INCLUDED AS REQUIRED, AS IF THEY WERE INDICATED ON THE DRAWINGS.			
ALL ITEMS LABELED "EXISTING" ARE EXISTING "TO REMAIN" UNLESS NOTED OTHERWISE. ITEMS NOT LABELED "EXISTING" ARE TO BE PROVIDED.		INTERIOR WALL & CEILING FINISH REQUIR	_
THE TERM "PROVIDE" SHALL MEAN FURNISH AND INSTALL, AS IT IS USED THROUGHOUT THE NOTES ON THE DRAWINGS AND IN THE SPECIFICATIONS.		REF - INTERNATIONAL BUILDING CODE - NEW JERSEY EDITION	2015
HE CONTRACTOR SHALL PROVIDE SEALANT JOINTS BETWEEN ALL DISSIMILAR BUILDING MATERIALS, UNLESS OTHERWISE NOTED. REFER TO SPECIFICAT	TIONS		(SPR
OR SCHEDULE OF SEALANTS. DETAILS AND SECTIONS ON THE DRAWINGS ARE SHOWN AT SPECIFIC LOCATIONS, AND ARE INTENDED TO SHOW GENERAL REQUIREMENTS THROUGHOU		EXIT ENCLOSURES AND EXIT PASSAGEWAYS	
DETAILS AND SECTIONS ON THE DRAWINGS ARE SHOWN AT SPECIFIC LOCATIONS, AND ARE INTENDED TO SHOW GENERAL REQUIREMENTS THROUGHOU DETAILS NOTED AS "TYPICAL" IMPLY ALL SIMILAR CONDITIONS ARE TO BE TREATED AS SUCH.		CORRIDORS	(
ALL FIRE-RATED CONSTRUCTION SHALL MEET THE FIRE-RESISTIVE RATINGS AND OTHER REQUIREMENTS OF LOCAL LAWS, ORDINANCES, REGULATIONS AND	AND	ROOMS AND ENCLOSED SPACES	
AUTHORITIES HAVING JURISDICTION AS OUTLINED IN THE CODE REVIEW SECTION OF THE CONSTRUCTION DOCUMENTS. ALL PENETRATIONS THROUGH FIRE-RATED CONSTRUCTION SHALL RECEIVE FIRE STOPPING, FIRE DAMPERS, FIRE SAFEING, ETC. TO MAINTAIN THE FIRE-RA	RATED	PLUMBING FIXTURE CALCULATION	
CONSTRUCTION. SUCH PENETRATIONS SHALL INCLUDE, BUT NOT BE LIMITED TO, TELEPHONE, DATA, LIGHT FIXTURES, JUNCTION BOXES, DUPLEX RECEPT TRE ALARM SYSTEMS, ROOM ACCESSORIES, ETC THE RATING MUST CONTINUE AROUND AND BEHIND THE PENETRATION SO AS TO INSURE THE INTEGR RATED ASSEMBLY.	TACLES,	REF - NATIONAL STANDARD PLUMBING CODE WATER CLOSETS PROVIDED	2015 7
WHERE SURFACE DOOR CLOSURE ARE REQUIRED, THE CONTRACTOR SHALL ALLOW A MINIMUM OF SIX INCHES CLEAR TO ANY PARTITION ON THE HINGE	E SIDE OF	MEN	N 24
THE DOOR, UNLESS OTHERWISE INDICATED.		WOMEN	32
ALL PAINTS ARE TO MEET CLASS 'A' FIRE RATING OVER NON-COMBUSTIBLE SURFACES. PAINTS ARE TO CONFORM TO ALL ENVIRONMENTAL CODES.		LAVATORIES PROVIDED	
ALL REQUIRED FIRE TREATED MATERIALS SHALL COMPLY WITH ALL GOVERNING CODES AND FIRE SPECIFICATIONS AT THE LOCAL AUTHORITARIAN LEVEL . SEYOND AS OUTLINED IN THE CODE REVIEW SECTION OF THE CONSTRUCTION DOCUMENTS.		MEN	
ALL WOOD USED SHALL BE FIRE-RETARDANT LUMBER AND SHALL COMPLY WITH ALL GOVERNING CODES AND FIRE SPECIFICATIONS AT THE LOCAL		DRINKING FOUNTAIN NOT PROVIDED - EXCEPTIONS WHEN DRINKING WATER SERVICE IS AVA	
AUTHORITARIAN LEVEL AND BEYOND AS OUTLINED IN THE CODE REVIEW SECTION OF THE CONSTRUCTION DOCUMENTS.		PORTABLE FIRE EXTINGUISHERS	
ALL LAMINATED SURFACES SHALL MEET STANDARDS CLASS I, 0-25 FLAME SPREAD AND SMOKE DEVELOPED (PER ASTM AND UL TUNNEL TEST METHOD). AY-IN ACOUSTICAL TILES TO MEET FLAME SPREAD 0-25 (ASTM E84) CLASS 'A' (FED. SPEC. SS-S118B) 25 OR UNDER (UL LABEL).	·	REF - INTERNATIONAL BUILDING CODE - NEW JERSEY EDITION	2015
ROVIDE WALL COVERINGS THAT BEAR THE UL LABEL, INDICATING THE FOLLOWING FIRE PERFORMANCE CHARACTERISTICS WHEN TESTED IN ACCORDAN	NCF		90
VITH ASTM E84: FLAME SPREAD, CLASS 1 (A) 0-25, SMOKE DEVELOPED NOT MORE THAN 450		LIGHT (LOW) HAZARD OCCUPANCY MINIMUM RATED SINGLE EXTINGUISHER	1
ALL CARPET TO MEET FLAMMABILITY REQUIREMENTS OF ASTM E648 (NFPA-253 RADIANT PANEL TEST (CLASS 11, 75 OR LESS). CLASS 1, 45 WATTS PER CM	CM2.	MAXIMUM FLOOR AREA PER UNIT OF A	
1UST PASS DOC-FE-I-70 PILL TEST. SMOKE DEVELOPMENT RATING SHALL BE LESS THAN 540 IN CONFORMANCE TO ASTM E84 GROUT MIXTURES SHALL CONFORM TO THE REQUIREMENTS OF CODES AS OUTLINED IN THE CODE REVIEW SECTION OF THE CONSTRUCTION DOCUMEN		MAXIMUM FLORR AREA FOR EXTINGUISHERb	1
HALL CONFORM TO ASTM C476.		MAXIMUM TRAVEL DISTANCE TO EXTINGUISHER	
IORTAR MIXTURES SHALL CONFORM TO THE REQUIREMENTS OF CODES AS OUTLINED IN THE CODE REVIEW SECTION OF THE CONSTRUCTION DOCUMEI ND SHALL CONFORM TO ASTM STANDARDS.	ENTS	b. ANNEX E.3.3 OF NFPA 10 PROVIDES MORE DETAILS CONCERNING APPLICATION OF THE MA c. TWO WATER-TYPE EXTINGUISHERS EACH WITH A 1-A RATING SHALL BE DEEMED THE EQUI EXTINGUISHER FOR LIGHT (LOW) HAZARD OCCUPANCIES	
HOP DRAWINGS REQUIRED; IF NOT RECEIVED, SUBSEQUENT CONTRACTOR WILL ASSUME TOTAL RESPONSIBILITY FOR ITEMS' SIZE, PROPER FIT, MATERIA ILL CODE COMPLIANCES.	IALS AND		
EN (10) WORKING DAYS ARE REQUIRED BY THE ARCHITECT FOR SHOP DRAWING REVIEW. TEN (10) WORKING DAYS ARE REQUIRED FOR ELECTRICAL, AECHANICAL, PLUMBING, ETC., ENGINEERING REVIEW.			
ATTENTION MILLWORKER, CONTRACTOR AND OR SUBSEQUENT CONTRACTORS: ANY PENETRATIONS INTO RATED WALL SYSTEMS FOR TELEPHONE, DATA IXTURES, JUNCTION BOXES, DUPLEX RECEPTACLES, FIRE ALARM SYSTEMS OR OTHER ROOM ACCESSORIES MUST HAVE A FIRE-RATED GYPSUM WALL BOA HAFT WALL ENCLOSURE PER ALL APPLICABLE CODES. THE RATING MUST CONTINUE AROUND AND BEHIND COMPLETE PENETRATION SO AS TO INSURE T NTEGRITY OF THE RATED ASSEMBLY. DRAWINGS AND SECTIONS OF TRIM AND MOULDING DETAILS ARE FOR DESIGN AND LAYOUT PURPOSES BASED ON ACTUAL TRIM AND BEST AVAILABLE	DARD OR		
NFORMATION. THEY ARE NOT INTENDED TO ACT OR TAKE PLACE OF WORKING SHOP DRAWINGS FROM A MILLWORK CONTRACTOR. THE CONTRACTOR SHALL BE RESPONSIBLE FOR RECORD KEEPING ALL EXPOSED CONDITIONS DISCOVERED DURING THE WORK AND ALL AS-BUILT CONDIT			
HE CONTRACTOR SHALL CHECK AND VERIFY THE EXISTING CONDITIONS AT THE SITE AGAINST THE DRAWINGS AND SPECIFICATIONS, AND INFORM THE			
F THE CONTRACTOR FINDS CONFLICTS BETWEEN THE DRAWINGS AND THE SPECIFICATIONS OR BETWEEN TRADES THE MORE STRINGENT WILL PREVAIL.	.		
GENERAL NOTES	151	CODE REVIEW	SCALE N.T.S.

2301BOARDWALK ATLANTIC CITY, NJ 08401 **RESTROOM RENOVATION**

THIS BUILDING IS LISTED IN THE NATIONAL REGISTER OF HISTORIC PLACES, AND ALL WORK MUST COMPLY WITH THE SECRETARY OF THE INTERIOR'S STANDARDS FOR THE TREATMENT OF HISTORIC PROPERTIES.

CLIENT	
Global Spectrum	
2301 Boardwalk	
Atlantic City, NJ 08401	
CRDA	
15 S Pennsylvania Avenue	
Atlantic City, NJ 08401	
Architect	
SOSH Architects	
1020 Atlantic Avenue	
Atlantic City, NJ 08401	
T: 609.345.5222	
Contact: Chris Menchin	
MEPFA Engineer	
Concord Atlantic Engineers	
2311 Atlantic Avenue	
Atlantic City, NJ 08401	
T: 609.246.7255	
Contact: Anthony Caucci	

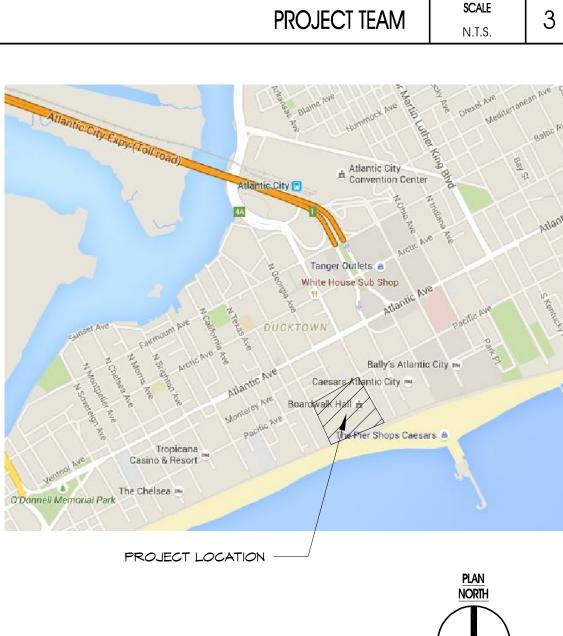

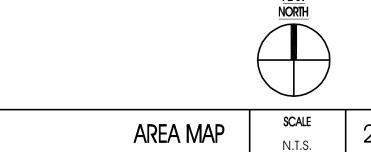







REVIEWED BY:

PROJECT NO. 15243.00.001


AC-000


[
KEY	DEMOLITION NOTES LEGEND	
	DESCRIPTION	
	REMOVE PORTION OF EXISTING WALL CONSTRUCTION; PATCH AND REPAIR FLOOR, CEILING, AND SURROUNDING WALL	
01	CONSTRUCTION AS REQUIRED REMOVE EXISTING DOOR AND FRAME; PATCH AND REPAIR	
02	FLOOR, CEILING, AND SURROUNDING WALL CONSTRUCTION AS REQUIRED	
. 024	REMOVE TRANSOM PANEL ABOVE DOOR & INFILL TO MATCH SURROUNDING CONSTRUCTION	
	NOT USED	
	REMOVE EXISTING PLUMBING FIXTURES, WATER LINES & SEWER	
	LINES TO BE RELOCATED AS NECESSARY FOR NEW FIXTURE INSTALL; ADDITIONAL FLOOR & WALL DEMOLITION MAY BE	
04	REQUIRED	
05	REMOVE EXISTING FLOOR FINISH & PREP FLOOR FOR NEW FINISH;SEE ALSO NOTE #3	
	REMOVE ALL EXISTING TOILET PARTITIONS & DOORS	
	REMOVE ALL EXISTING RESTROOM ACCESSORIES REMOVE EXISTING RADIANT HEATERS & COVERS; CAP PIPING	
	BELOW FLOOR & PATCH AS NEEDED REMOVE EXISTING GWB CEILING AND LIGHT FIXTURES	
	REMOVE EXISTING STONE SHELVES	
11	REMOVE EXISTING CEILING IN ITS ENTIRETY REMOVE EXISTING CEILING FIXTURES; REFER TO MEP FOR MORE	
12	INFO	
13	REMOVE EXISTING EXPOSED SPRINKLER LINES; REFER TO FIRE PROTECTION FOR MORE INFO	
14	REMOVE EXISTING HEADER EXISTING JANITOR CLOSET DOORS TO REMAIN; REPLACE GRILL IN	
15	DOOR WITH SIMILAR	
15A	RELOCATE EXISTING DOOR & FRAME; SEE DOOR SCHEDULE FOR MORE INFO	
	RELOCATE EXPOSED SPRINKLER PIPE	
17	STRIP PAINT FROM EXISTING WINDOWS & PREP FOR NEW FINISH	
	DEMOLITION NOTES	
#1	EXISTING JANITORS CLOSETS TO REMAIN; DOORS TO BE SANDED & PAINTED; CLEAN &/OR REPAIR EXISTING DOOR HARDWARE	
#2	REFER TO MEP DRAWINGS FOR ADDITIONAL INFORMATION FILL CRACKS IN EXISTING CONCRETE SLAB PRIOR TO APPLICATION	
#3	OF PROPOSED FLOOR FINISHES DOOR AND FRAMES NOTED TO BE REMOVED SHALL BE	
#4	RETURNED TO OWNER	
#5	REMOVE & REPLACE ALL EXHAUST GRILLS, TYP FOR ALL RESTROOMS; SEE MEP DRAWINGS	
	DEMOLITION LEGEND SCALE 3	

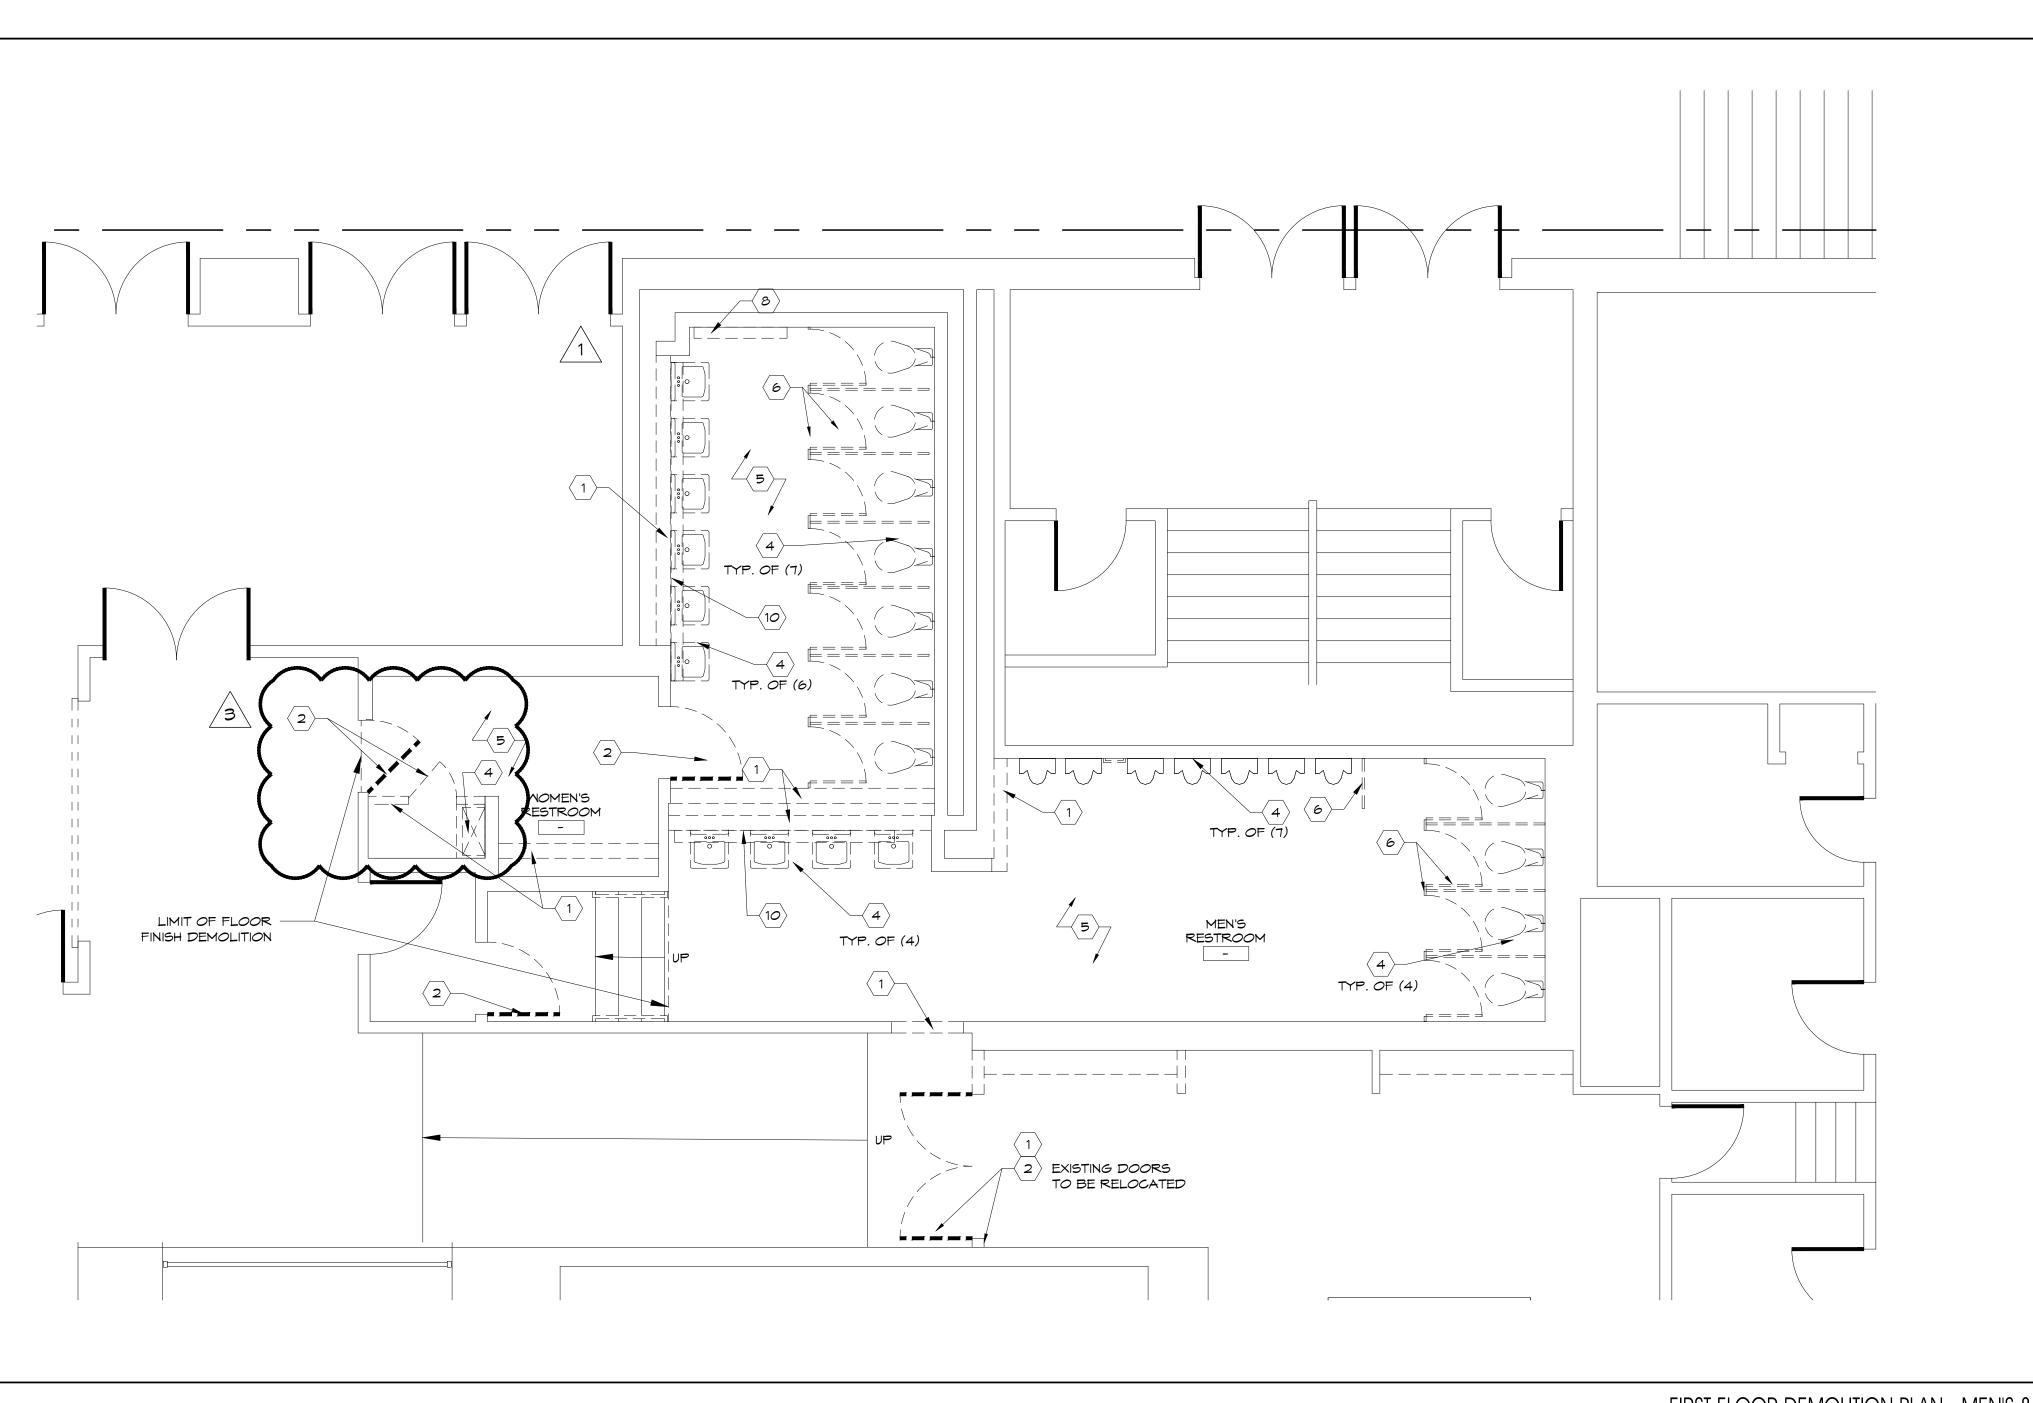


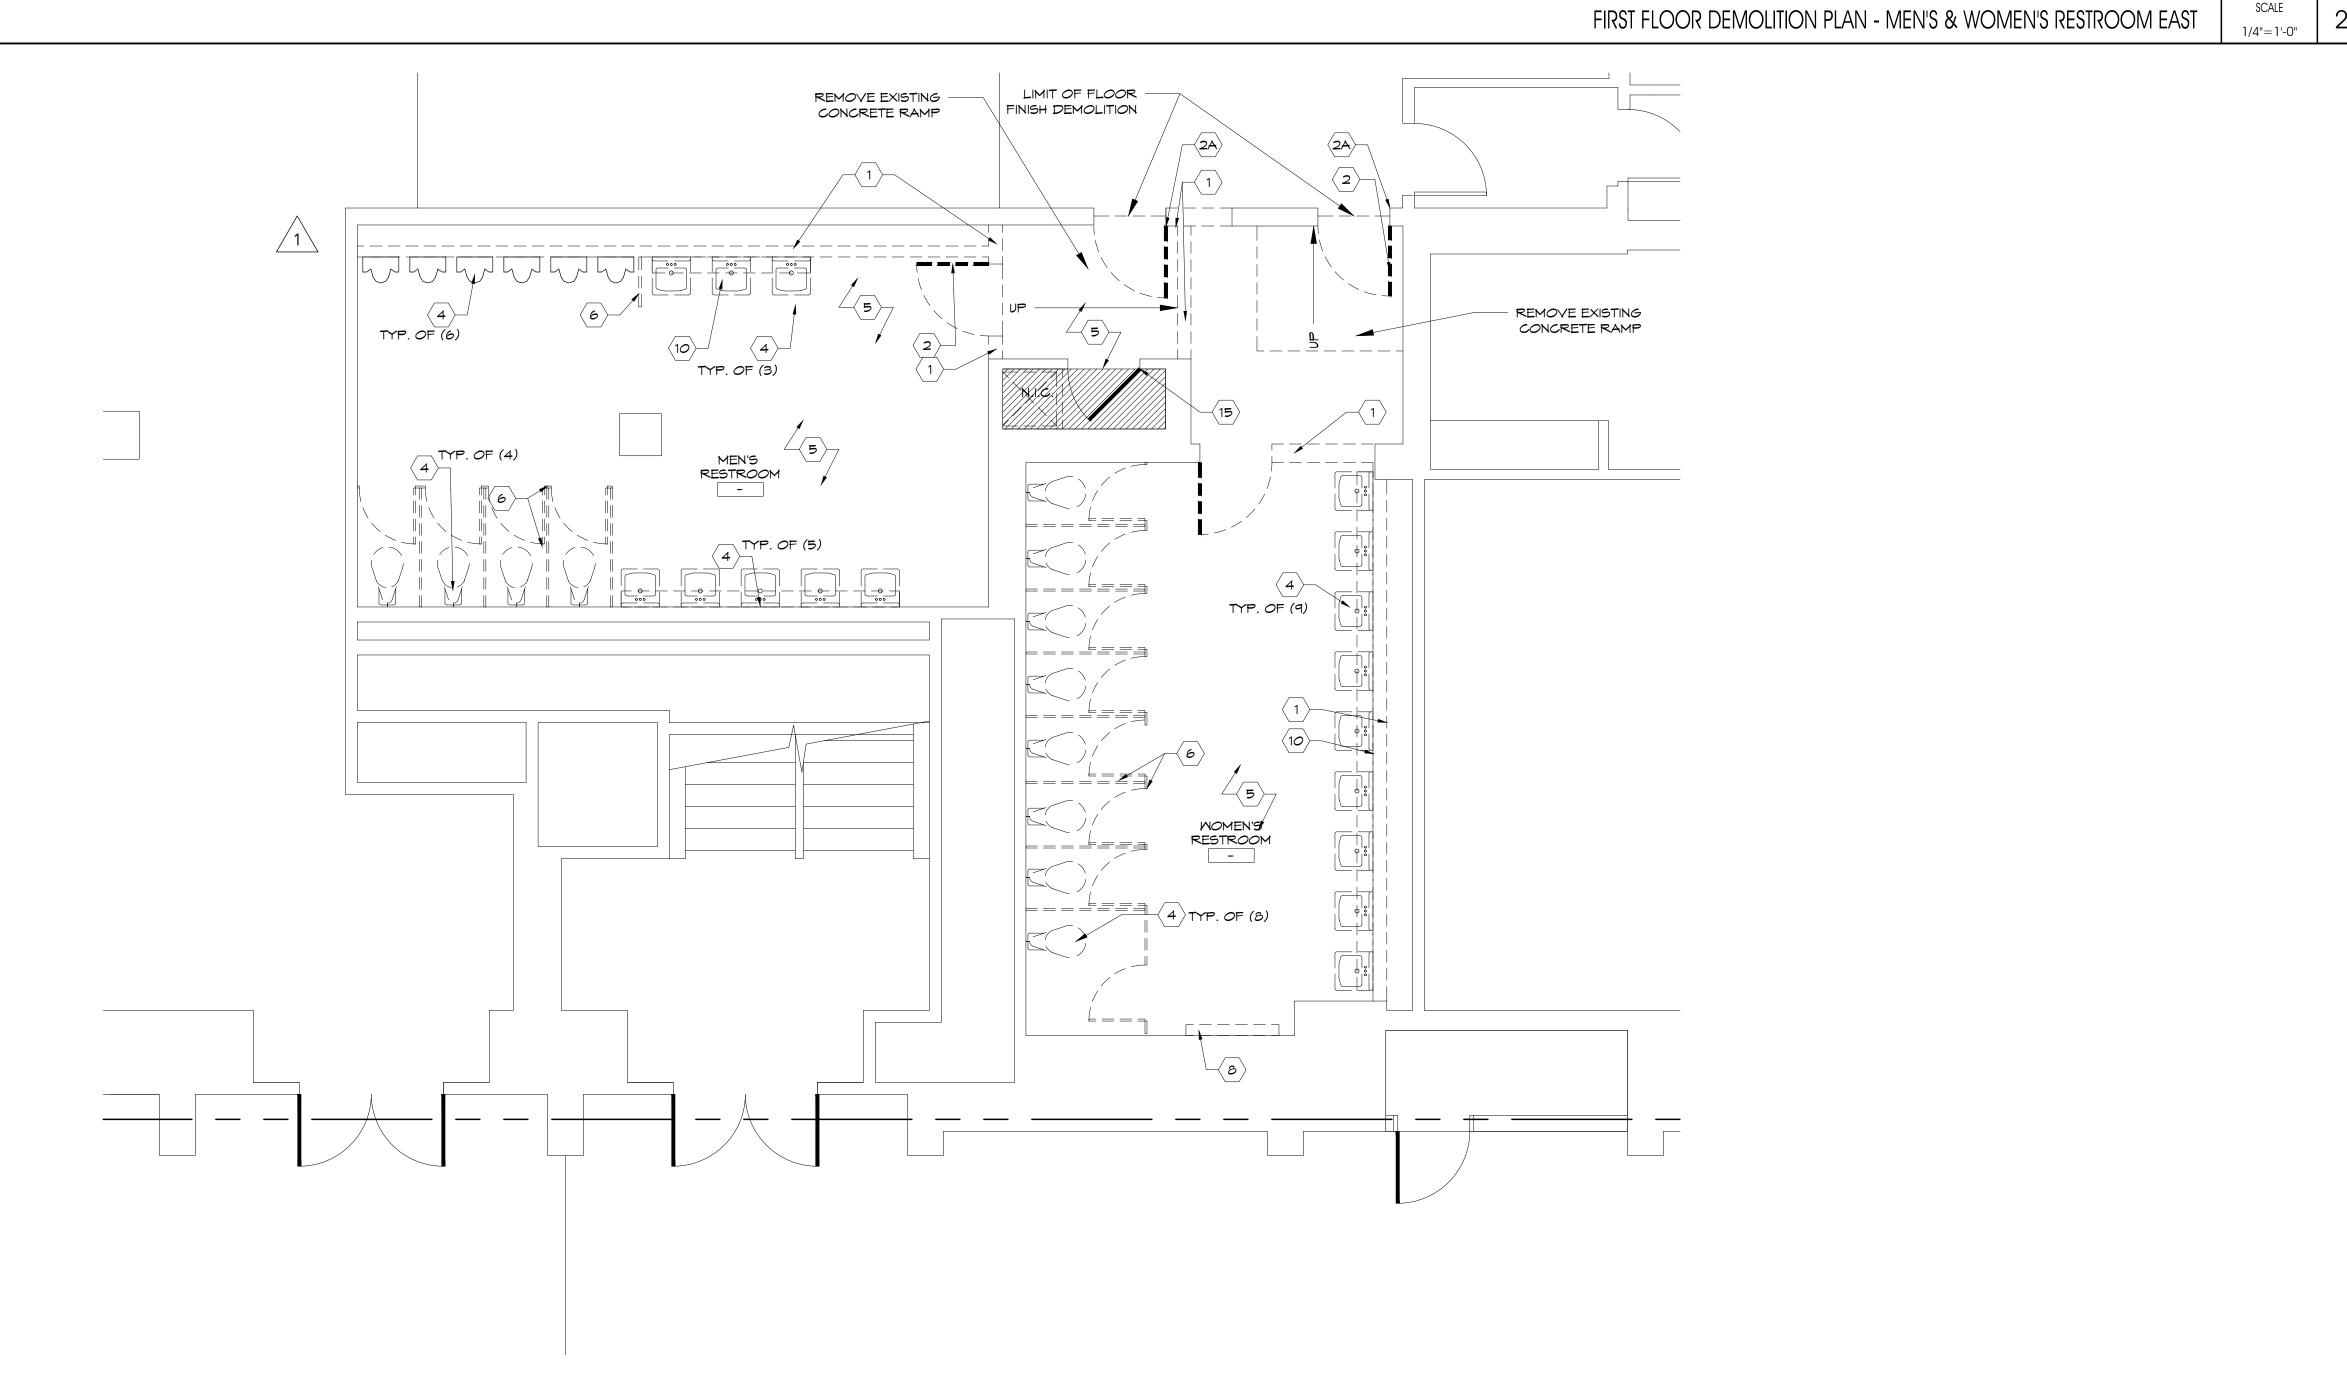




 

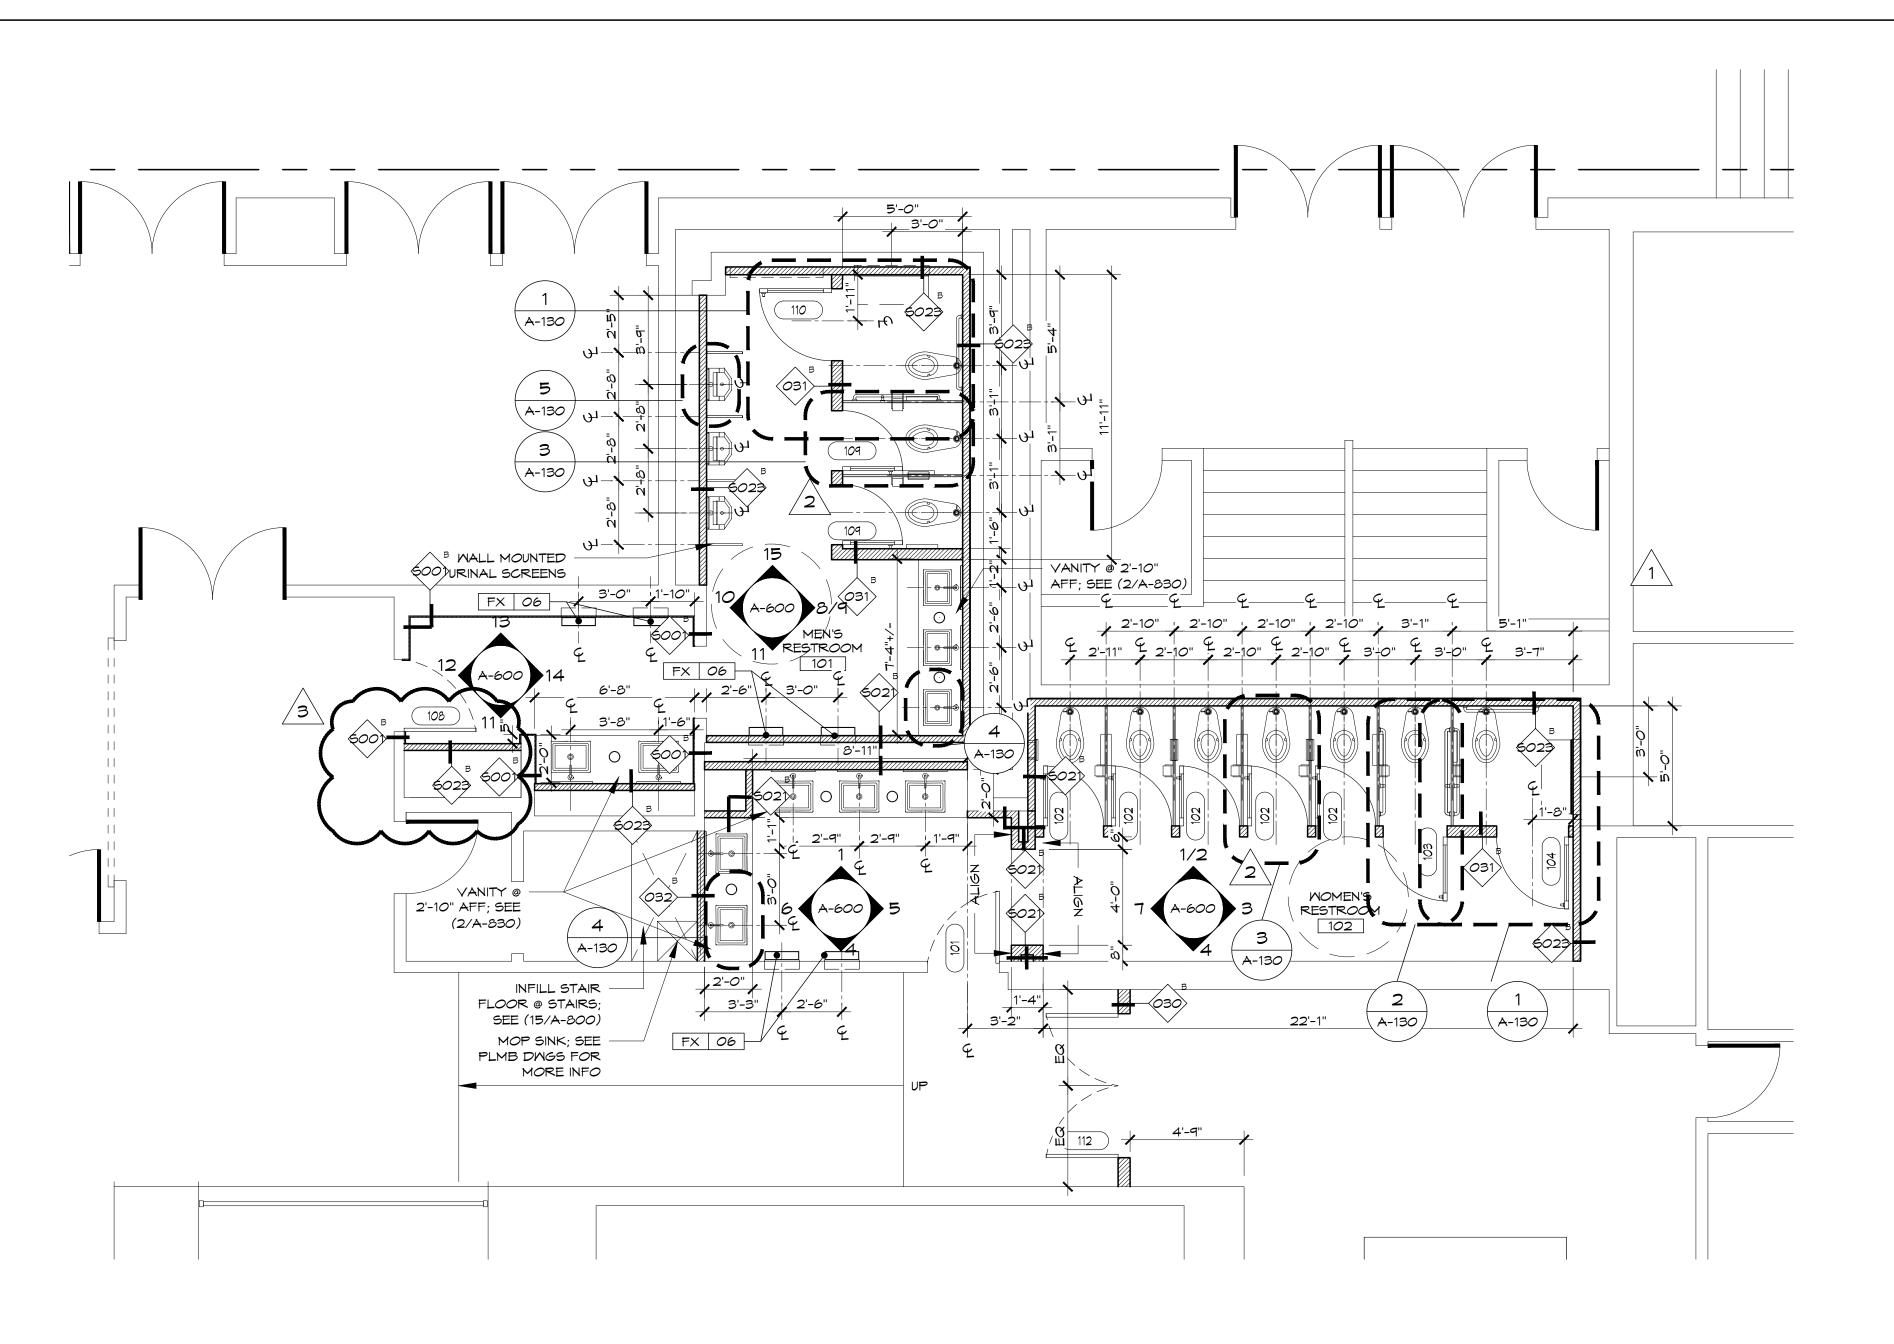

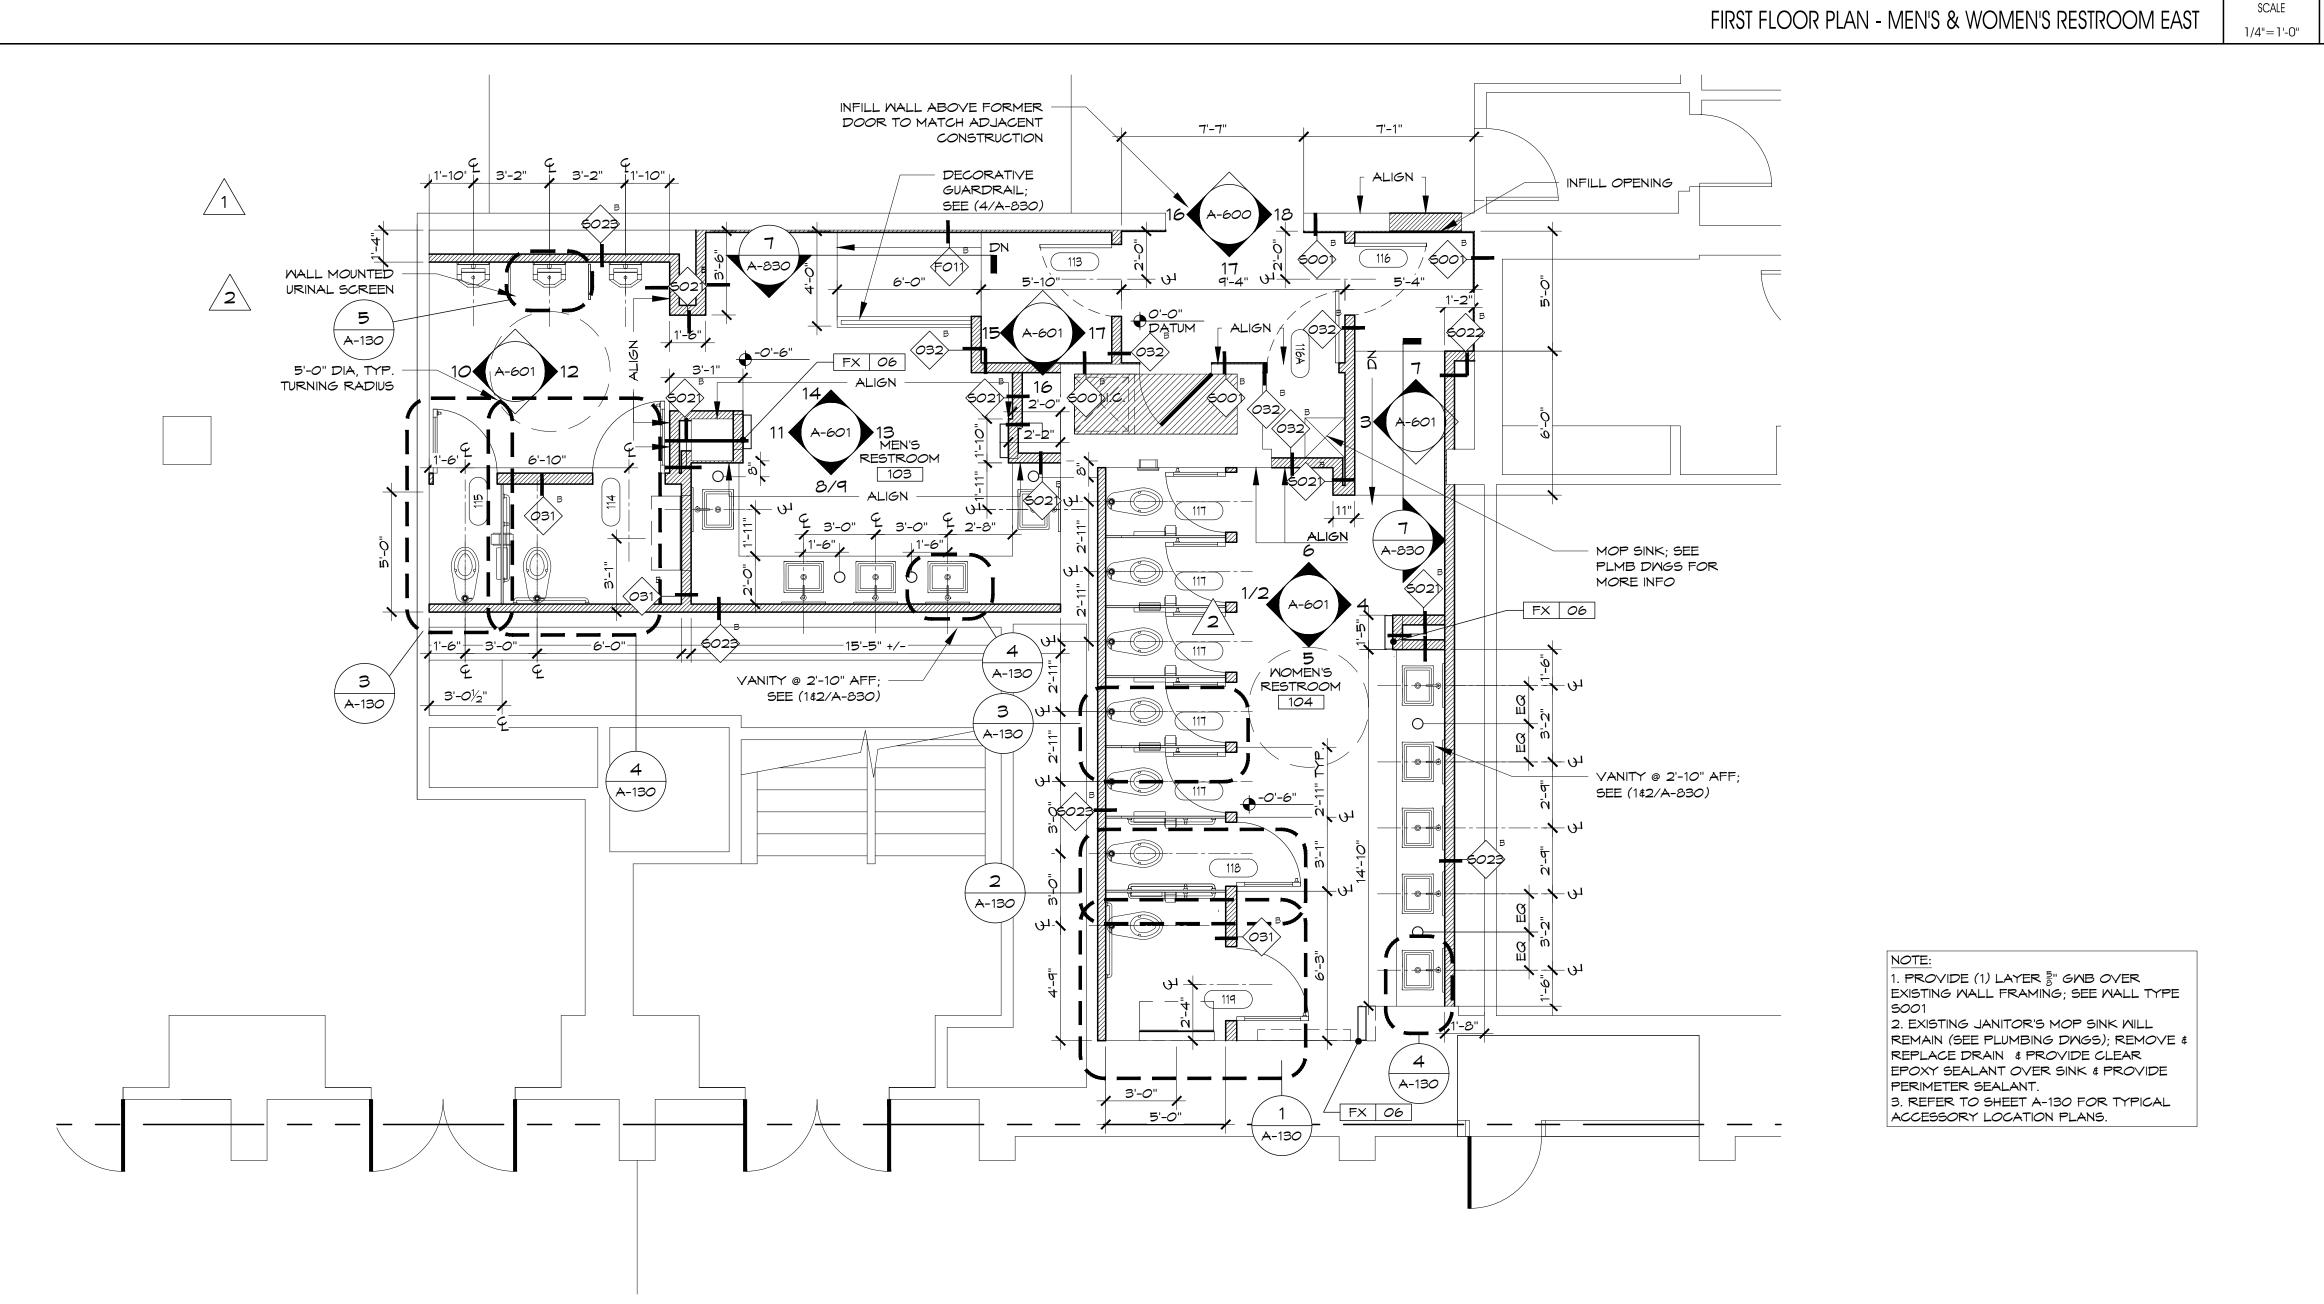



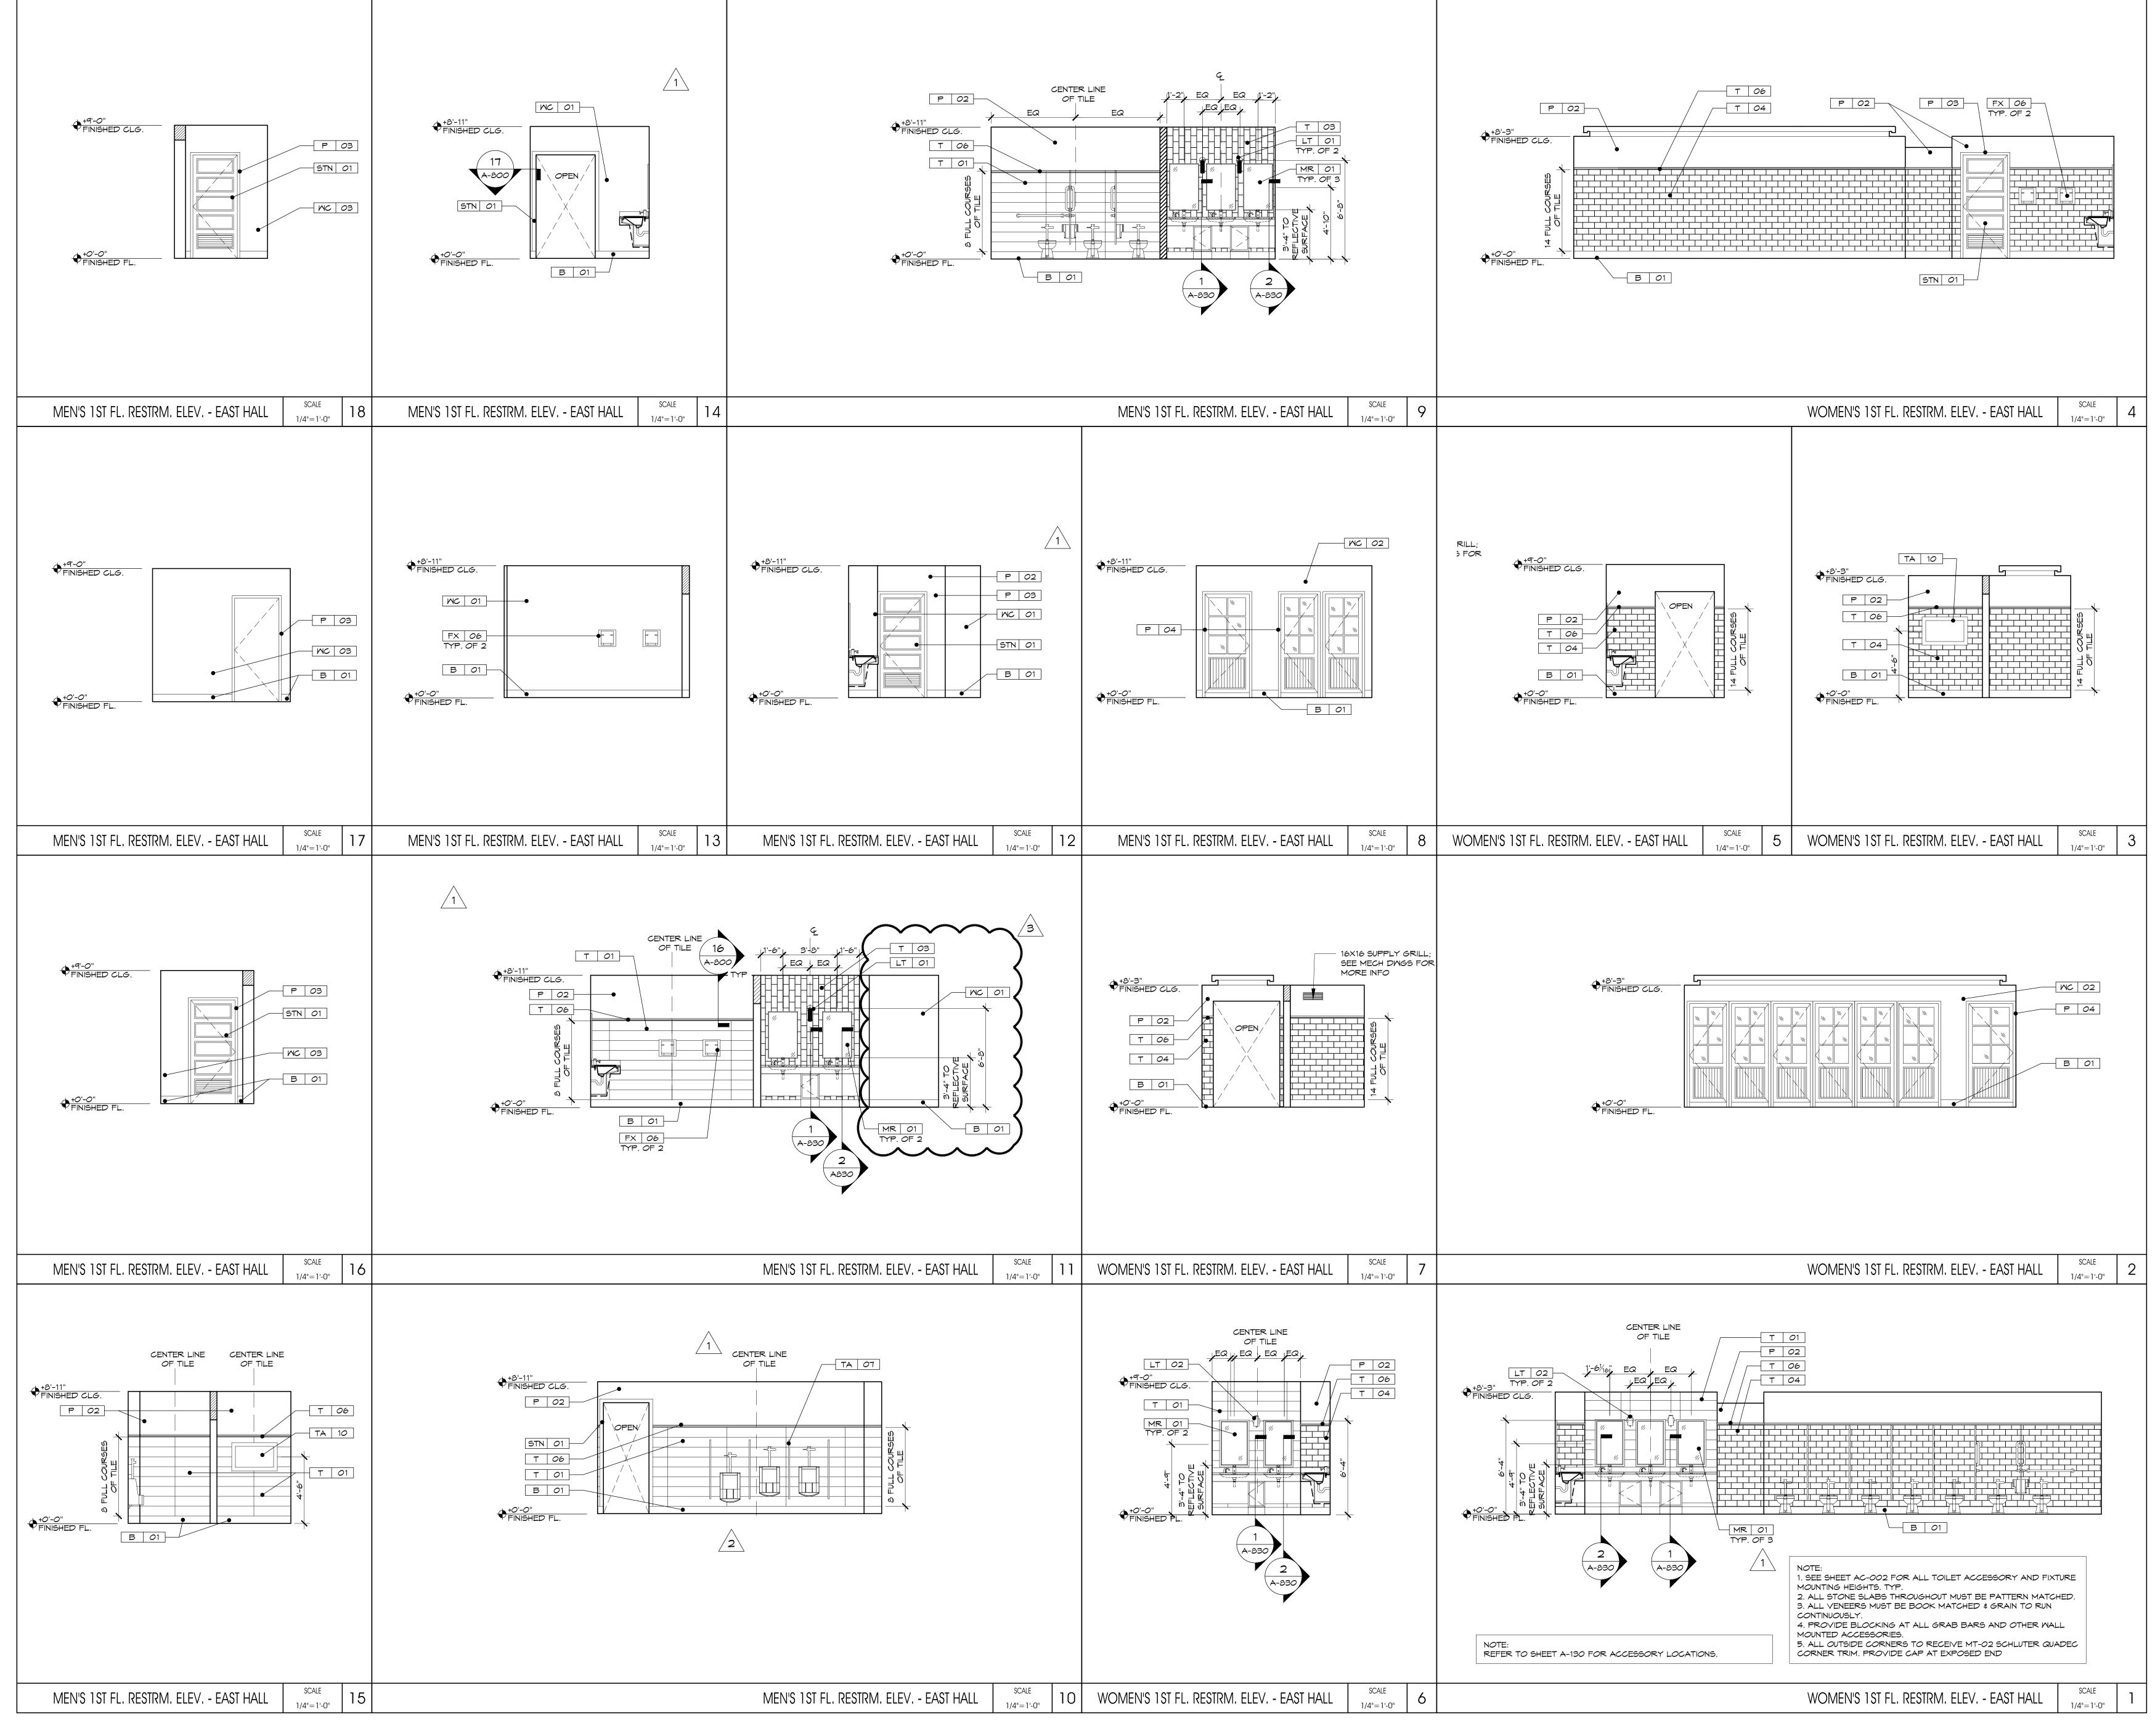

SOSH
atlantic city new york 1020 Atlantic Avenue 145 West 57th Street Atlantic City, NJ 08401 New York, NY 10019 T: 609.345.5222 T: 212.246.2770 F: 609.345.7486 F: 212.246.2770
www.sosharch.com Thomas J. Sykes, A.I.A., P.P. Founding Principal William A. Salerno, A.I.A., P.P.
Founding Principal Nory Hazaveh, A.I.A., P.P. Founding Principal Mark Petrella, A.I.A. Principal
Christopher M. Menchin, NCARB Principal Kimberly McCarron, NCARB Principal
www.sosharch.com
Sourcevalk Hall Your BEST SEAT AT THE SHOWE
AC BOARDWALK HALL RESTROOM RENOVATION
2301 BOARDWALK, ATLANTIC CITY, NJ 08401
SUBMISSIONS
I I 3 I 2 I 2 I 2 I
1 + 2016.11.30 + ADDENDUM #2 1 10-14-2016 + CONSTRUCTION DOCUMENTS
NO. DATE: DESCRIPTION: DRAWING TITLE:
INTERIOR ELEVATIONS WOMEN & MEN'S 1ST FLOOR RESTROOMS - EAST HALL
DRAWN BY: SB DRAWING NO.
REVIEWED BY: CM PROJECT NO. 15243,00,001 A-600