

TO: Bid Responders

FROM: Clark Hughes

DATE: March 16, 2026

**SUBJECT: JWBWH LOBBY AUDIO VIDEO MODIFICATION – ADDENDUM #2**

1. Q -Can the bidders provide approved equal substitutions for Neoti or Samsung screens?

**A- Please refer to Addendum 1**

2. On Page 11 of the pdf RFP (page 10 of actual RFP) at the bottom it states: “The bidder and subcontractors must be properly registered with the Department of Labor and Workforce Development under the Public Works Contractor Registration Act, N.J.S.A. 34:11-56.48 et seq., as of the bid opening date, and must submit a copy of the bidder’s Public Works Contractor Registration Act certificate with its bid.” We are an AV company who plans to bid as a subcontractor under a GC. The union labor house we plan to use does have this qualification, however, we do not. Is this required from us as the AV integrator?

**A - The Union Labor House is required to satisfy.**

3. On Page 1 of the RFP it states: “5. Section: 1.0, 1.18, d - Must provide documentation The bidder must participate in an apprenticeship program, registered and approved by the United States Department of Labor, for each separate trade or classification for which it employs craft employees. All bidders and subcontractors must continue to participate in such apprenticeship programs for the duration of the project. In addition, the bidder will be required to show that such apprenticeship programs graduated apprentices to journeyman status for three of the past five years.” We are an AV company who plans to bid as a subcontractor under a GC. The union labor house we plan to use does have this qualification, however, we do not. Is this required from us as the AV integrator?

**A - The Union Labor House is required to satisfy.**

4. Q -Has it been determined if you want an LED wall or 3x3 LCD wall for replacing the Mosaic Wall? If not, do you prefer the LCD or LED as the product in the main bid and which as the option?

**A- Please provide the 3X3 LCD Samsung VM46B-U video wall As Specified.**

5. For the Experience center can you verify this is a 75” LCD?

**A - The experience center shall receive the 3X3 46" Samsung LCD wall As Specified.**

6. The AC Womans Hall of Fame the same thing as the Experience Center?

**A- No. They are two different locations with two different displays**

7. We are assuming there are 4 column LED's, 1 75" display and one 3x3 of 46" displays (or an LED wall).

A - Correct

8. Can we use the existing CAT cables from the rack to the columns and pull new as needed?

A - No, new cables shall be pulled for these locations.

9. Can you confirm there are no audio system changes?

A - The audio system will not be changed.

10. If programming code changes are needed for Crestron or Q-SYS are you able to provide the existing uncompiled code?

A – The Client will work with the successful bidder on this item

11. Is there a scissor lift on site we can utilize?

A – Bidder must provide all tools and equipment to complete the scope of work

12. On drawing A-402, the Mosaic wall is shown as being replaced with a Uniview UHD2 5x5 video wall. However, DWG AV-702 and DWG AV-901 indicate the Mosaic wall is being replaced with a 3x3 Samsung LCD video wall using SAMSUNG VM46B – 46" panels. Please confirm whether the Mosaic wall is to be replaced with an LED video wall solution or a standard LCD video wall.

A – Please refer to answer to question 4

13. Would you consider an LED alternative to the LCD?

A. .Please refer to Addendum 1

14. Based on our significant experience installing and supporting LED systems nationwide, would the project team consider an alternate LED manufacturer that meets or exceeds specifications

15. A – Please refer to Addendum 1

#### **DRAWING CLARIFICATIONS**


1. Drawing clarification No. 1

See the attached which is made part of the plans and specification via Addendum 2

#### **END OF QUESTIONS AND ANSWERS**

Cc: Jim McDonald  
Nicole Hagaman


ATTN: Plans and Specification

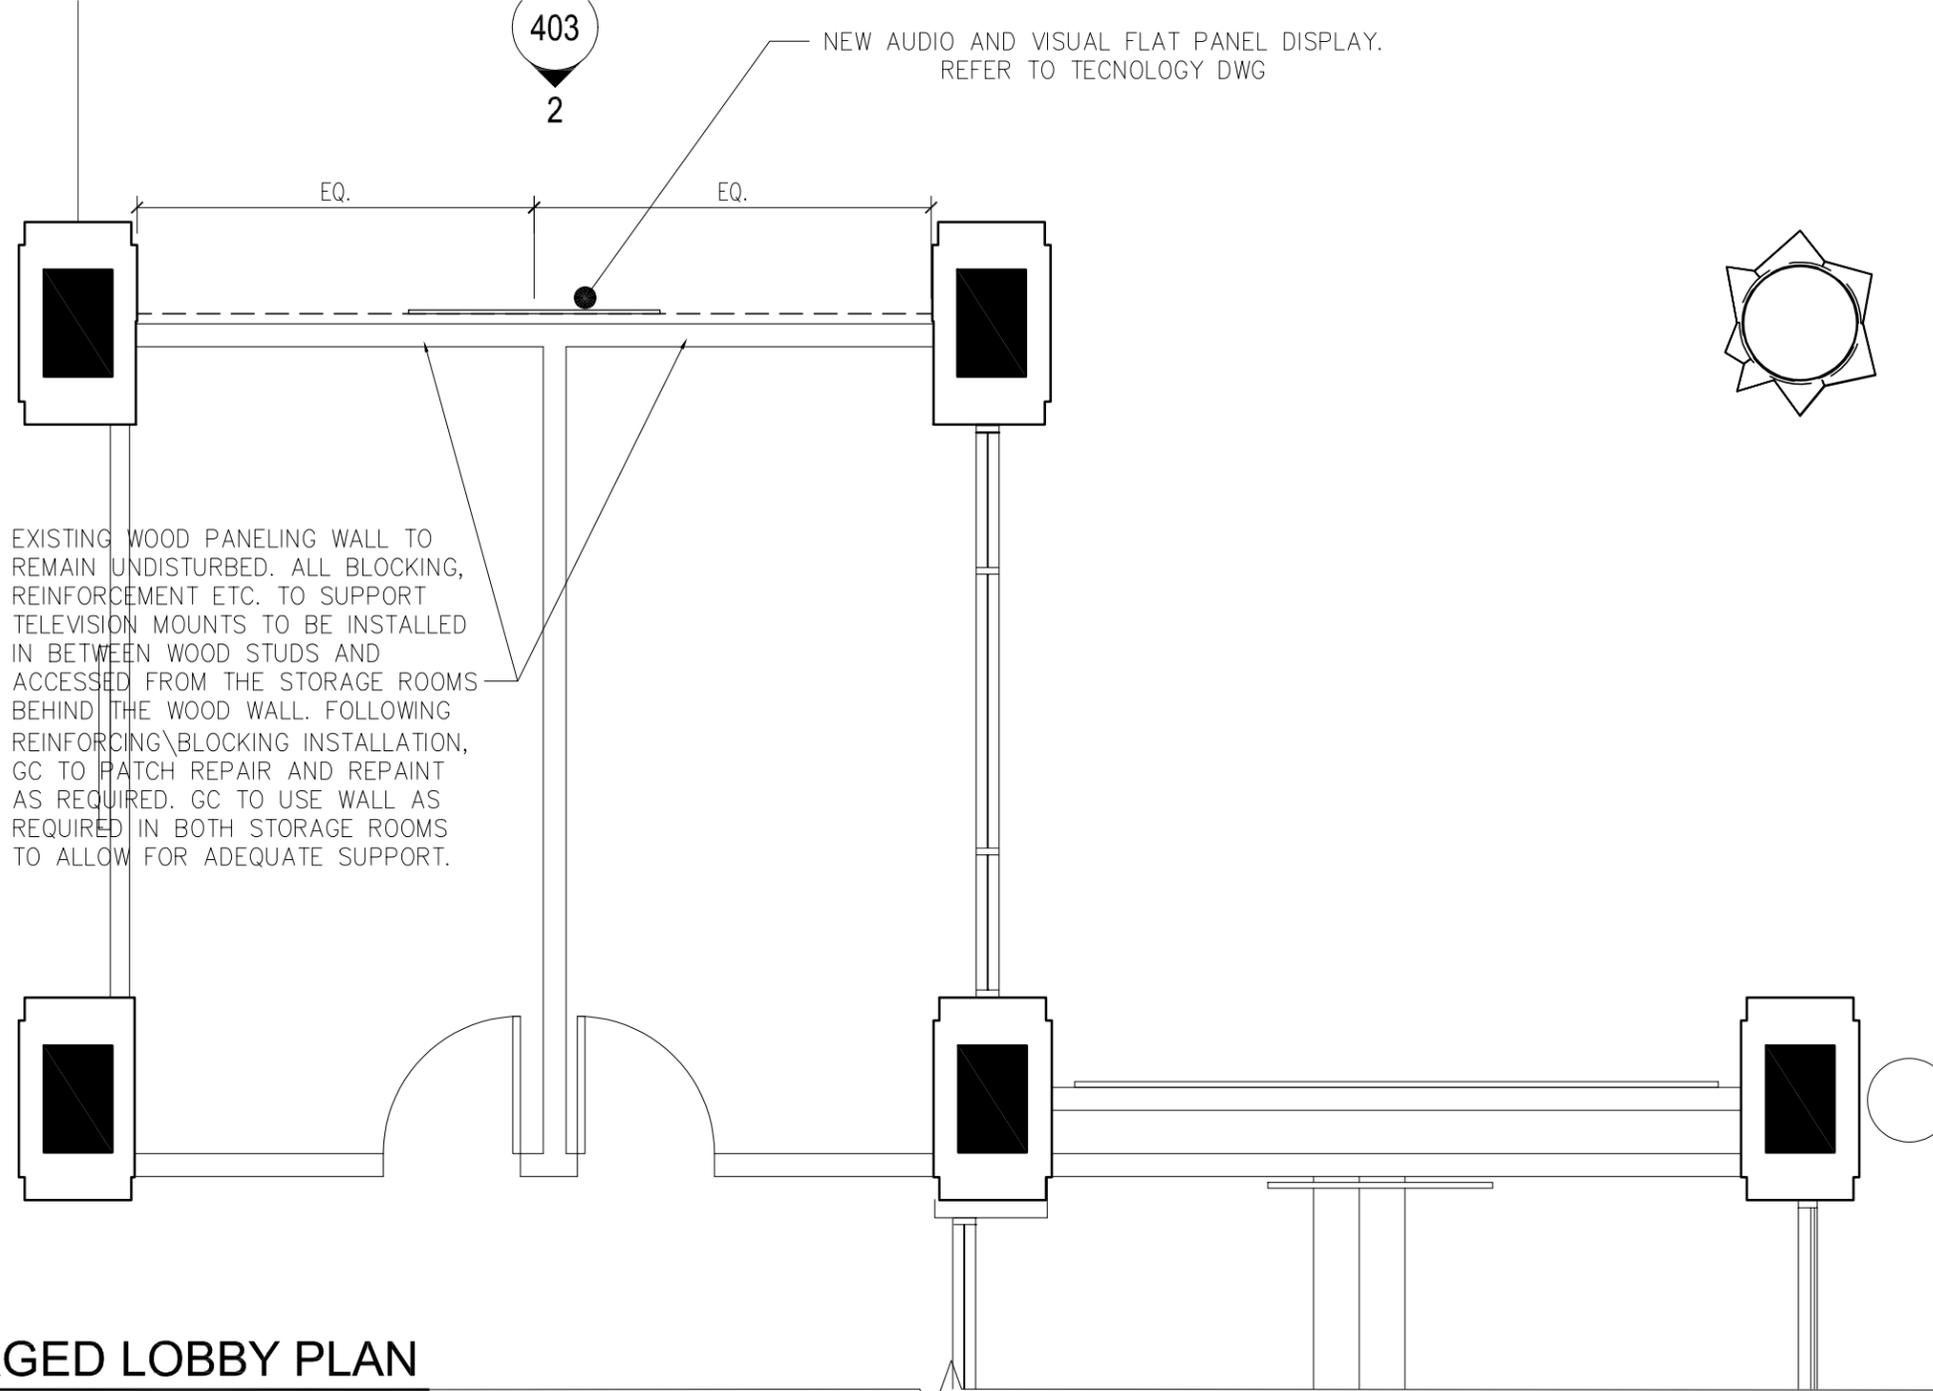

**1** ENLARGED LOBBY PLAN  
A-403 SCALE: 1/4" = 1' - 0"

 <b>NETTAARCHITECTS</b> 1084 Route 22 West Mountainside, NJ 07092 Phone: 973.379.0006 www.nettaarchitects.com CERTIFICATE OF AUTHORIZATION AC-438	Date:	03.13.2026	Project Name: <b>JWBH LOBBY AV UPGRADE PROJECT</b>	
	Scale:	AS SHOWN		
	Drawn by:	BDR	Sheet Contents: <b>BLOCKING &amp; REINFRORCING NOTES</b>	Drawing No.:
	Checked by:	BDR		
	Job No.:	225038	Drawing Reference: <b>A-403</b>	<b>SK-001</b>
	Sheet:	1 OF 2		

EXISTING FINISH\_CLG.  
EL. 15'-2"

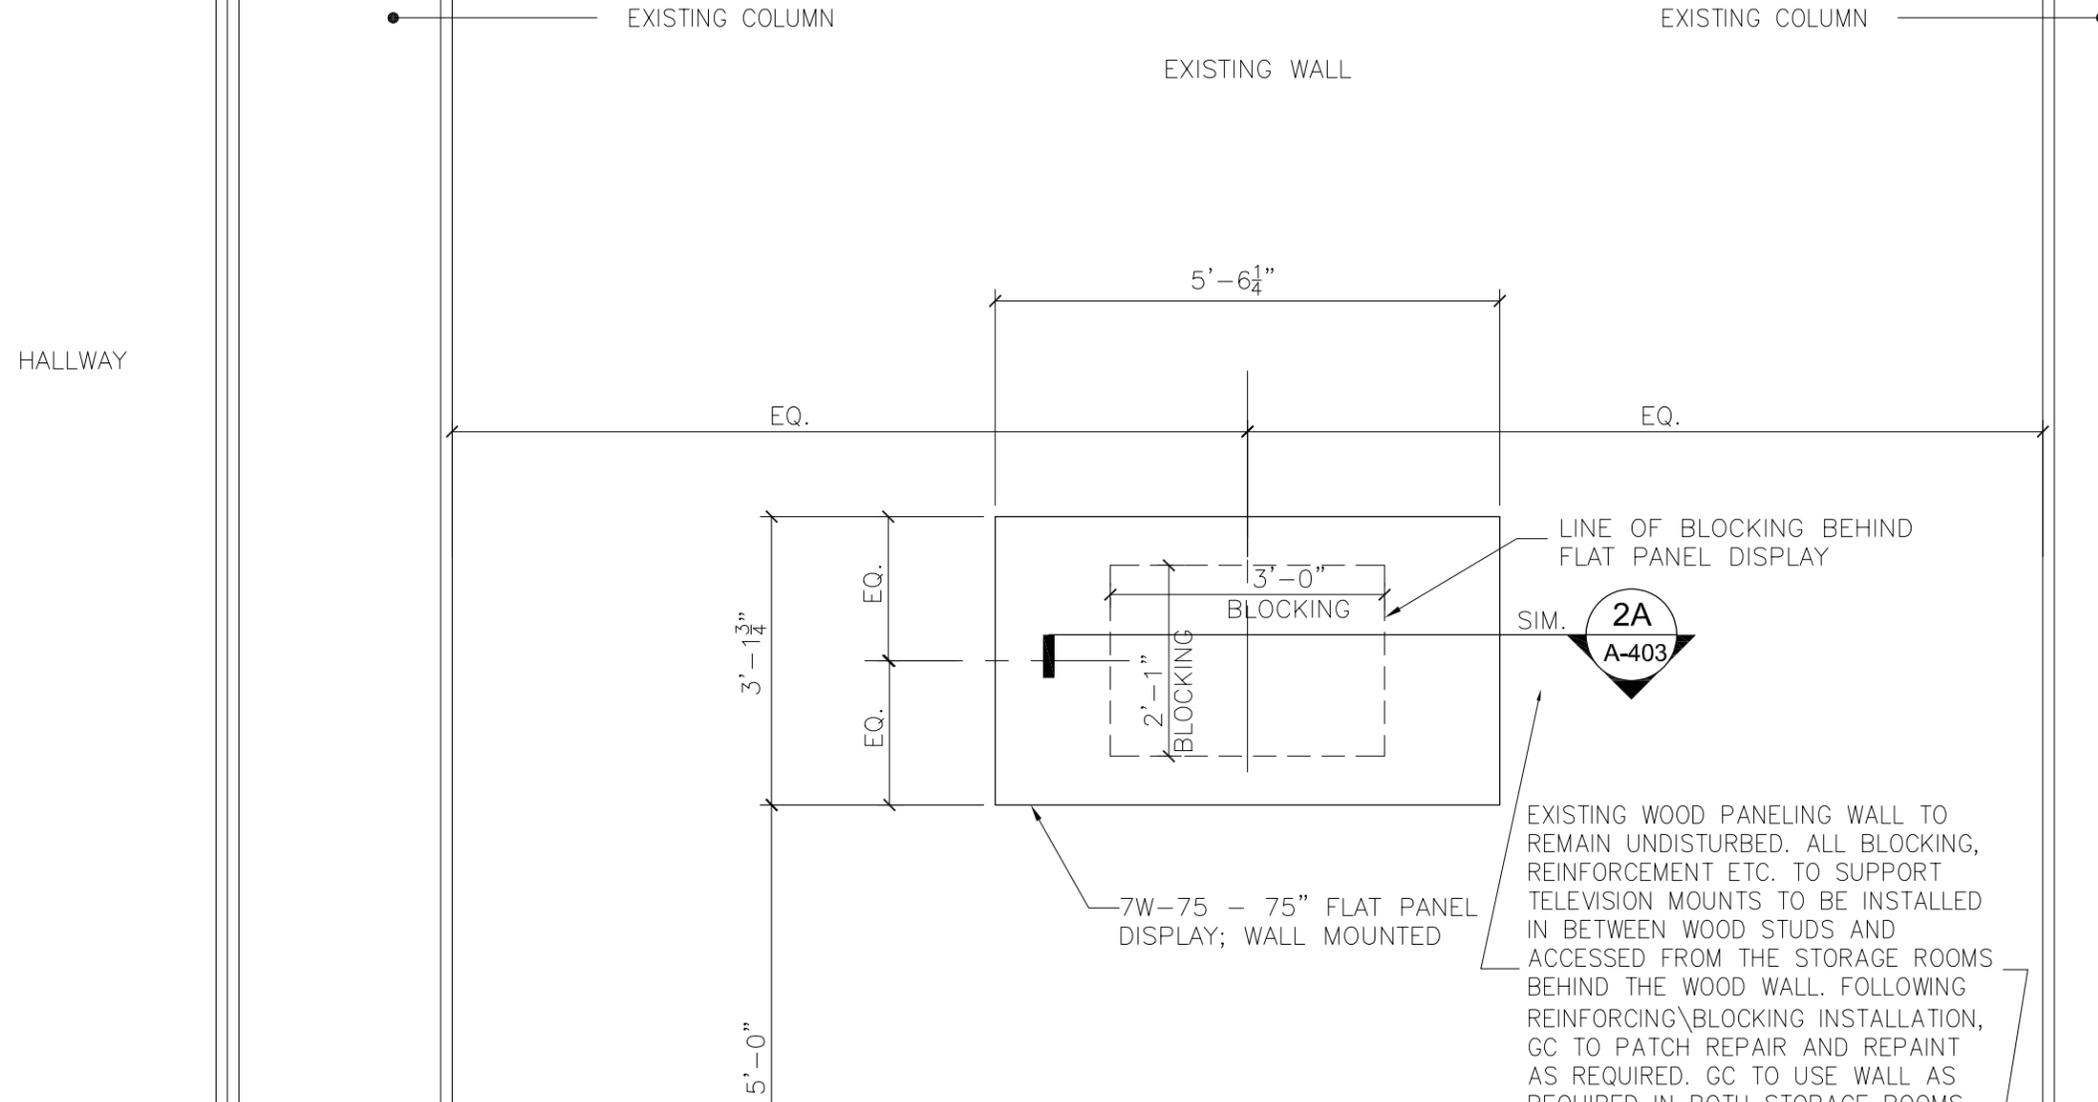

LINE OF BLOCKING BEHIND  
FLAT PANEL DISPLAY

3'-0"  
BLOCKING

2'-1"  
BLOCKING

7W-75 - 75" FLAT PANEL  
DISPLAY; WALL MOUNTED

EXISTING WOOD PANELING WALL TO  
REMAIN UNDISTURBED. ALL BLOCKING,  
REINFORCEMENT ETC. TO SUPPORT  
TELEVISION MOUNTS TO BE INSTALLED  
IN BETWEEN WOOD STUDS AND  
ACCESSED FROM THE STORAGE ROOMS  
BEHIND THE WOOD WALL. FOLLOWING  
REINFORCING\BLOCKING INSTALLATION,  
GC TO PATCH REPAIR AND REPAINT  
AS REQUIRED. GC TO USE WALL AS  
REQUIRED IN BOTH STORAGE ROOMS  
TO ALLOW FOR ADEQUATE SUPPORT.

**2**  
A-403

**ELEVATION VIDEO WALL AT MUSEUM DISPLAY**

SCALE: 1/2" = 1' - 0"

EXISTING FINISH\_FLOOR  
EL. 0'-0"

 <p><b>NETTAARCHITECTS</b></p> <p>1084 Route 22 West Mountainside, NJ 07092 Phone: 973.379.0006 www.nettaarchitects.com CERTIFICATE OF AUTHORIZATION AC-438</p> <p>237 West 35th Street Suite 1004 New York, NY 10004 Phone: 212.777.2090</p>	Date:	03.13.2026	Project Name: <b>JWBH LOBBY AV UPGRADE PROJECT</b>	
	Scale:	AS SHOWN		
	Drawn by:	BDR	Sheet Contents: <b>BLOCKING &amp; REINFRORCING NOTES</b>	Drawing No.:
	Checked by:	BDR		
	Job No.:	225038	Drawing Reference: <b>A-403</b>	<b>SK-00 2</b>
	Sheet:	2 OF 2		

NOTE: